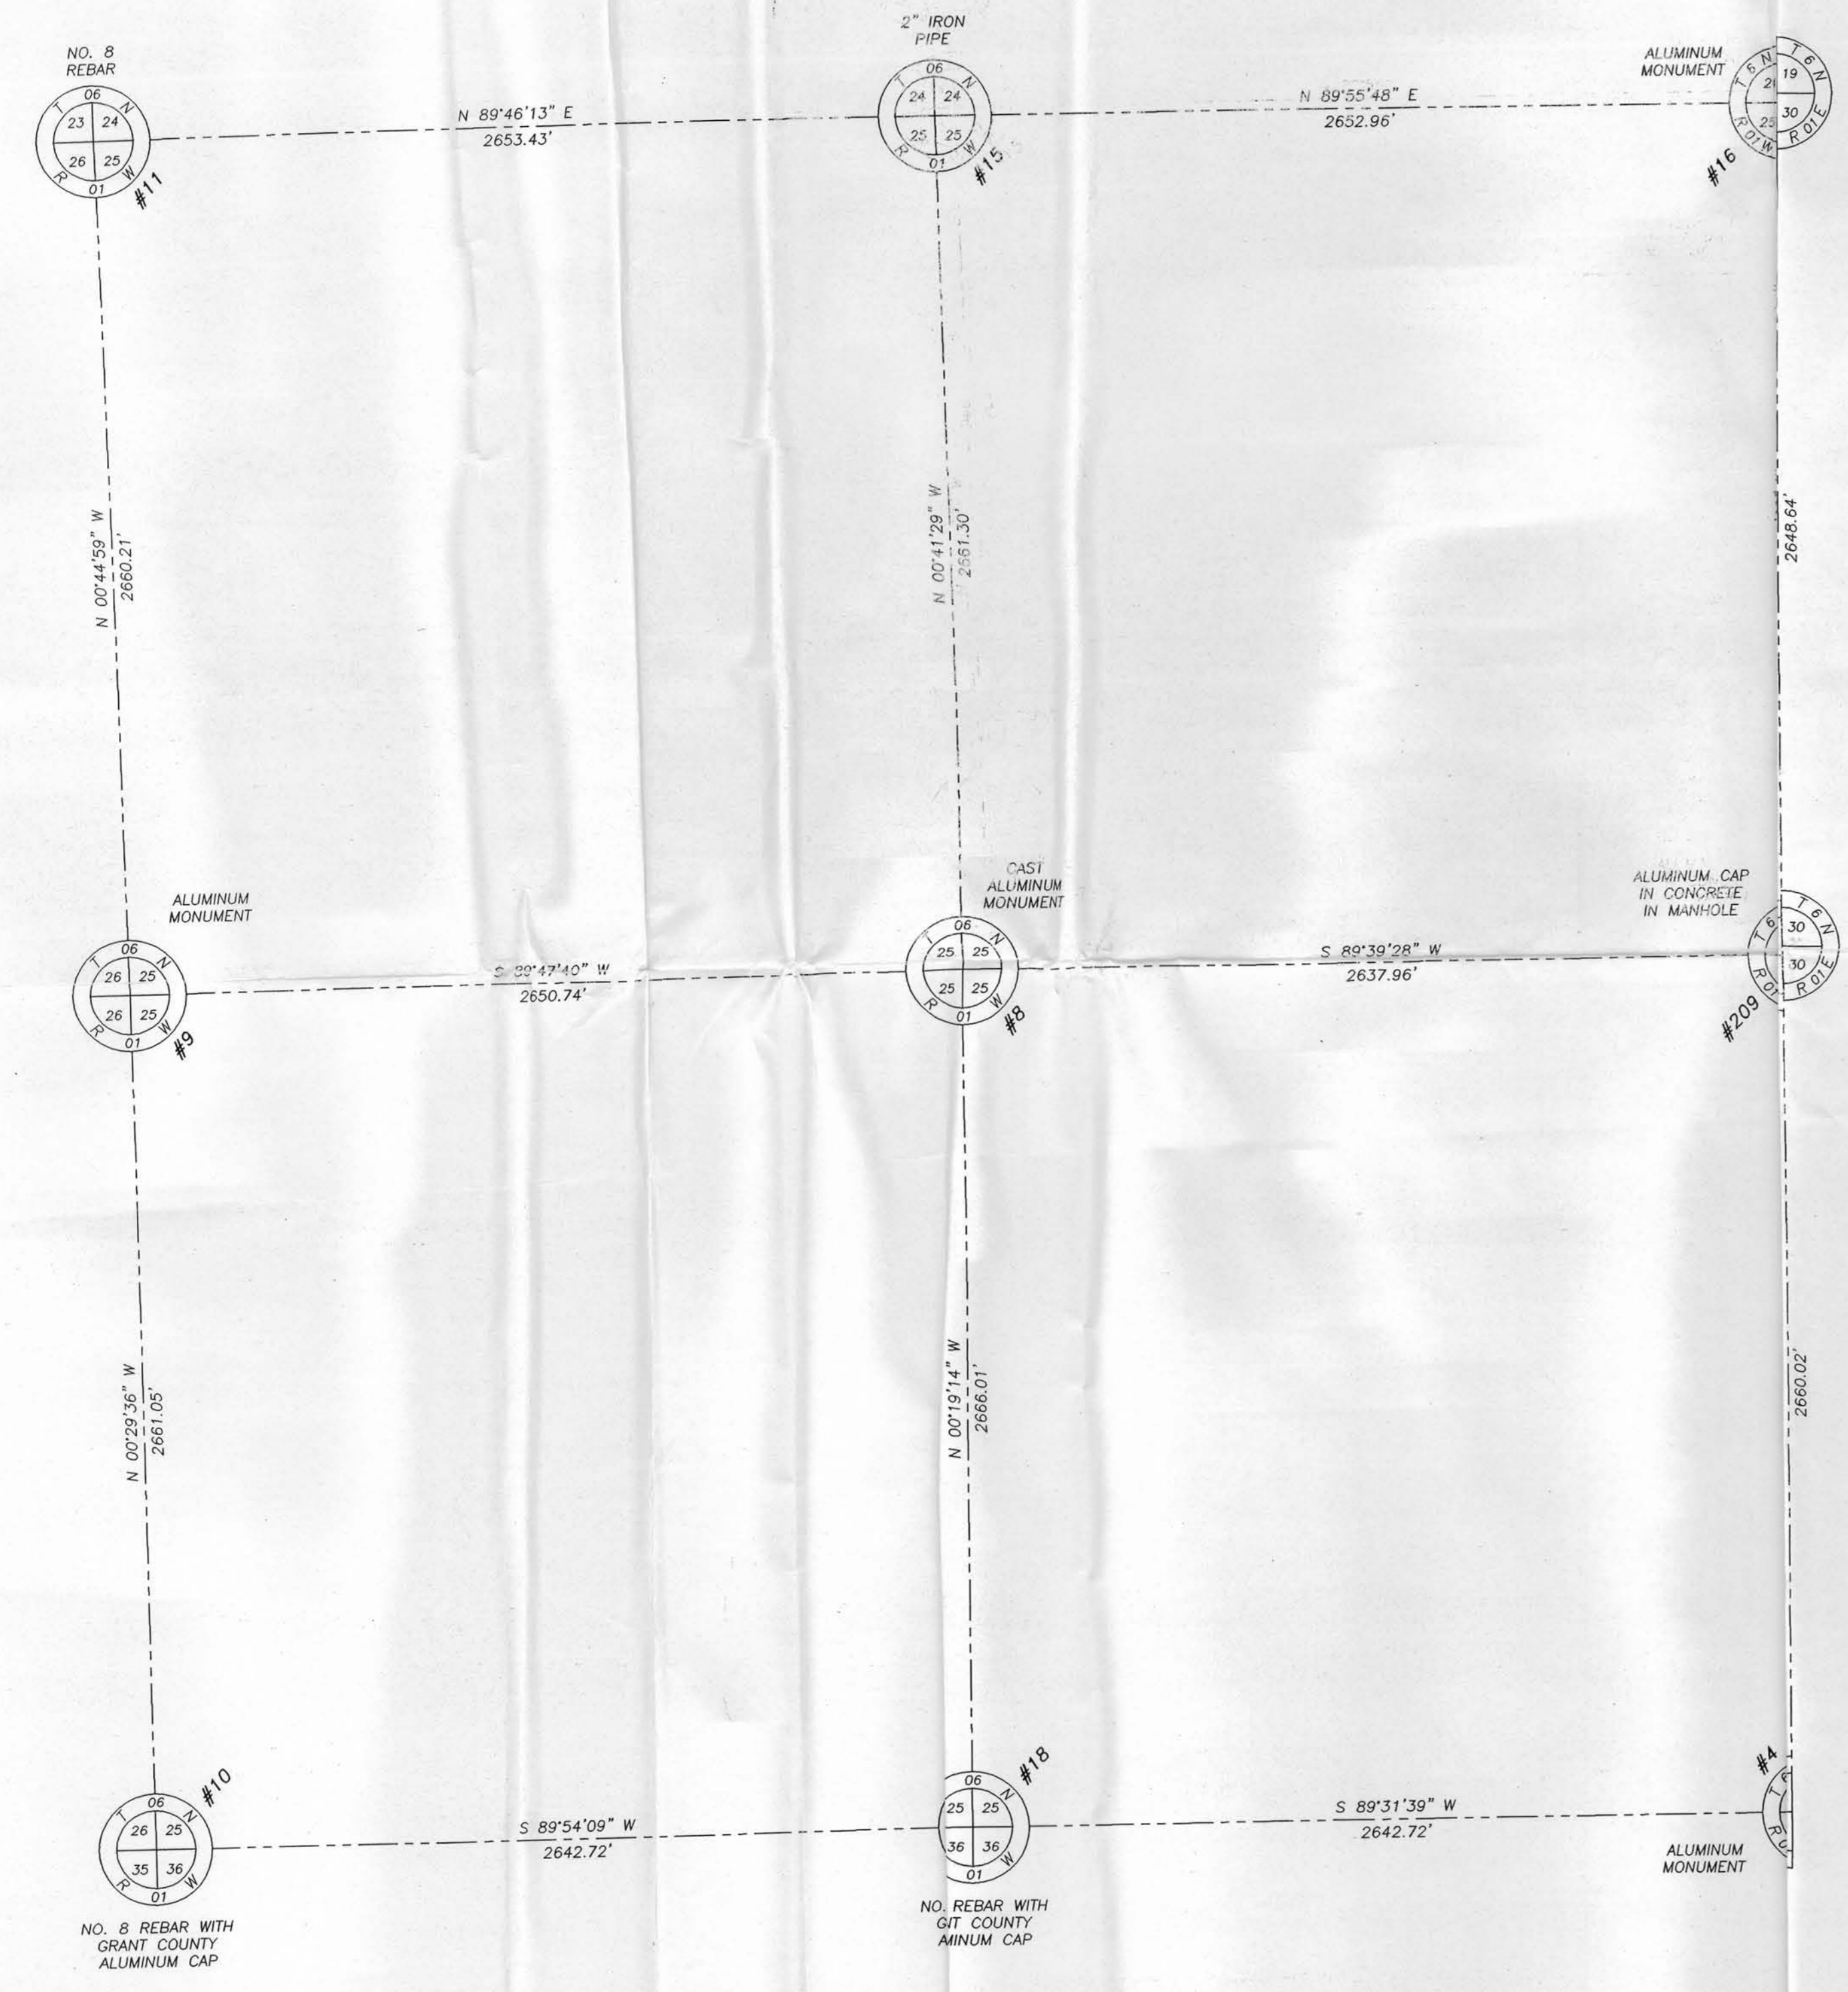


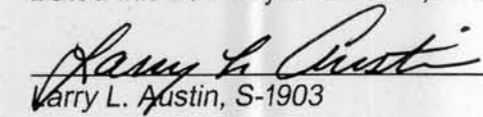
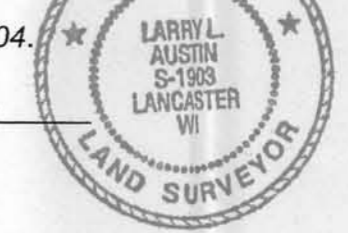
# SECTION CORNER SUMMARY

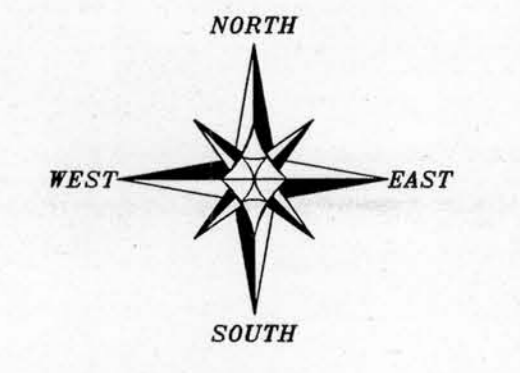
SECTION 25, T6N R1W, WINGVILLE TOWNSHIP, GRANT COUNTY, WISCONSIN  
 PREPARED FOR: WISCONSIN DEPARTMENT OF TRANSPORTATION  
 PROJECT ID: 1660-04-00  
 U.S.H. 18, MONTFORT - DODGEVILLE ROAD  
 GRANT COUNTY, WISCONSIN



POINT	DESCRIPTION	NORTHING	EASTING
11	NW COR, SEC 25, T6NR1W	569530.08	889125.60
15	N 1/4 COR, SEC 25, T6NR1W	569540.72	891779.01
16	NE COR, SEC 25, T6NR1W	569543.96	894431.97
209	E 1/4, SEC 25, T6NR1W	566895.37	894449.03
8	CENTER, SEC 25, T6NR1W	566879.61	891811.12
9	W 1/4 COR, SEC 25, T6NR1W	566870.10	889160.40
10	SW COR, SEC 25, T6NR1W	564209.14	889183.32
18	S 1/4 COR, SEC 25, T6NR1W	564213.64	801826.04
4	SE COR, SEC 25, T6NR1W	564235.43	894468.67

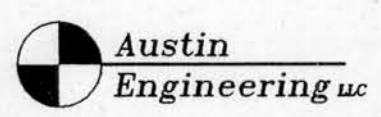
**SURVEYOR'S CERTIFICATE:**  
 I, Larry L. Austin, Registered Wisconsin Land Surveyor, hereby certify:  
 That the corners shown on this survey were surveyed, mapped and monumented as shown on this plat by me or under my direct supervision.  
 That this survey was prepared under the instructions of Larry Barta, of the Wisconsin Department of Transportation.  
 That to the best of my knowledge and belief, this plat is an accurate representation thereof.  
 That all plans that do not show a seal impression may contain unauthorized alterations.  
 The certification contained on this document shall not apply to any copies.

Dated this 28th day of October, 2004.  
  
 Larry L. Austin, S-1903  




COORDINATES SHOWN ON THIS DRAWING ARE GRANT COUNTY COORDINATES AS PROVIDED BY THE WISCONSIN DEPARTMENT OF TRANSPORTATION  
 0 400 800  
 SCALE 1" = 400'

**SECTION CORNER SUMMARY**  
 WISCONSIN DEPARTMENT OF TRANSPORTATION  
 PROJECT ID: 1660-04-00  
 U.S.H. 18, MONTFORT - DODGEVILLE ROAD  
 GRANT COUNTY, WISCONSIN

 **Austin Engineering** 4211 HWY 81 E  
 LANCASTER, WI 53813  
 PHONE 608-723-6363  
 FAX 608-723-6702

JOB NO: 045263 DRAWN BY: AJ AUSTIN  
 FIELDBOOK: TDSR APPROVED: LL AUSTIN  
 G:\T6NR1W\25\045263-WISDOT CREW: BS-SA  
 H:\PLAT\T6NR1W\25\045263-WISDOT SHEET 1 OF 1