

PLAT OF SURVEY

FOR: LANCASTER UNITED METHODIST CHURCH
c/o DAVE COOK

JOB #2007-22
CREW ML SS


LEGEND:

- 1"X18" MIN. X1.13 #/LF IRON PIPE SET
- ▲ 3/4" IRON ROD FOUND
- △ 1" OR 1-1/4" IRON PIPE FOUND
- X- FENCE
- () RECORDED AS

BEING A SURVEY OF LOTS 1 THROUGH 4 AND ADJOINING HALF OF THE PLATTED ALLEY OF BLOCK 28 OF THE ORIGINAL PLAT OF THE CITY OF LANCASTER, GRANT COUNTY, WISCONSIN.

RESET VERTICAL AT
BASE OF TIPPED PIPE.
SET AT RECORD, NEAR
LOCATION OF END OF
FOUND HORIZONTAL PIPE
(REMOVED).

GRANT COUNTY COORDINATES
(N) 523274.84
(E) 819590.69
CHERRY STREET (60')
PUBLIC SIDEWALKS NOTED WHERE MEASURED
FOR REFERENCE.

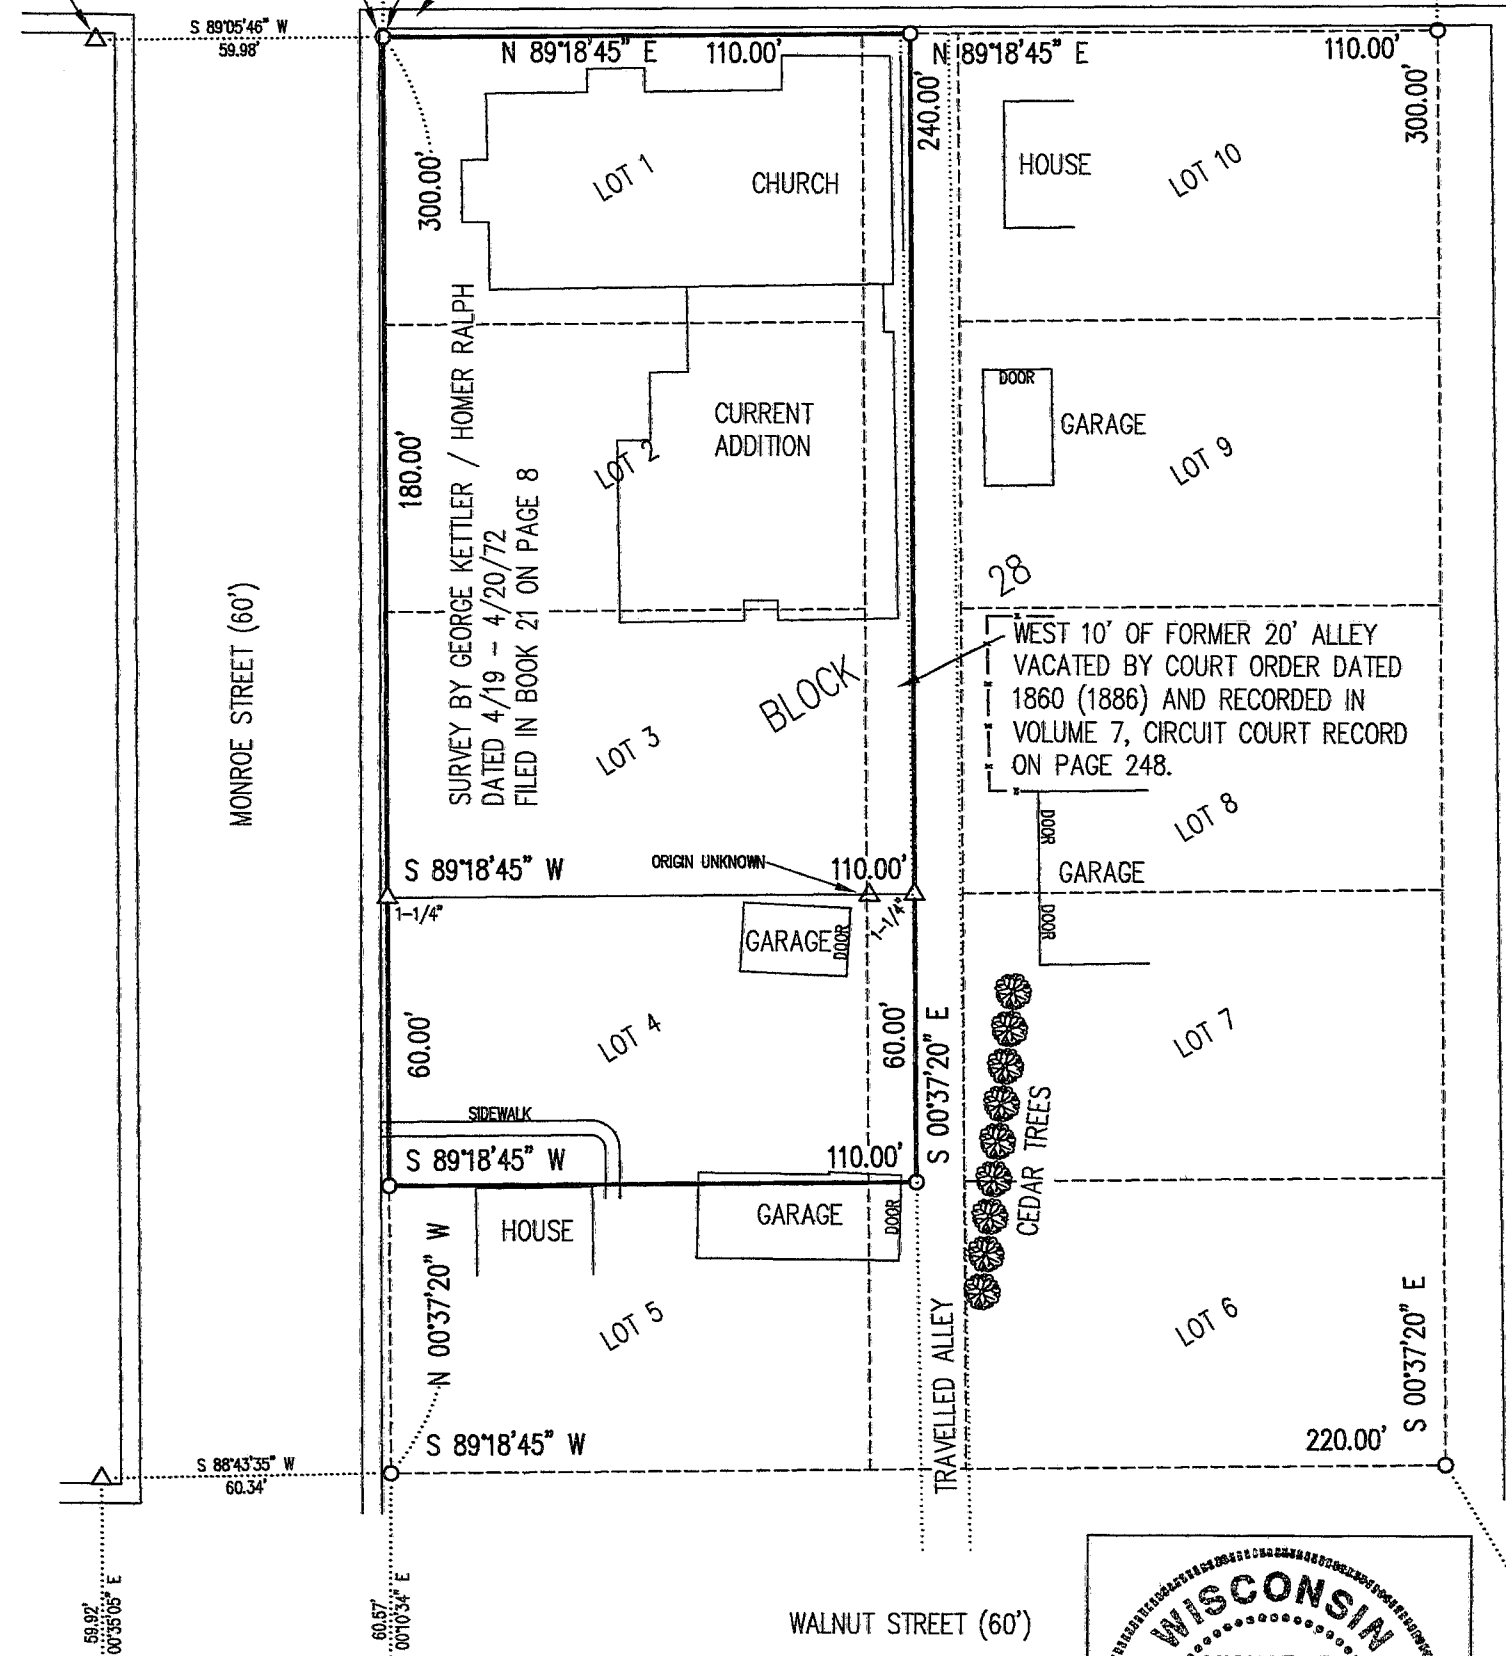

SURVEYOR'S CERTIFICATE
I HEREBY CERTIFY THAT I HAVE MADE A SURVEY
ACCORDING TO THE DESCRIPTION AND/OR INSTRUCTIONS
FURNISHED ME AND THAT THE PLAT DRAWN HEREON IS A
CORRECT REPRESENTATION OF THAT SURVEY TO THE
BEST OF MY KNOWLEDGE AND BELIEF.

Michael R. LaRosa
MICHAEL R. LaROSA S-2259



ORIGINALLY DATED 5/9/2007 & REVISED 5/10/2007

M. R. LaROSA TECHNICAL SERVICES

P.O. BOX 383 (263 E. MAIN ST.) LINDEN, WISCONSIN 53553 TEL. 608-623-3000