


PLAT OF SURVEY for SHARON KLINGER-KINGSLEY

LOCATED IN BLOCK 19, ORIGINAL PLAT OF THE VILLAGE OF CASSVILLE, GRANT COUNTY, WISCONSIN

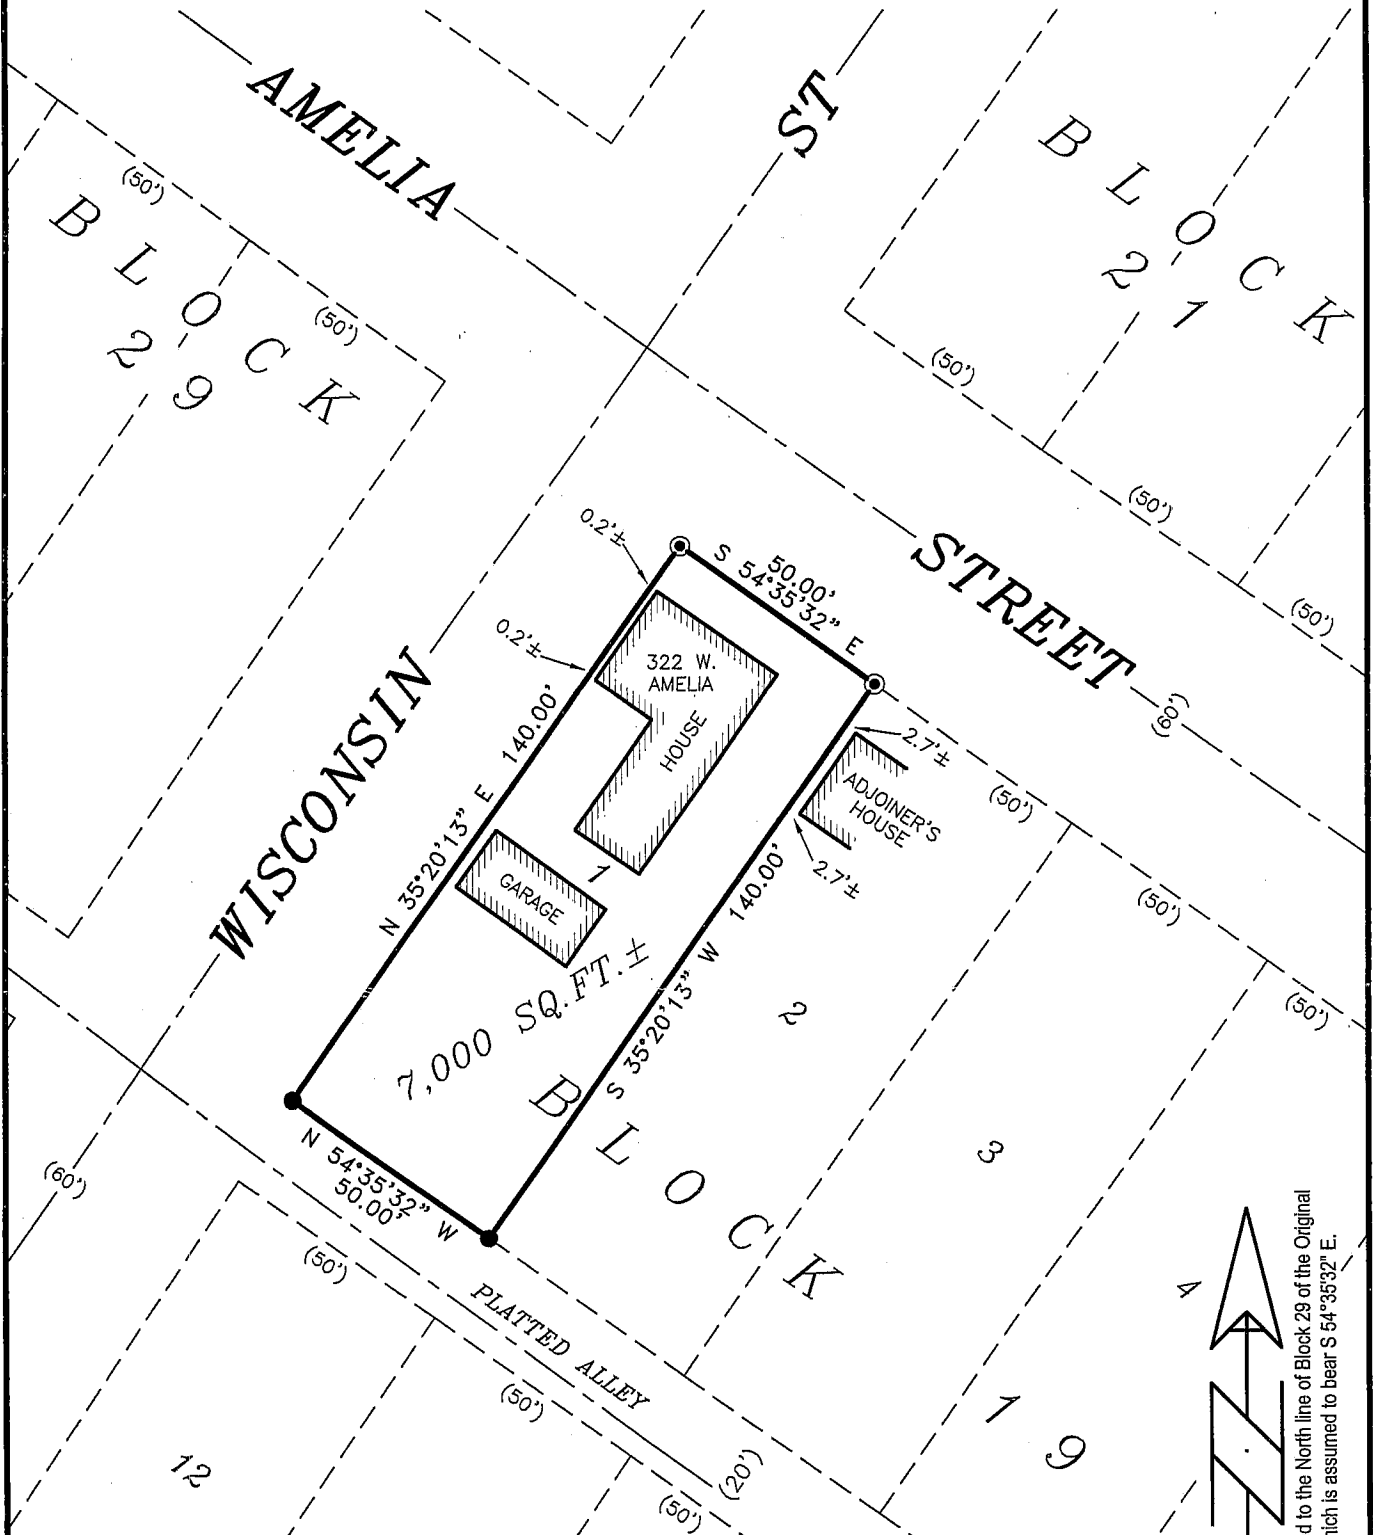


DESCRIPTION PROVIDED:

Lot One (1) of Block Nineteen (19) of the Village of Cassville, Grant County, Wisconsin, according to the recorded map or plat thereof. Situated in Grant County, State of Wisconsin.

SURVEYOR'S CERTIFICATE:


I, Larry L. Austin, Registered Wisconsin Land Surveyor, hereby certify: That the above description was surveyed, mapped and monumented as shown on this plat by me or under my direct supervision all in accordance with the instructions of Steve Hochhausen of Rountree Realty, and to the best of my knowledge and belief, this plat is an accurate representation thereof. Dated this 13th day of July, 2007.

Revised this 31st August, 2007. (MAP ONLY) ALL PLANS THAT DO NOT SHOW A SEAL IMPRINT IN RED INK MAY CONTAIN UNAUTHORIZED ALTERATIONS. THE CERTIFICATION CONTAINED ON THIS DOCUMENT SHALL NOT APPLY TO ANY COPIES.

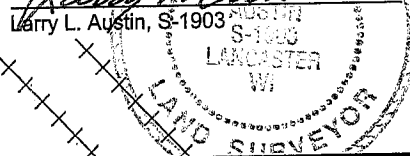


LEGEND

- No. 6 x 24" rebar set with cap - wt=1.50 #/l.f.
- 1/4" diameter drill hole placed in concrete
- () Recorded as

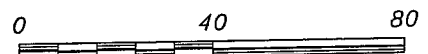

SCALE 1" = 40'

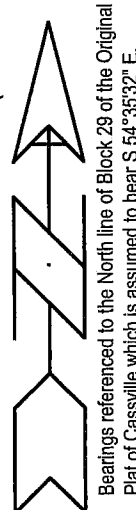

AUSTIN ENGINEERING, LLC
4211 HWY 81 E, LANCASTER, WI 53813
PHONE 608-723-6363 FAX 608-723-6702

FIELDBOOK: 2112
G:\CASSVILLE\WALZ
C:\AJA\CASSVILLE\BLOCK19\KLINGER-KINGSLEY
DRAWN BY: AJ AUSTIN
APPROVED: LL AUSTIN
CREW: BS - SB - TA
SHEET 1 OF 1

SEP 10 2007