
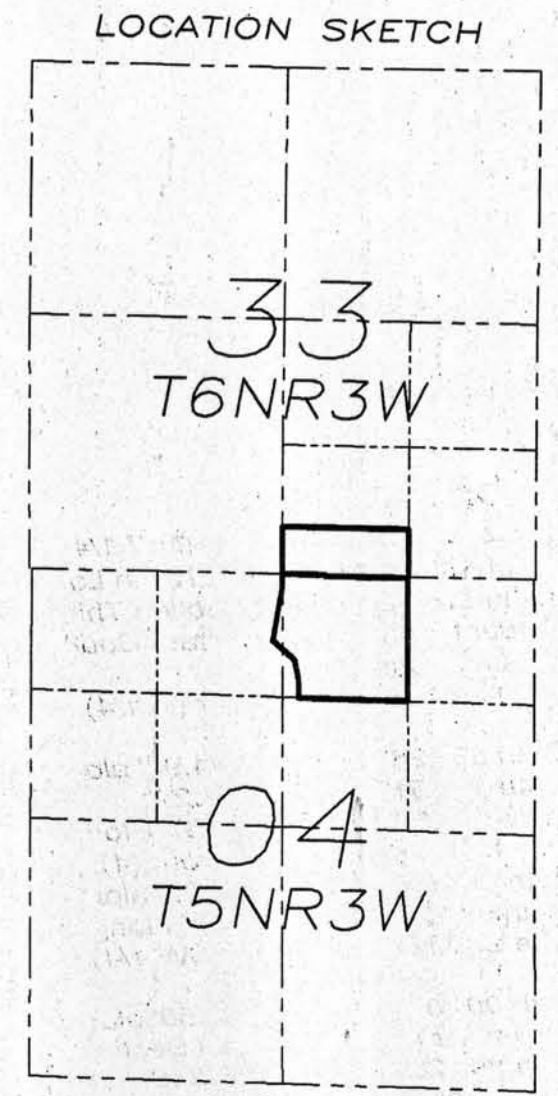


PLAT OF SURVEY

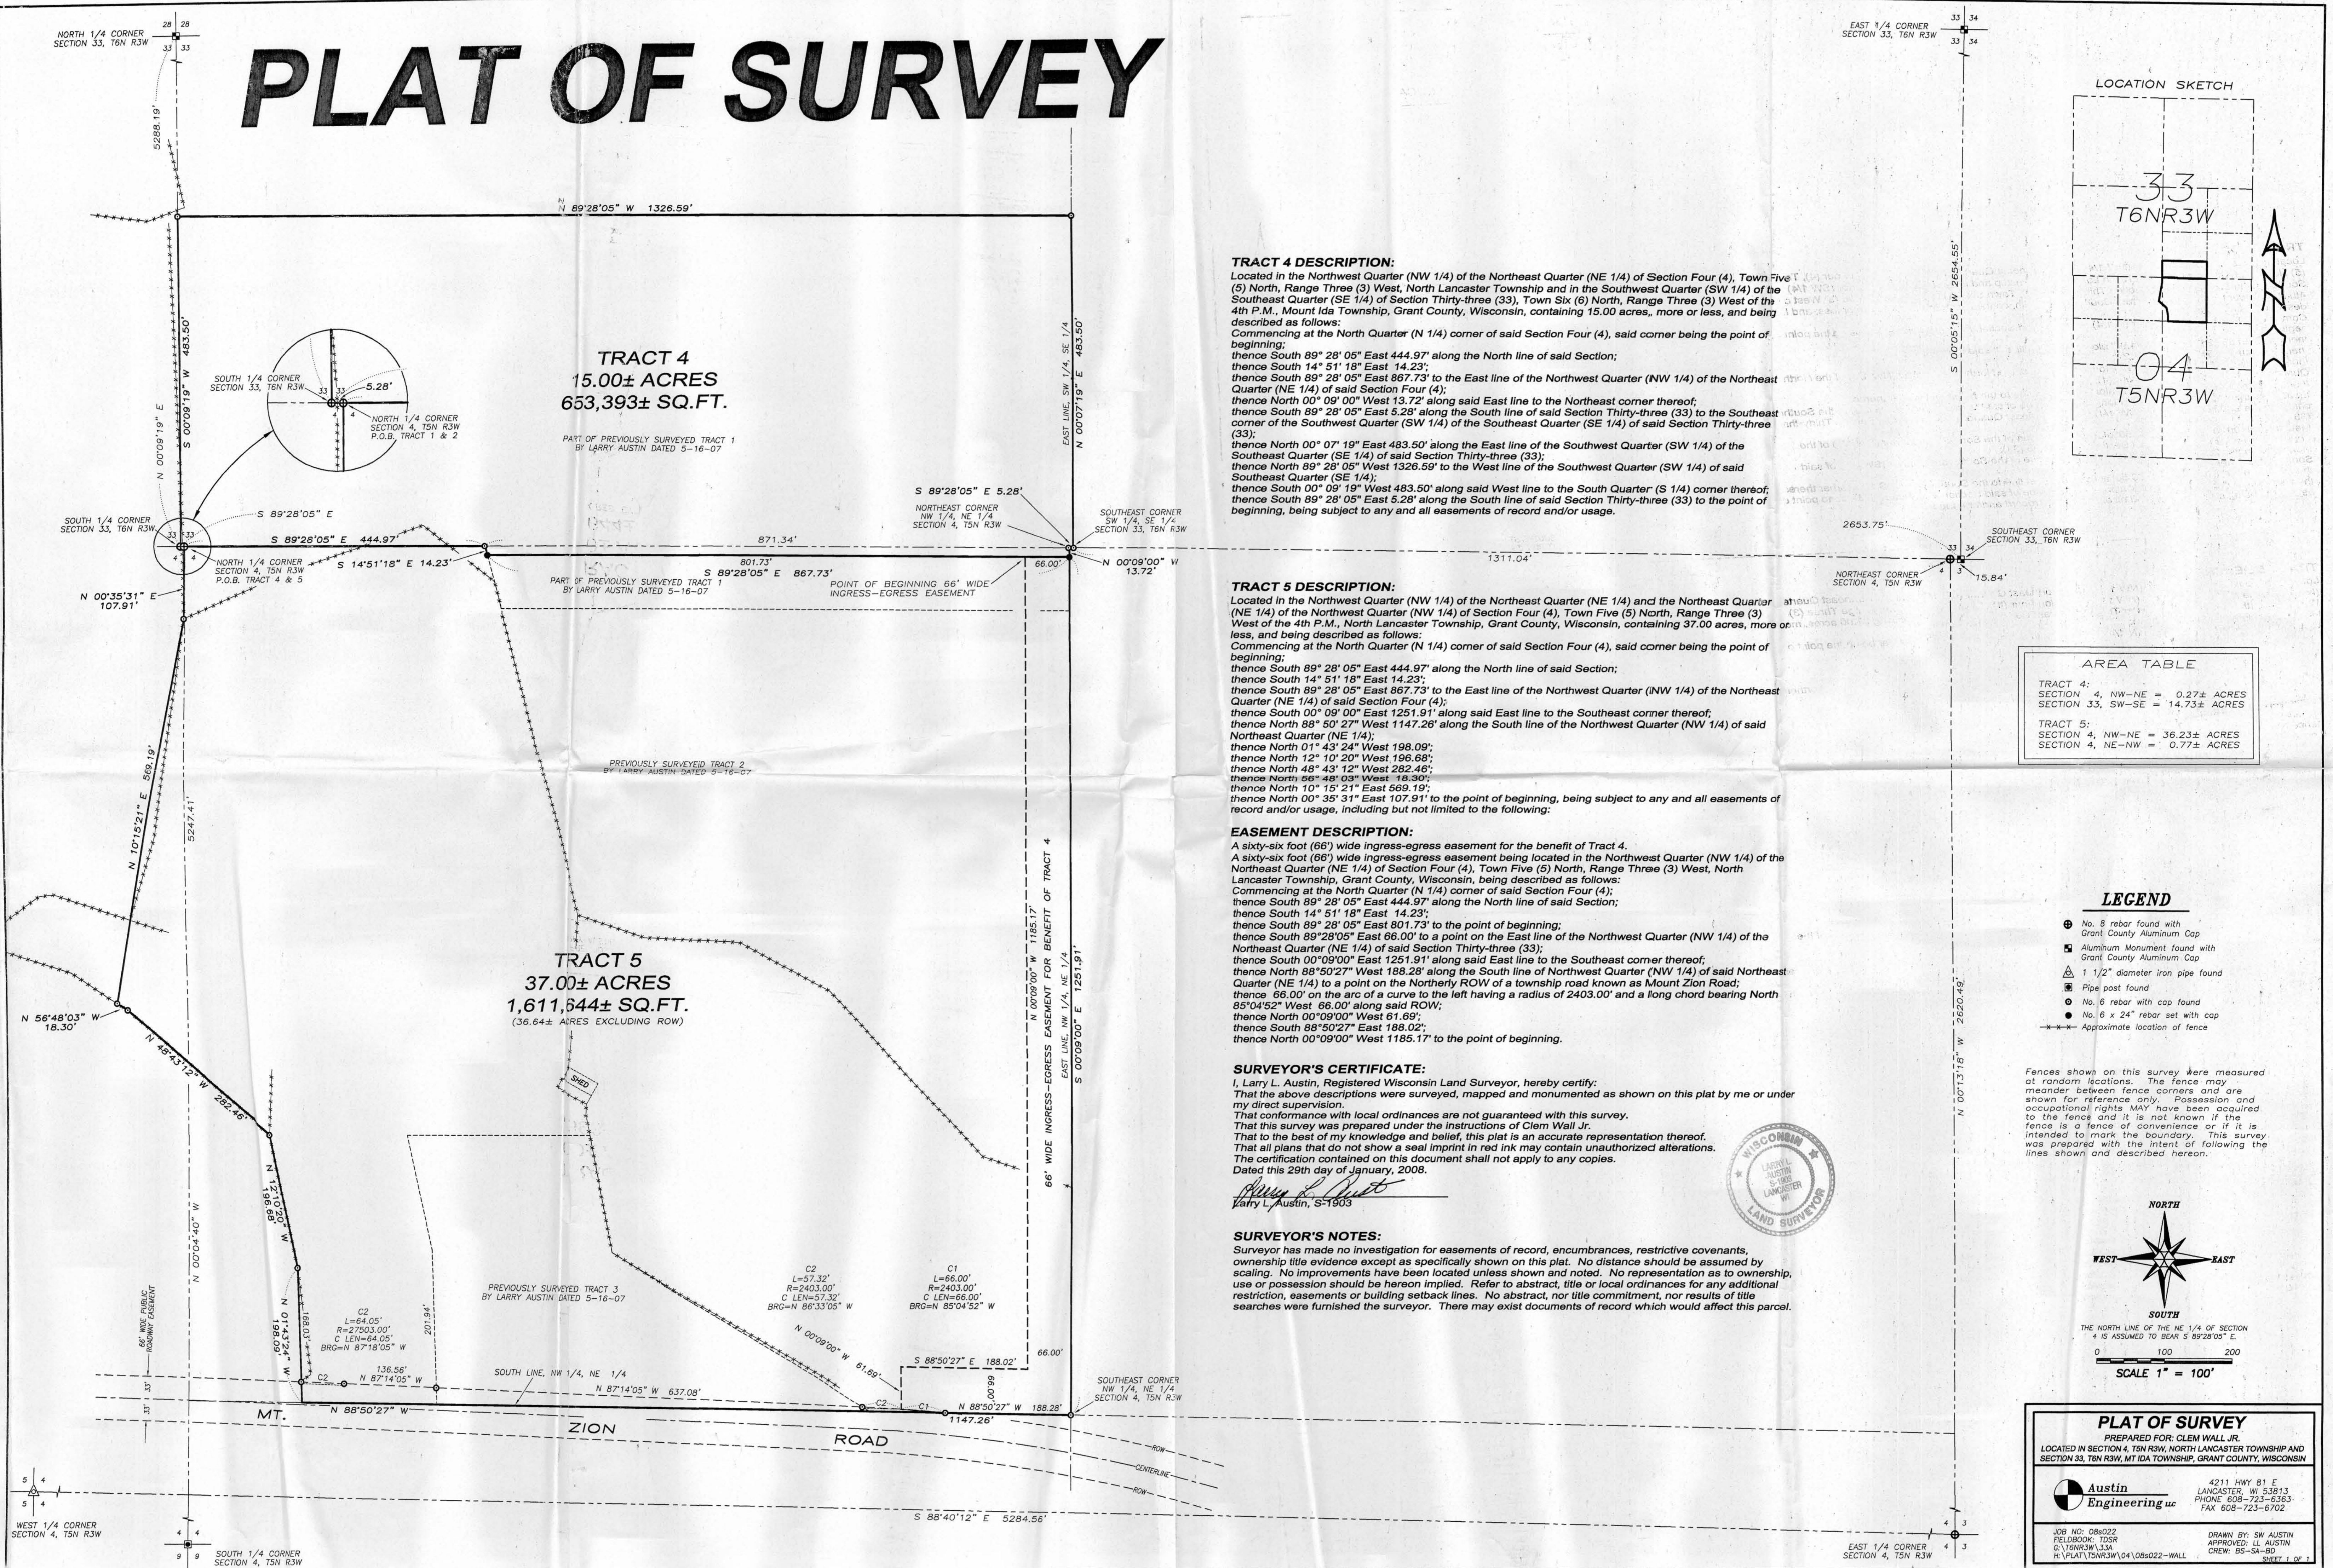


AREA TABLE

TRACT 4:	
SECTION 4, NW-NE =	0.27± ACRES
SECTION 33, SW-SE =	14.73± ACRES
TRACT 5:	
SECTION 4, NW-NE =	36.23± ACRES
SECTION 4, NE-NW =	0.77± ACRES

- LEGEND**
- ⊕ No. 8 rebar found with Grant County Aluminum Cap
 - ⊕ Aluminum Monument found with Grant County Aluminum Cap
 - ⊕ 1 1/2" diameter iron pipe found
 - ⊕ Pipe post found
 - ⊕ No. 6 rebar with cap found
 - ⊕ No. 6 x 24" rebar set with cap
 - Approximate location of fence

Fences shown on this survey were measured at random locations. The fence may meander between fence corners and are shown for reference only. Possession and occupational rights MAY have been acquired to the fence and it is not known if the fence is a fence of convenience or if it is intended to mark the boundary. This survey was prepared with the intent of following the lines shown and described hereon.

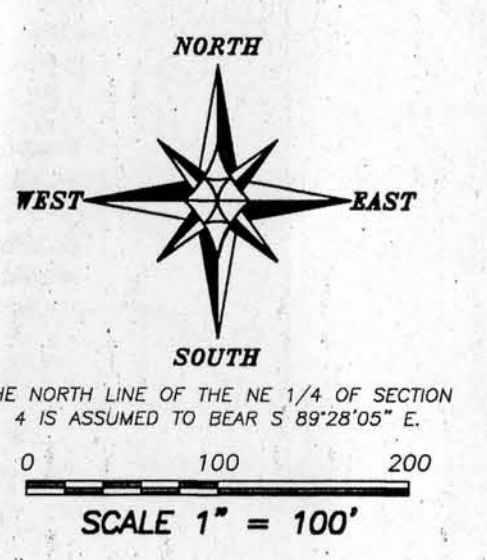

PLAT OF SURVEY
PREPARED FOR: CLEM WALL JR.
LOCATED IN SECTION 4, T5N R3W, NORTH LANCASTER TOWNSHIP AND IN SECTION 33, T6N R3W, MT IDA TOWNSHIP, GRANT COUNTY, WISCONSIN

Austin Engineering Inc.
4211 HWY 81 E
LANCASTER, WI 53813
PHONE 608-723-6363
FAX 608-723-6702

JOB NO: 08s022
FIELDBOOK: T05P
G:\T6N R3W\33A
H:\PLAT\T5N R3W\04\08s022-WALL

DRAWN BY: SW AUSTIN
APPROVED: LL AUSTIN
CREW: ES-34-SD

SHEET 1 OF 1