
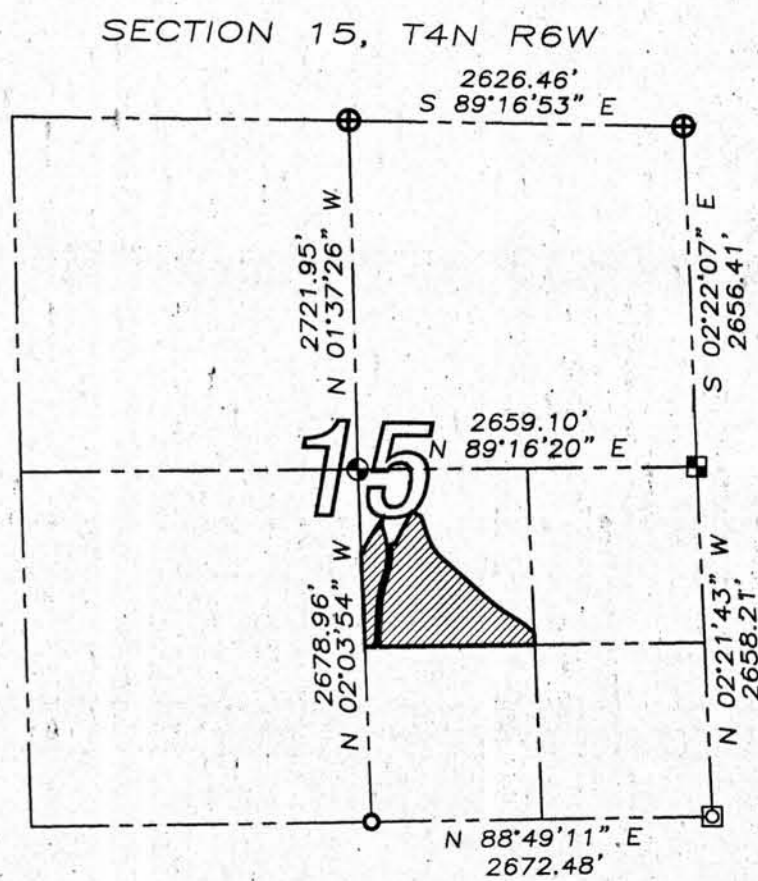


PLAT OF SURVEY

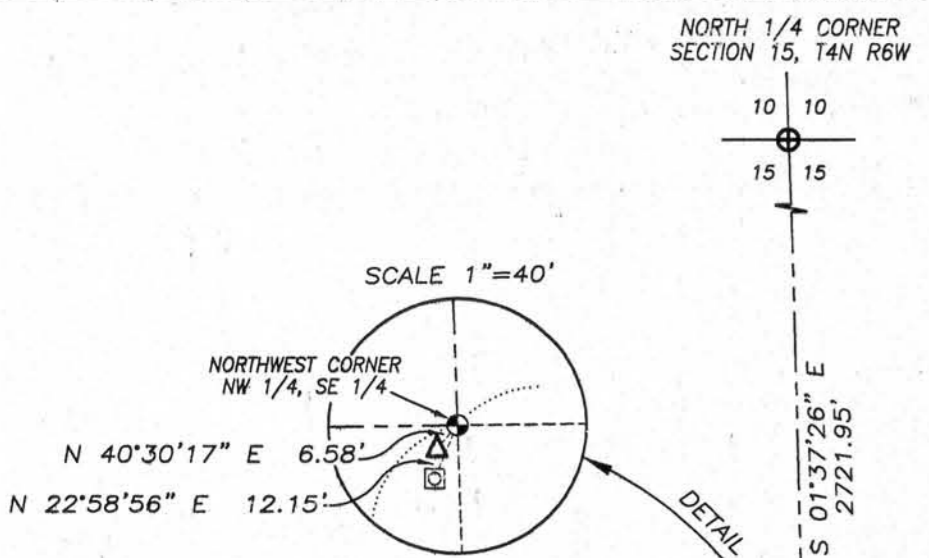

TRACT 1 DESCRIPTION:
 Located in the Northwest Quarter (NW 1/4) of the Southeast Quarter (SE 1/4) of Section Fifteen (15), Town Four (4) North, Range Six (6) West of the 4th P.M., Glen Haven Township, Grant County, Wisconsin, containing 2.73 acres, more or less, and being described as follows:
 Commencing at the South Quarter (S 1/4) corner of said Section Fifteen (15); thence North 02° 03' 54" West 1339.48' along the West line of the Southeast Quarter (SE 1/4) of said Section to the Southwest corner of the Northwest Quarter (NW 1/4) of said Section to the Southwest corner of the Northwest Quarter (NW 1/4) of said Southeast Quarter (SE 1/4), said corner being the point of beginning; thence North 89° 02' 43" East 87.30' along the South line of the Northwest Quarter (NW 1/4) of said Southeast Quarter (SE 1/4); thence 41.80' on the arc of a curve to the right having a radius of 416.50' and a long chord bearing North 00° 41' 12" West 41.78'; thence North 02° 11' 18" East 216.42'; thence 277.26' on the arc of a curve to the right having a radius of 856.50' and a long chord bearing North 11° 27' 44" East 276.05'; thence 312.33' on the arc of a curve to the left having a radius of 463.50' and a long chord bearing North 02° 13' 48" East 306.00'; thence North 16° 18' 39" West 46.60'; thence 96.91' on the arc of a curve to the right having a radius of 130.99' and a long chord bearing North 04° 55' 08" East 94.72'; thence South 33° 31' 13" West 329.90' to the West line of said Southeast Quarter (SE 1/4); thence South 02° 03' 54" East 701.26' along the West line of said Southeast Quarter (SE 1/4) to the point of beginning.


TRACT 2 DESCRIPTION:
 Located in the Northwest Quarter (NW 1/4) of the Southeast Quarter (SE 1/4) of Section Fifteen (15), Town Four (4) North, Range Six (6) West of the 4th P.M., Glen Haven Township, Grant County, Wisconsin, containing 14.69 acres, more or less, and being described as follows:
 Commencing at the South Quarter (S 1/4) corner of said Section Fifteen (15); thence North 02° 03' 54" West 1339.48' along the West line of the Southeast Quarter (SE 1/4) of said Section to the Southwest corner of the Northwest Quarter (NW 1/4) of said Southeast Quarter (SE 1/4); thence continuing North 89° 02' 43" East 33.04' along said South line to the point of beginning; thence 39.99' on the arc of a curve to the right having a radius of 363.50' and a long chord bearing North 00° 47' 56" West 39.97'; thence North 02° 11' 18" East 216.42'; thence 266.58' on the arc of a curve to the right having a radius of 823.50' and a long chord bearing North 11° 27' 44" East 265.42'; thence 253.67' on the arc of a curve to the left having a radius of 516.50' and a long chord bearing North 08° 39' 57" East 251.13'; thence North 88° 09' 09" East 32.90' along a line of that property as described in Volume 692, Page 557 recorded as Document No. 550216, Grant County Registry; thence North 28° 42' 31" East 279.11' along a line of said property described in Volume 692, Page 557; thence South 62° 03' 09" East 83.30' along a line of said property described in Volume 692, Page 557; thence South 19° 09' 22" East 150.64' along the centerline of a township road known as Squirrel Hollow Road; thence 212.31' on the arc of a curve to the left having a radius of 395.00' and a long chord bearing South 34° 33' 14" East 209.76' along said centerline; thence South 49° 57' 07" East 491.33' along said centerline; thence 215.46' on the arc of a curve to the left having a radius of 970.00' and a long chord bearing South 56° 18' 55" East 215.02' along said centerline; thence 191.41' on the arc of a curve to the right having a radius of 670.00' and a long chord bearing South 54° 29' 39" East 190.76' along said centerline to the East line of the Northwest Quarter (NW 1/4) of said Southeast Quarter (SE 1/4); thence South 02° 12' 46" East 90.79' along said East line to the Southwest corner of the Northwest Quarter (NW 1/4) of said Southeast Quarter (SE 1/4); thence South 89° 02' 43" West 1212.55' along the South line of the Northwest Quarter (NW 1/4) of said Southeast Quarter (SE 1/4) to the point of beginning.

SURVEYOR'S CERTIFICATE:
 I, Larry L. Austin, Registered Wisconsin Land Surveyor, hereby certify:
 That the above descriptions were surveyed, mapped and monumented as shown on this plat by me or under my direct supervision.
 That conformance with local ordinances are not guaranteed with this survey.
 That this survey was prepared under the instructions of Darrel Hundley.
 That to the best of my knowledge and belief, this plat is an accurate representation thereof.
 That all plans that do not show a seal imprint in red ink may contain unauthorized alterations.
 The certification contained on this document shall not apply to any copies.
 Dated this 12th day of February, 2008.
 Revised this 7th day of March, 2008. (MONUMENTATION ONLY) *Larry L. Austin*
 Larry L. Austin, S-1903



SURVEYOR'S NOTES:
 The following documents were reviewed, but not limited to, during the course of this survey:
 Description provided: Warranty Deed, Volume 591, Page 75, recorded as Document No. 495195, Grant County Registry;
 -Warranty Deed, Volume 194, Page 354, Grant County Registry;
 -Warranty Deed, Volume 214, Page 17, Grant County Registry;
 -Warranty Deed, Volume 214, Page 422, Grant County Registry;
 -Warranty Deed, Volume 226, Page 62, Grant County Registry;
 -Land Contract, Volume 560, Page 182, Grant County Registry;
 -Order for Correcting Description in Conveyance, Volume 319, Page 451, Grant County Registry;
 -Personal Representative's Deed, Volume 692, Page 557, Grant County Registry;
 -Plat of Right of Way, Project No. S0201(1), Glen Haven - North Dover Road, C.T.H. "V", Grant County;
 -Plat of Survey by Larry Austin dated 6-2-1993;
 -Plat of Survey by Larry Austin dated 1-14-2002;
 -Survey of Section 15 by C.W. Hayden, dated January 1, 1839;

It should be noted that the Exception described in Volume 226, Page 62, has an Order for Correcting Description in Conveyance, recorded in Volume 319, Page 451. The Description contained in Volume 319, Page 451 is not the same as the Personal Representatives Deed recorded in Volume 692, Page 558. That description which was recorded in Volume 692, Page 558 was retraced and utilized for this survey. There is also a right of way reserved in Volume 591, Page 75 which was referred to in Volume 226, Page 62 which reserved the right to haul wood across the South end of said property. There was no width specified in this document.
 There is also a right of way reserved in Volume 591, Page 75 which was referred to in Volume 214, Page 17 which reserved the right for hauling wood off adjoining land. It should be noted that this document conveyed 2 roads, one rod on each side of the center of the private road. This private road has since been changed to a township road known as May Lane. This survey monuments the boundary lines of the conveyance of Volume 214, Page 17, and not necessarily the right of way for May Lane.
 Surveyor has made no investigation for easements of record, encumbrances, restrictive covenants, ownership title evidence except as specifically shown on this plat. No distance should be assumed by scaling. No improvements have been located unless shown and noted. No representation as to ownership, use or possession should be hereon implied. Refer to abstract, title or local ordinances for any additional restriction, easements or building setback lines. No abstract, nor title commitment, nor results of title searches were furnished the surveyor.

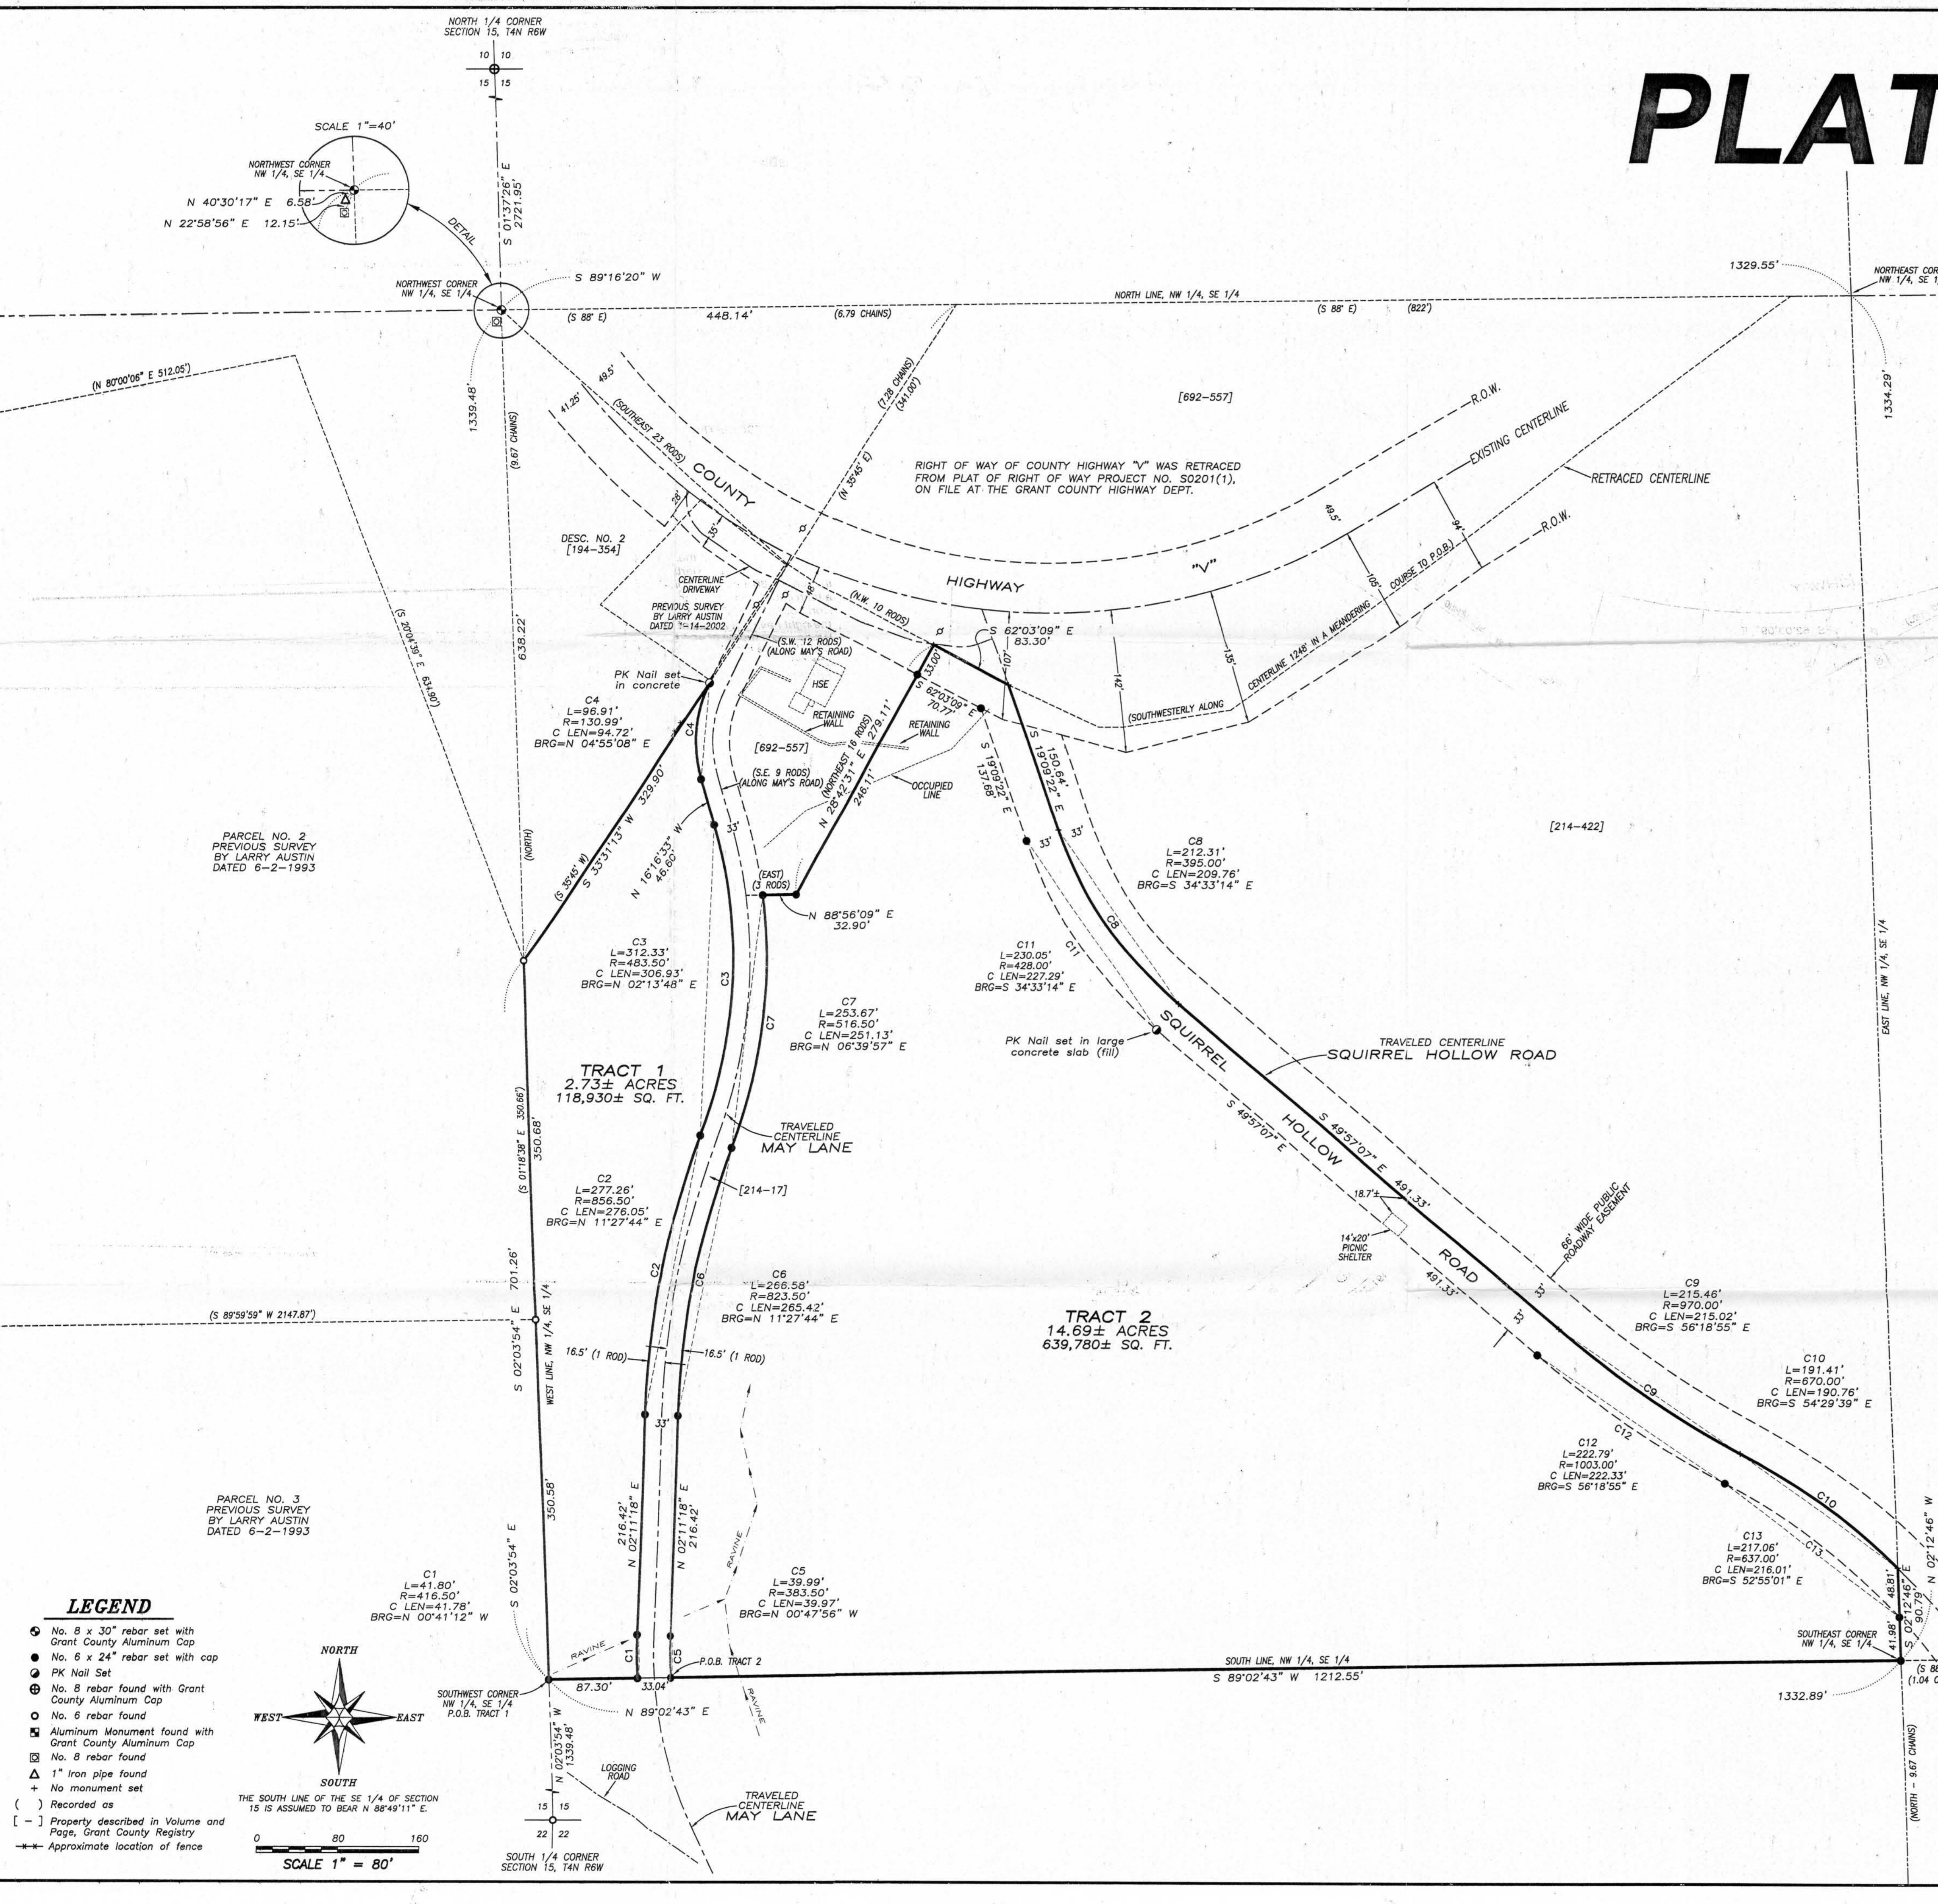

PLAT OF SURVEY
 PREPARED FOR: DARREL HUNDLEY
 LOCATED IN SECTION 15, T4N R6W, GLEN HAVEN TOWNSHIP, GRANT COUNTY, WISCONSIN

Austin Engineering Inc.
 4211 HWY 81 E
 LANCASTER, WI 53813
 PHONE 608-723-6363
 FAX 608-723-6702

JOB NO: 07-352
 FIELDBOOK: TDSR
 G:\TANREW\10
 H:\PLAT\T4N R6W\15\07-352-HUNDLEY

DRAWN BY: AJ AUSTIN
 APPROVED: LL AUSTIN
 CREW: BS-SA-BD

SHEET 1 OF 1