



PLAT OF SURVEY

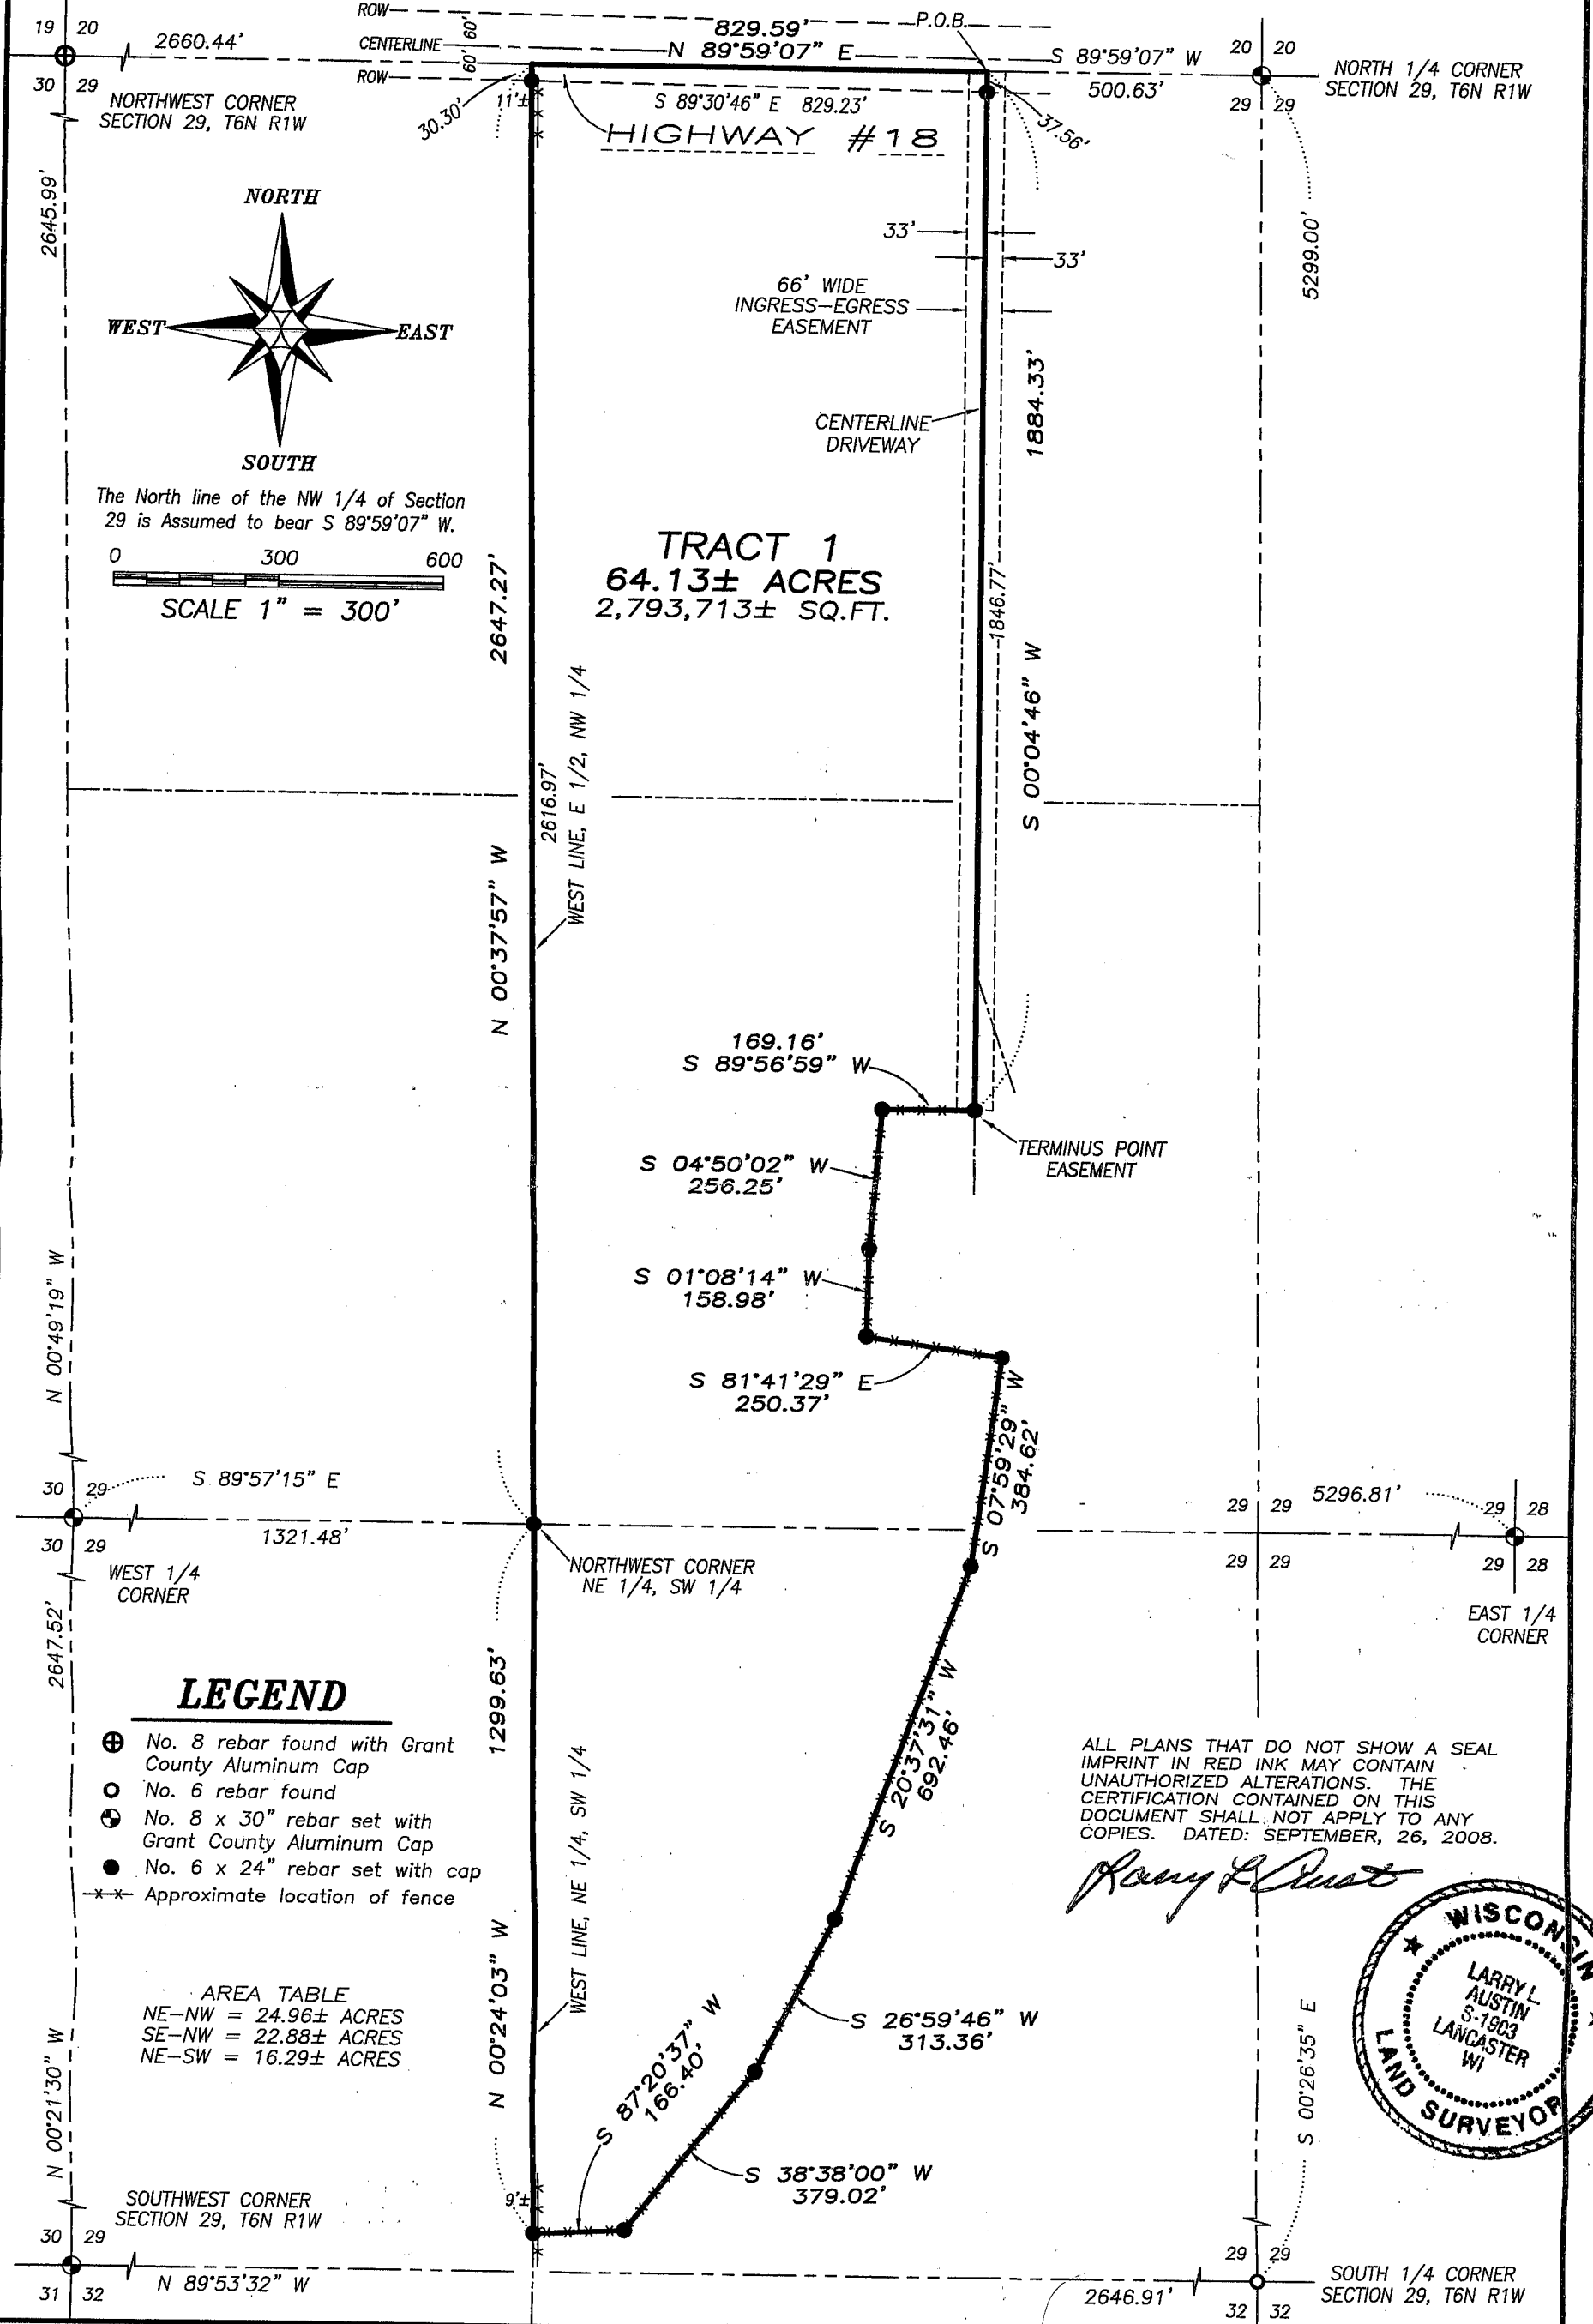

ALL PLANS THAT DO NOT SHOW A SEAL IMPRINT IN RED INK MAY CONTAIN UNAUTHORIZED ALTERATIONS. THE CERTIFICATION CONTAINED ON THIS DOCUMENT SHALL NOT APPLY TO ANY COPIES. DATED: SEPTEMBER, 26, 2008.

Randy R. Rust

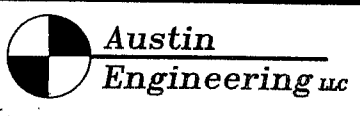

Prepared For: MIKE KELLY

4211 HWY 81 E, LANCASTER, WI 53813
PHONE 608-723-6363 FAX 608-723-6702

JOB NO: 08s198
FIELDBOOK: TDSR, 2800
G:\GRANTDOT\HWY18
H:\PLAT\T6NR1W\29\08s198-KELLY

DRAWN BY: AJ AUSTIN
APPROVED: LL AUSTIN
CREW: BS-SB-BD

PLAT OF SURVEY

TRACT 1 DESCRIPTION:

Located in the Northeast Quarter (NE 1/4) of the Northwest Quarter (NW 1/4), the Southeast Quarter (SE 1/4) of the Northwest Quarter (NW 1/4) and the Northeast Quarter (NE 1/4) of the Southwest Quarter (SW 1/4) of Section Twenty-nine (29), Town Six (6) North, Range One (1) West of the 4th P.M., Wingville Township, Grant County, Wisconsin, containing 64.13 acres, more or less, and being described as follows:

Commencing at the North Quarter (N 1/4) corner of said Section;
thence South 89° 59' 07" West 500.63' along the North line of said Section to the point of beginning;
thence South 00° 04' 46" West 1884.33' to a No. 6 rebar;
thence South 89° 56' 59" West 169.16' to a No. 6 rebar;
thence South 04° 50' 02" West 256.25' to a No. 6 rebar;
thence South 01° 08' 14" West 158.98' to a No. 6 rebar;
thence South 81° 41' 29" East 250.37' to a No. 6 rebar;
thence South 07° 59' 29" West 384.62' to a No. 6 rebar;
thence South 20° 37' 31" West 692.46' to a No. 6 rebar;
thence South 26° 59' 46" West 313.36' to a No. 6 rebar;
thence South 38° 38' 00" West 379.02' to a No. 6 rebar;
thence South 87° 20' 37" West 166.40' to a No. 6 rebar on the West line of the Northeast Quarter (NE 1/4) of said Southwest Quarter (SW 1/4);
thence North 00° 24' 03" West 1299.63' along the West line of the Northeast Quarter (NE 1/4) of said Southwest Quarter (SW 1/4) to the Northwest corner thereof;
thence North 00° 37' 57" West 2647.27' along the West line of the East Half (E 1/2) of said Northwest Quarter (NW 1/4) to the Northwest corner thereof;
thence North 89° 59' 07" East 829.59' along the North line of said Section to the point of beginning. Tract being subject to any and all easements of record and/or usage, including, but not limited to an ingress-egress easement being described as follows:

EASEMENT DESCRIPTION:

A Sixty-six foot (66') wide ingress-egress easement being located in the Northeast Quarter (NE 1/4) of the Northwest Quarter (NW 1/4) and the Southeast Quarter (SE 1/4) of the Northwest Quarter (NW 1/4) of Section Twenty-nine (29), Town Six (6) North, Range One (1) West of the 4th P.M., Wingville Township, Grant County, Wisconsin, said easement being located Thirty-three feet (33') on each side of the following described centerline:

Commencing at the North Quarter (N 1/4) corner of said Section;
thence South 89° 59' 07" West 500.63' along the North line of said Section to the point of beginning;
thence South 00° 04' 46" West 1884.33' to a No. 6 rebar marking the terminus point.

EASEMENT NOTES:

Other documentation will need to be recorded to clarify the intent, use, maintenance, assignments or other pertinent information of this easement.

SURVEYOR'S CERTIFICATE:

I, Larry L. Austin, Registered Wisconsin Land Surveyor, hereby certify:

That the above descriptions were surveyed, mapped and monumented as shown on this plat by me or under my direct supervision.

That conformance with local ordinances are not guaranteed with this survey.

That this survey was prepared under the instructions of Mike Kelly.


That to the best of my knowledge and belief, this plat is an accurate representation thereof.

That all plans that do not show a seal imprint in red ink may contain unauthorized alterations.

The certification contained on this document shall not apply to any copies.


Dated this 26th day of September, 2008.


Larry L. Austin, S-1903

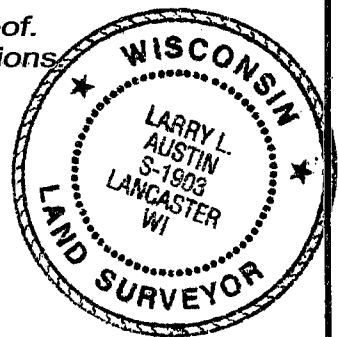

SURVEYOR'S NOTES:

Surveyor has made no investigation for easements of record, encumbrances, restrictive covenants, ownership title evidence except as specifically shown on this plat. No distance should be assumed by scaling. No improvements have been located unless shown and noted. No representation as to ownership, use or possession should be hereon implied. Refer to abstract, title or local ordinances for any additional restriction, easements or building setback lines. No abstract, nor title commitment, nor results of title searches were furnished the surveyor.

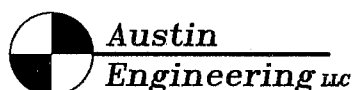

4211 HWY 81 E, LANCASTER, WI 53813
PHONE 608-723-6363 FAX 608-723-6702

Prepared For: MIKE KELLY

JOB NO: 08s198
FIELDBOOK: TDSR, 2800
G:\GRANTDOT\HWY18
H:\PLAT\T6NR1W\29\08s198-KELLY

DRAWN BY: AJ AUSTIN
APPROVED: LL AUSTIN
CREW: BS-SB-BD