


# PLAT OF SURVEY

ALL PLANS THAT DO NOT SHOW A SEAL IMPRINT IN RED INK MAY CONTAIN UNAUTHORIZED ALTERATIONS. THE CERTIFICATION CONTAINED ON THIS DOCUMENT SHALL NOT APPLY TO ANY COPIES. DATED: 9-30-2008.

*Randy L. Austin*

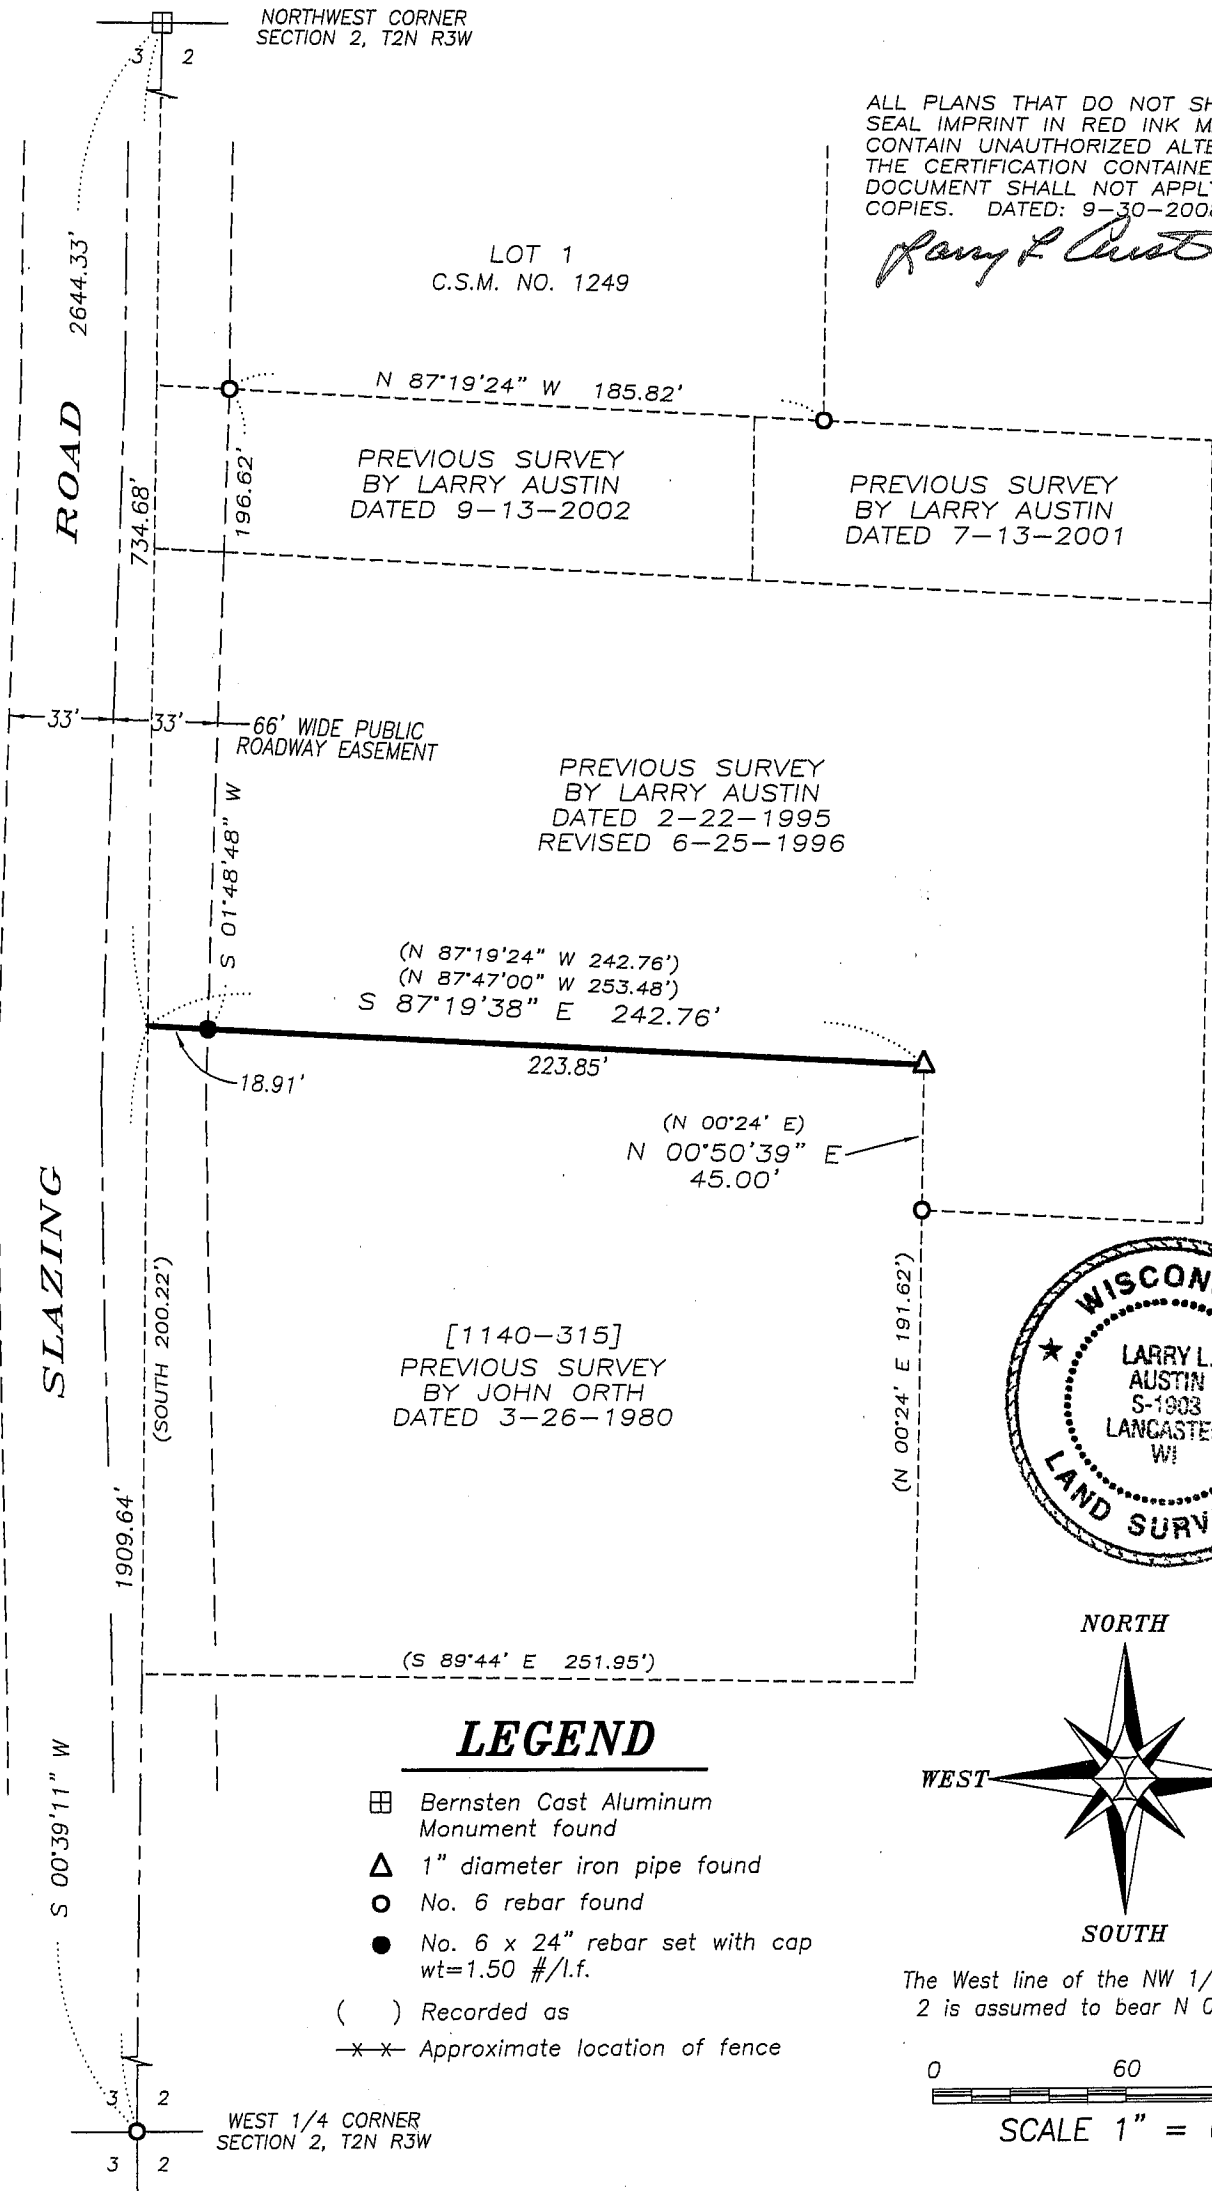

**Austin Engineering LLC**

Prepared For: **STEVE VOGELSBURG**

4211 HWY 81 E, LANCASTER, WI 53813  
PHONE 608-723-6363 FAX 608-723-6702

JOB NO: 08s186  
FIELDBOOK: TDS RANGER  
G:\POTOSI\POTOSI  
H:\PLAT\T2NR3W\02\08s186-VOGELSBURG

DRAWN BY: AJ AUSTIN  
APPROVED: LL AUSTIN  
CREW: BS-SA-BD

SHEET 1 OF 2

OCT 03 2008

# PLAT OF SURVEY

## DESCRIPTION PROVIDED:

The North line of the following described property:

A tract of land located in the Northwest Quarter (N.W.1/4) of the Northwest Quarter (N.W.1/4) of Section Two (2), Township Two (2) North, Range Three (3) West of the 4th P.M., Grant County, Wisconsin, described as follows:

Commencing at the Southeast corner of Section Three (3), T2N, R3W; thence North 4359.10 feet along the West line of said Section 2 to the point of beginning; thence South 89° 44' East 251.95 feet; thence North 00° 24' East 191.62 feet; thence North 87° 47' West 253.48 feet to the West line of said Section 2; thence South 200.22 feet to the point of beginning, containing 1.14 acres, more or less.

## SURVEYOR'S CERTIFICATE:

I, Larry L. Austin, Registered Wisconsin Land Surveyor, hereby certify:

That the North line of the above described parcel was surveyed, mapped and monumented as shown on this plat by me or under my direct supervision.

That conformance with local ordinances are not guaranteed with this survey.

That this survey was prepared under the instructions of Steve Vogelsberg.

That to the best of my knowledge and belief, this plat is an accurate representation thereof.

That all plans that do not show a seal imprint in red ink may contain unauthorized alterations.

The certification contained on this document shall not apply to any copies.

Dated this 30th day of September, 2008.

  
Larry L. Austin, S-1903

## SURVEYOR'S NOTES:

Surveyor has made no investigation for easements of record, encumbrances, restrictive covenants, ownership title evidence except as specifically shown on this plat. No distance should be assumed by scaling. No improvements have been located unless shown and noted. No representation as to ownership, use or possession should be hereon implied. Refer to abstract, title or local ordinances for any additional restriction, easements or building setback lines. No abstract, nor title commitment, nor results of title searches were furnished the surveyor.



Austin Prepared For: STEVE VOGELSBERG  
Engineering LLC

4211 HWY 81 E, LANCASTER, WI 53813  
PHONE 608-723-6363 FAX 608-723-6702

JOB NO: 08s186  
FIELDBOOK: TDS RANGER  
G:\POTOSI\POTOSI  
H:\PLAT\T2NR3W\02\08s186-VOGELSBERG

DRAWN BY: AJ AUSTIN  
APPROVED: LL AUSTIN  
CREW: BS-SA-BD

SHEET 2 OF 2