



BEARINGS REFERENCED TO THE WEST LINE OF THE SW 1/4 OF SECTION 26, T7N, R3W, ASSUMED TO BEAR N001°4'04"W


LOCATED IN THE NW 1/4 OF THE SW 1/4, AND THE NE 1/4 OF THE SW 1/4, AND THE SE 1/4 OF THE SW 1/4, OF SECTION 26, T7N, R3W, TOWN OF MARION, GRANT COUNTY, WISCONSIN.

PLAT OF SURVEY



verbicher
engineers | advisors
124 W. State Street, 5th Floor, Madison, WI 53703
Phone: (608) 224-1031 Fax: (608) 224-1032

W 1/4 CORNER SEC. 26-7-3W (S89°32'31"E) 1326.82' (2653.96') (S89°32'31"E) 2653.64' (S89°32'31"E) 1326.82' (2639.75') (S89°32'31"E) 2639.72' E 1/4 CORNER SEC. 26-7-3W

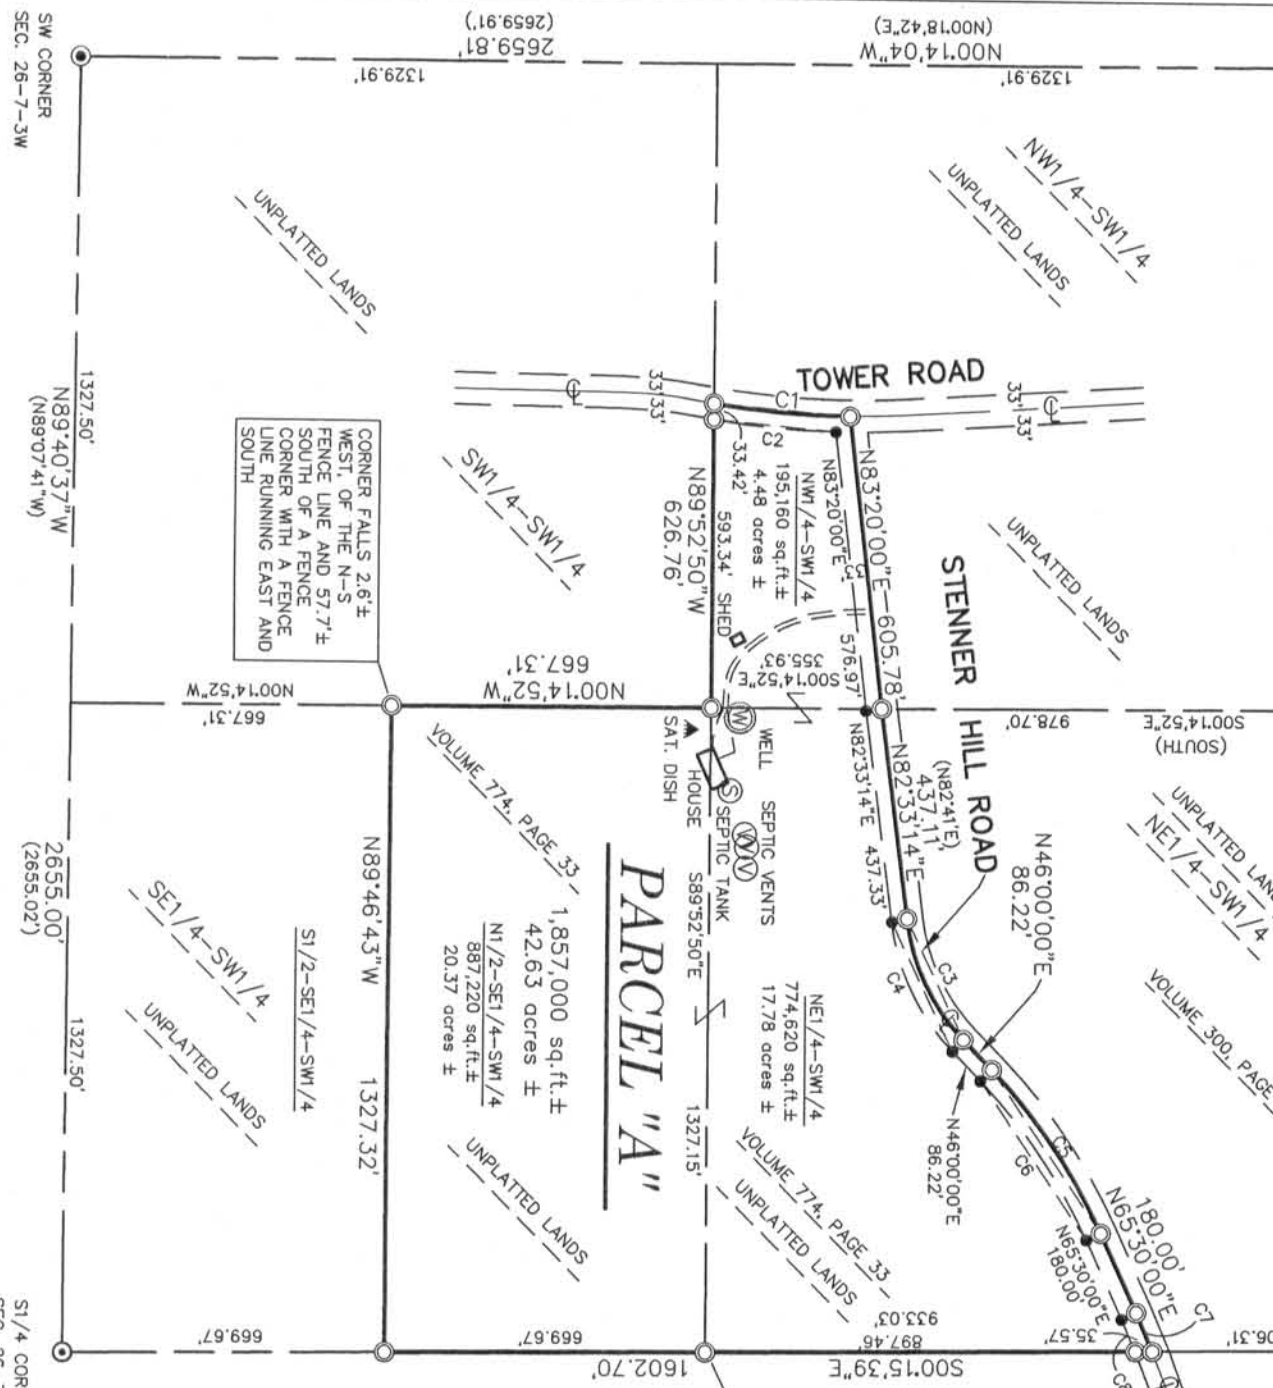

PARCEL "A"

1,857,000 sq. ft. ±
42.63 acres ±
887,220 sq. ft. ±
20.37 acres ±

SEE SHEET 2 OF 2 FOR MORE DETAILS ALONG STENNER HILL ROAD

CURVE	LENGTH	RADIUS	DELTA	CHORD	C. LENGTH
C1	285.56'	1800.00'	09°05'23"	N04°44'02"E	285.28'
C2	256.18'	1833.00'	08°00'27"	N05°06'31"E	255.97'
C3	280.71'	440.00'	36°33'14"	N64°16'37"E	275.98'
C4	301.77'	473.00'	36°33'14"	N64°16'37"E	296.68'
C5	408.41'	1200.00'	19°30'00"	N55°45'00"E	406.44'
C6	397.18'	1167.00'	19°30'00"	N55°45'00"E	395.26'
C7	87.74'	2000.00'	02°30'50"	N66°45'25"E	87.74'
C8	73.13'	1967.00'	02°07'48"	N66°53'54"E	73.13'

CURVE TABLE

VOLUME 774, PAGE 33, DOCUMENT NUMBER 586910

The North One-Half of the Southwest One-Quarter lying east of Tower Road and South of Stenner Hill Road; The North One-Half of the Southeast One-Quarter of the Southwest One-Quarter. All in Section 26, Town 7 North, Range 3 West of the 4th Principal Meridian, Grant County, Wisconsin.



LEGAL DESCRIPTION

LEGEND

- EXISTING 3/4" DIA. IRON ROD
- EXISTING 1" DIA. IRON PIPE
- SET 3/4" DIA. X 24" IRON RE-BAR, 1.50 LBS./LIN.FT.
- COMPUTED CORNER LOCATION
- NO MONUMENT SET

SURVEYOR'S CERTIFICATE:

I, WILLIAM R. BULAWA, WISCONSIN REGISTERED LAND SURVEYOR #2167, HEREBY CERTIFY THAT I HAVE SURVEYED THE LAND SHOWN ON THIS PLAT BY THE DIRECTION OF TOM JONES OWNER, AND THAT THAT SAID SURVEY AND PLAT ARE CORRECT TO THE BEST OF MY KNOWLEDGE AND BELIEF.

William R. Bulawa
WILLIAM R. BULAWA, REGISTERED LAND SURVEYOR #2167
DATE 6-2-2005

WAIVER OF MINIMUM STANDARDS FOR PROPERTY SURVEYS


I, William R. Bulawa, Wisconsin Registered Land Surveyor #2167, hereby agree with my client, Tom Jones, to waive the requirements of the following applicable subsections of Chapter AE 7 of the Administrative Code of the State of Wisconsin (Minimum Standards For Property Surveys):

- * A-E 7.07 Monuments

Monuments have not been placed on all of the corners of Parcels "A".

Tom Jones
Tom Jones
Date 6-4-09

GRAPHIC SCALE FEET

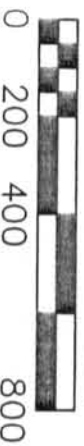

PLAT OF SURVEY


LOCATED IN THE NW1/4 OF THE SW1/4, AND THE NE1/4 OF THE SW1/4, AND THE SE1/4 OF THE SW1/4, OF SECTION 26, T7N, R3W, TOWN OF MARION, GRANT COUNTY, WISCONSIN.

LEGEND


- SET 3/4" DIA. X 24" IRON RE-BAR, 1.50 LBS./LIN.FT.
- COMPUTED CORNER LOCATION NO MONUMENT SET



OVERLAP WITH VOLUME 300, PAGE 562 AND VOLUME 774, PAGE 33

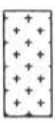


GAP WITH VOLUME 300, PAGE 562 AND VOLUME 774, PAGE 33

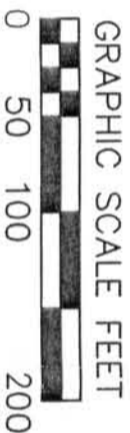

BEARINGS REFERENCED TO THE WEST LINE OF THE SW1/4 OF SECTION 26, T7N, R3W, ASSUMED TO BEAR N001°4'04"W

CURVE	LENGTH	RADIUS	DELTA	CHORD	C. LENGTH
C1	285.56'	1800.00'	09°05'23"	N04°44'02"E	285.26'
C2	256.18'	1833.00'	08°00'27"	N05°06'31"E	255.97'
C3	280.71'	440.00'	36°33'14"	N64°16'37"E	215.98'
C4	301.77'	473.00'	36°33'14"	N64°16'37"E	296.68'
C5	408.41'	1200.00'	19°30'00"	N55°45'00"E	406.44'
C6	397.18'	1167.00'	19°30'00"	N55°45'00"E	395.26'
C7	87.74'	2000.00'	02°30'50"	N66°45'25"E	87.74'
C8	73.13'	1967.00'	02°07'48"	N66°33'54"E	73.13'

CURVE TABLE

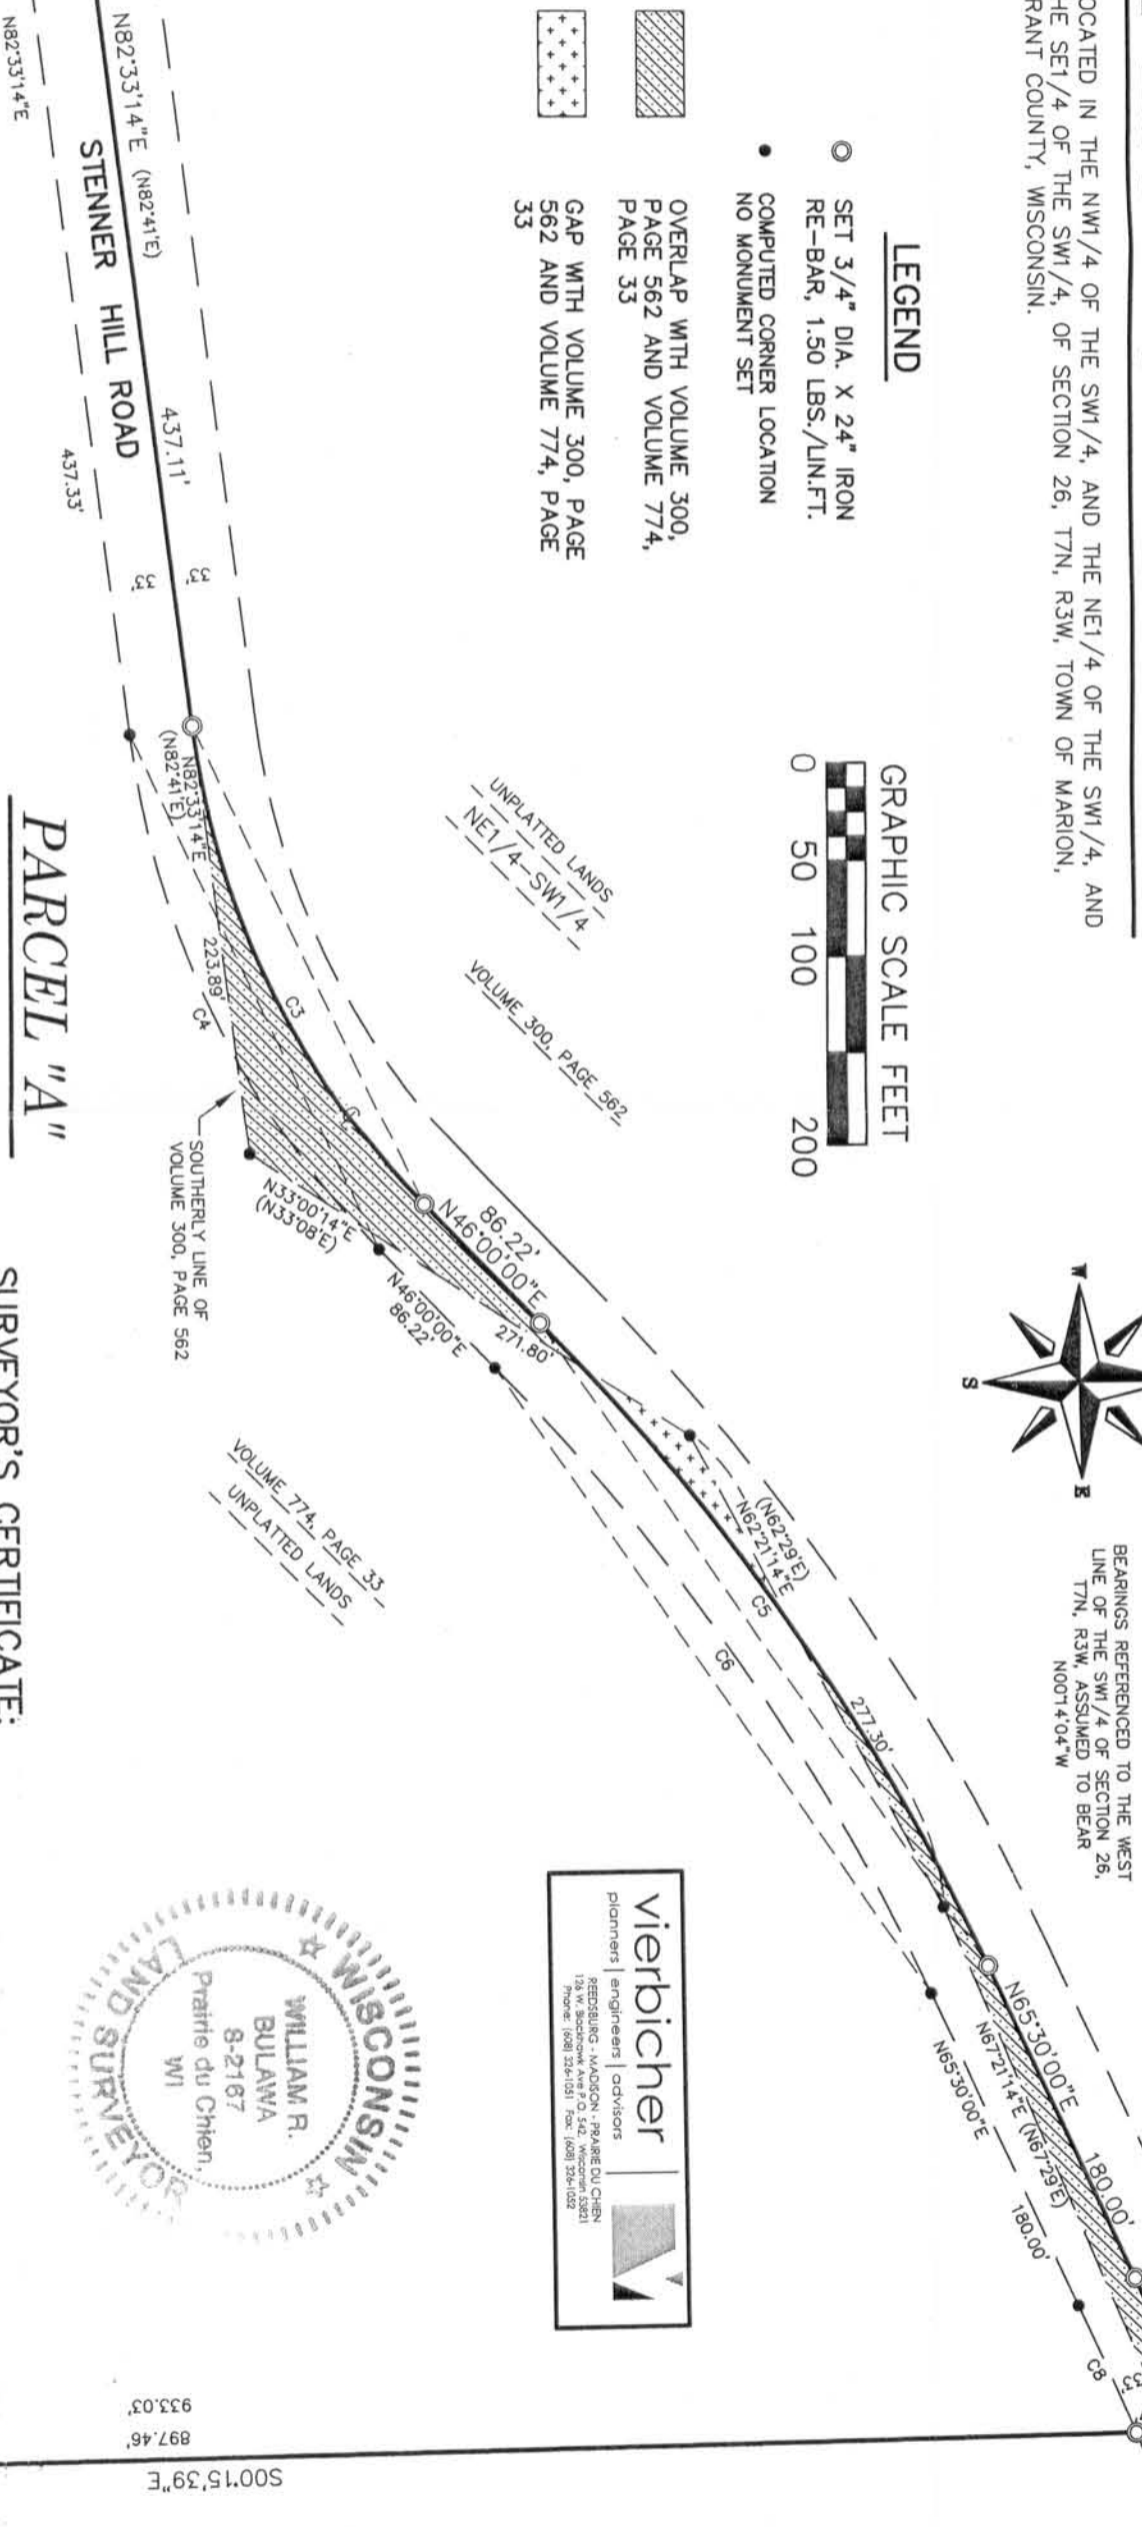

SEPTIC TANK
SEPTIC VENTS

THIS INSTRUMENT DRAFTED BY W. BULAWA

SHEET 2 OF 2

SURVEYOR'S CERTIFICATE:

I, WILLIAM R. BULAWA, WISCONSIN REGISTERED LAND SURVEYOR #2167, HEREBY CERTIFY THAT I HAVE SURVEYED THE LAND SHOWN ON THIS PLAT BY THE DIRECTION OF TOM JONES OWNER, AND THAT THAT SAID SURVEY AND PLAT ARE CORRECT TO THE BEST OF MY KNOWLEDGE AND BELIEF.

William R. Bulawa
WILLIAM R. BULAWA, REGISTERED LAND SURVEYOR #2167
DATE 6-2-2009

WAIVER OF MINIMUM STANDARDS FOR PROPERTY SURVEYS

I, William R. Bulawa, Wisconsin Registered Land Surveyor 2167, hereby agree with my client, Tom Jones, to waive the requirements of the following applicable subsections of Chapter AE 7 of the Administrative Code of the State of Wisconsin (Minimum Standards For Property Surveys):

* A-E 7.07 Monuments
Monuments have not been placed on all of the corners of Parcels "A".

William R. Bulawa
Verbicher Associates, Inc.
William R. Bulawa, Registered Land Surveyor 2167
DATE 6-2-2009

Tom Jones
Date

verbicher
Planners | engineers | advisors
REDBULLING - MADISON - PARADE DU CHEN
136 W. Sycamore Ave P.O. 542, Wisconsin 53821
Phone: (608) 224-1191 Fax: (608) 224-1022



933.03'
897.46'
S00°15'39"E