


PLAT OF SURVEY

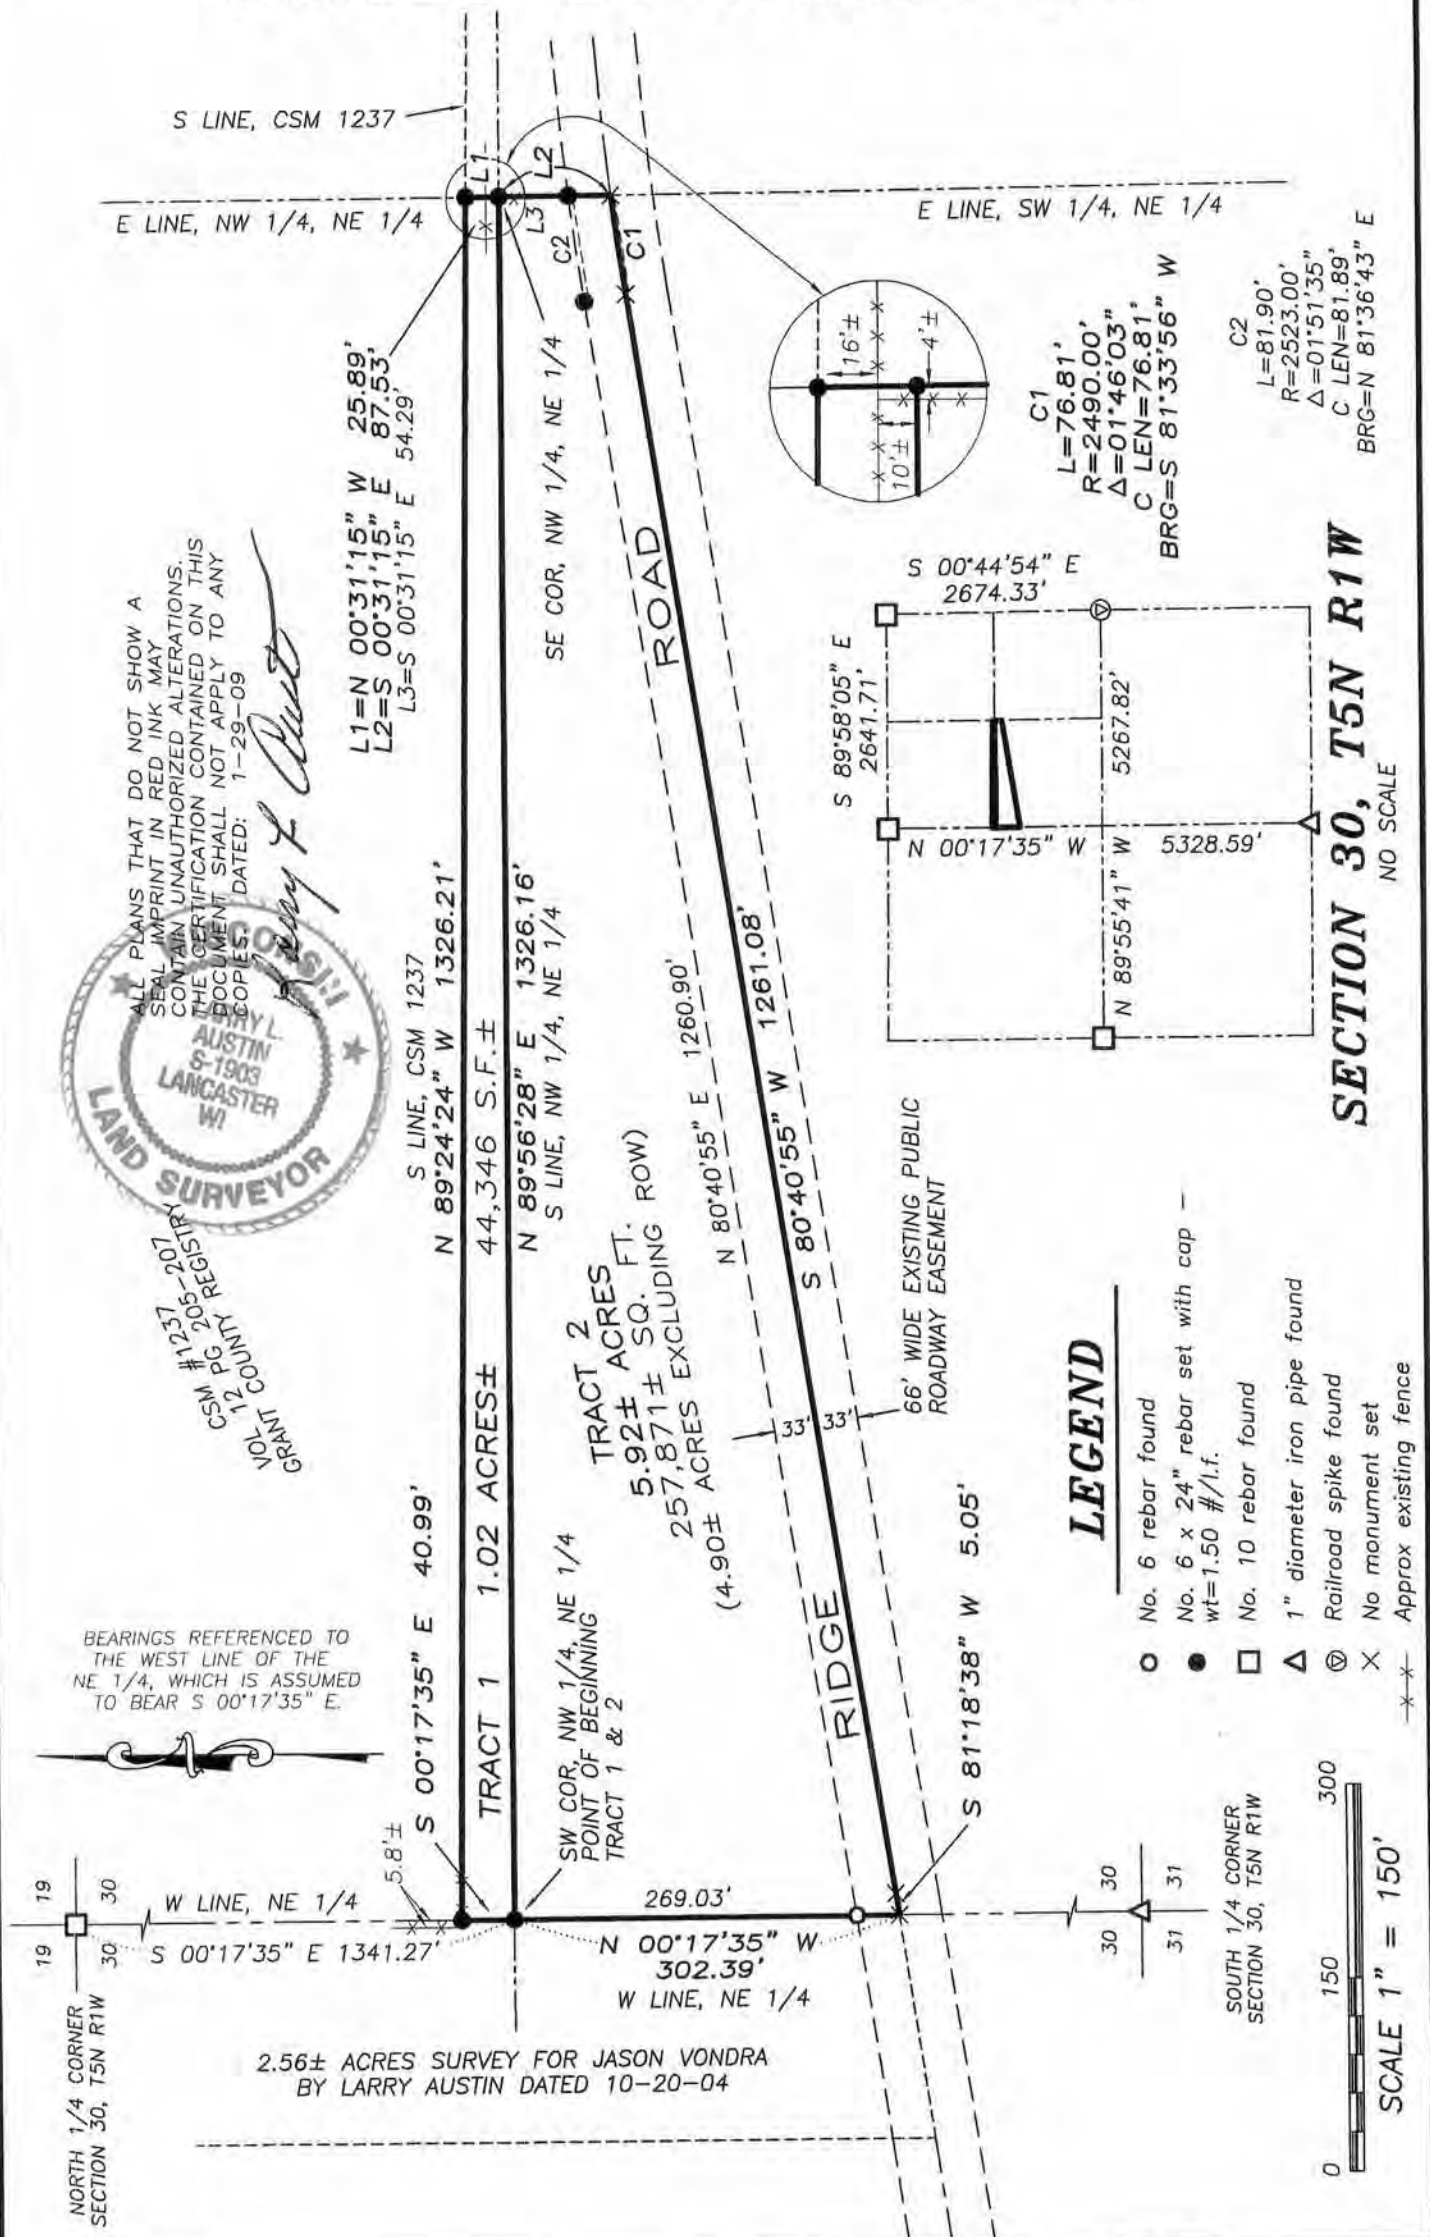

PLAT OF SURVEY

TRACT 1 DESCRIPTION:

Part of the Northwest Quarter (NW 1/4) of the Northeast Quarter (NE 1/4) of Section Thirty (30), Township Five (5) North, Range One (1) West of the 4th p.m., Clifton Township, Grant County, Wisconsin; containing 1.02 acres, more or less, and being described as follows:

Commencing at the North Quarter (N 1/4) corner of said Section Thirty (30); thence South 00°17'35" East 1341.27' along the West line of the Northeast Quarter (NE 1/4) of said Section Thirty (30) to the Southwest corner of the Northwest Quarter (NW 1/4) of the Northeast Quarter (NE 1/4) of said Section Thirty (30), said corner being the point of beginning; thence North 89°56'28" East 1326.16' on the South line of the Northwest Quarter (NW 1/4) of the Northeast Quarter (NE 1/4) of said Section Thirty (30) to the Southeast corner thereof; thence North 00°31'15" West 25.89' along the East line of the Northwest Quarter (NW 1/4) of the Northeast Quarter (NE 1/4) to a point on the South line of Certified Survey Map No. 1237; thence North 89°24'24" West 1326.21' along said South line to a point on the West line of the Northeast Quarter (NE 1/4); thence South 00°17'35" East 40.99' along said West line to the point of beginning, being subject to any and all easements of record and/or usage.

TRACT 2 DESCRIPTION:

Part of the Southwest Quarter (SW 1/4) of the Northeast Quarter (NE 1/4) of Section Thirty (30), Township Five (5) North, Range One (1) West of the 4th p.m., Clifton Township, Grant County, Wisconsin; containing 5.92 acres, more or less, and being described as follows:

Commencing at the North Quarter (N 1/4) corner of said Section Thirty (30); thence South 00°17'35" East 1341.27' along the West line of the Northeast Quarter (NE 1/4) of said Section Thirty (30) to the Southwest corner of the Northwest Quarter (NW 1/4) of the Northeast Quarter (NE 1/4) of said Section Thirty (30), said corner being the point of beginning; thence North 89°56'28" East 1326.16' along the South line of the Northwest Quarter (NW 1/4) of the Northeast Quarter (NE 1/4) to the Southeast corner thereof; thence South 00°31'15" East 87.53' along the East line of the Southwest Quarter (SW 1/4) of the Northeast Quarter (NE 1/4) of said Section Thirty (30) to a point in the centerline of a township road known as Ridge Road; thence 76.81' on the arc of a curve to the left having a radius of 2490.00' and a long chord bearing South 81°33'56" West 76.81' along said centerline; thence South 80°40'55" West 1261.08' along said centerline; thence South 81°18'38" West 5.05' along said centerline to a point on the West line of the Northeast Quarter (NE 1/4); thence North 00°17'35" West 302.39' along said West line to the point of beginning, being subject to any and all easements of record and/or usage.

SURVEYOR'S CERTIFICATE:

I, Larry L. Austin, Registered Wisconsin Land Surveyor, hereby certify:

That the above description was surveyed, mapped and monumented as shown on this plat by me or under my direct supervision.

That conformance with local ordinances are not guaranteed with this survey.


That this survey was prepared under the instructions of DAVID DANZ.

That to the best of my knowledge and belief, this plat is an accurate representation thereof.

That all plans that do not show a seal imprint in red ink may contain unauthorized alterations.


The certification contained on this document shall not apply to any copies.

Dated this 29th day of January, 2010.

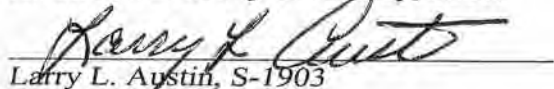
Larry L. Austin, S-1903

SURVEYOR'S NOTES:

Surveyor has made no investigation for easements of record, encumbrances, restrictive covenants, ownership title evidence except as specifically shown on this plat. No distance should be assumed by scaling. No improvements have been located unless shown and noted. No representation as to ownership, use or possession should be hereon implied. Refer to abstract, title or local ordinances for any additional restriction, easements or building setback lines. No abstract, nor title commitment, nor results of title searches were furnished the surveyor.

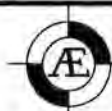

Austin
Engineering LLC
austinengineeringllc.com

4211 HWY 81 E, LANCASTER, WI 53813
PHONE: 608-723-6363 FAX: 608-723-6702

Prepared for: DAVID DANZ

JOB NO: 10S013-DANZ
FIELDBOOK: TDS RANGER
G:\T5NR1W\32
H:\PLAT\T5NR1W\30\10S013-DANZ

DRAWN BY: SW AUSTIN
APPROVED: LL AUSTIN
CREW: BS-SA-SB-BD

SHEET 2 OF 2