

PLAT OF RESURVEY

REFERENCE LINE SURVEYED:

The East line of the Northeast Quarter (NE 1/4) of the Southeast Quarter (SE 1/4) of Section Seven (7), Township Two (2) North, Range One (1) West of the 4th P.M., Town of Smelser, Grant County, Wisconsin, said line being described as follows:

Commencing at the East Quarter (E 1/4) corner of said Section 7;
thence South 00° 11' 07" West 585.43 feet along the East line of said Section to the point of beginning;
thence South 00° 11' 07" West 726.37 feet along said East line to the terminus point.

SURVEYOR'S CERTIFICATE:

I, Larry L. Austin, Registered Wisconsin Land Surveyor, hereby certify:

That the above description was surveyed, mapped and monumented as shown on this plat by me or under my direct supervision.

That conformance with local ordinances are not guaranteed with this survey.

That this survey was prepared under the instructions of John Streich.
That to the best of my knowledge and belief, this plat is an accurate representation thereof.

That all plans that do not show a seal imprint in red ink may contain unauthorized alterations.


The certification contained on this document shall not apply to any copies.

Dated this 21st day of April, 2010.

Larry L. Austin
Larry L. Austin, S-1903



The South line of the SE 1/4 of Section 7 is assumed to bear S 00°11'07" W.

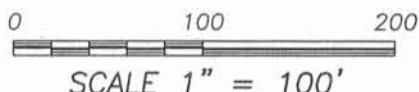

LOT 1
CSM NO. 1465


EAST LINE
NE 1/4, SE 1/4

LOT 1
CSM NO. 1159

SOUTH LINE
LOT 1, CSM NO. 1465

SOUTHEAST CORNER
NE 1/4, SE 1/4
TERMINUS POINT
REFERENCE LINE

SOUTHEAST CORNER
SECTION 7, T2N R1W

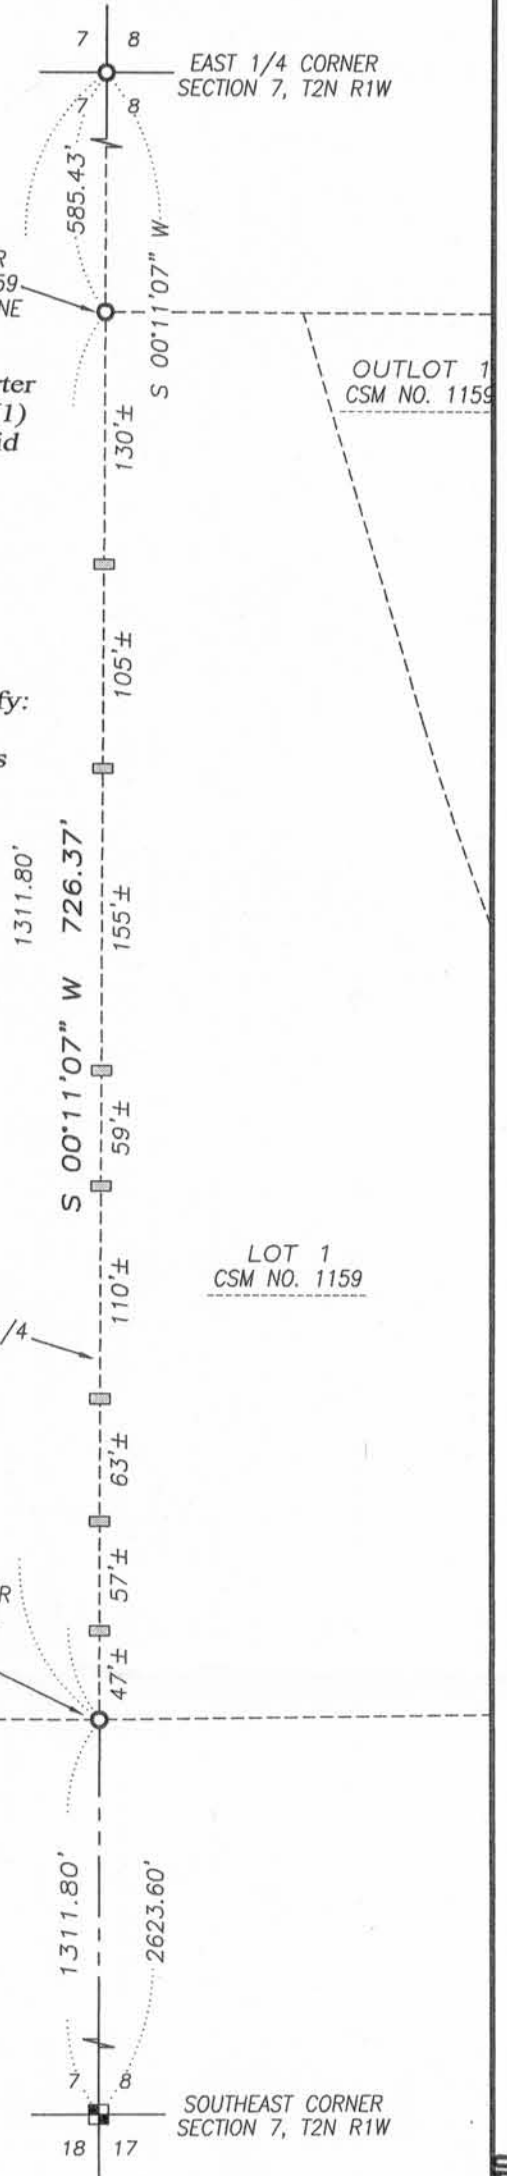

Austin
Engineering LLC
austinengineeringllc.com

4211 HWY 81 E, LANCASTER, WI 53813
PHONE: 608-723-6363 FAX: 608-723-6702

Prepared for: **JOHN STREICH**

JOB NO: 10s096
FIELDBOOK: TDS RANGER
G:\T2NR1W\17
H:\PLAT\T2NR1W\07\10s096-STREICH

DRAWN BY: AJ AUSTIN
APPROVED: LL AUSTIN
CREW: SB-BD

SHEET 1 OF 1

APR 22 2010