


PREVIOUS SURVEY
BY LARRY AUSTIN
DATED 1-14-2002

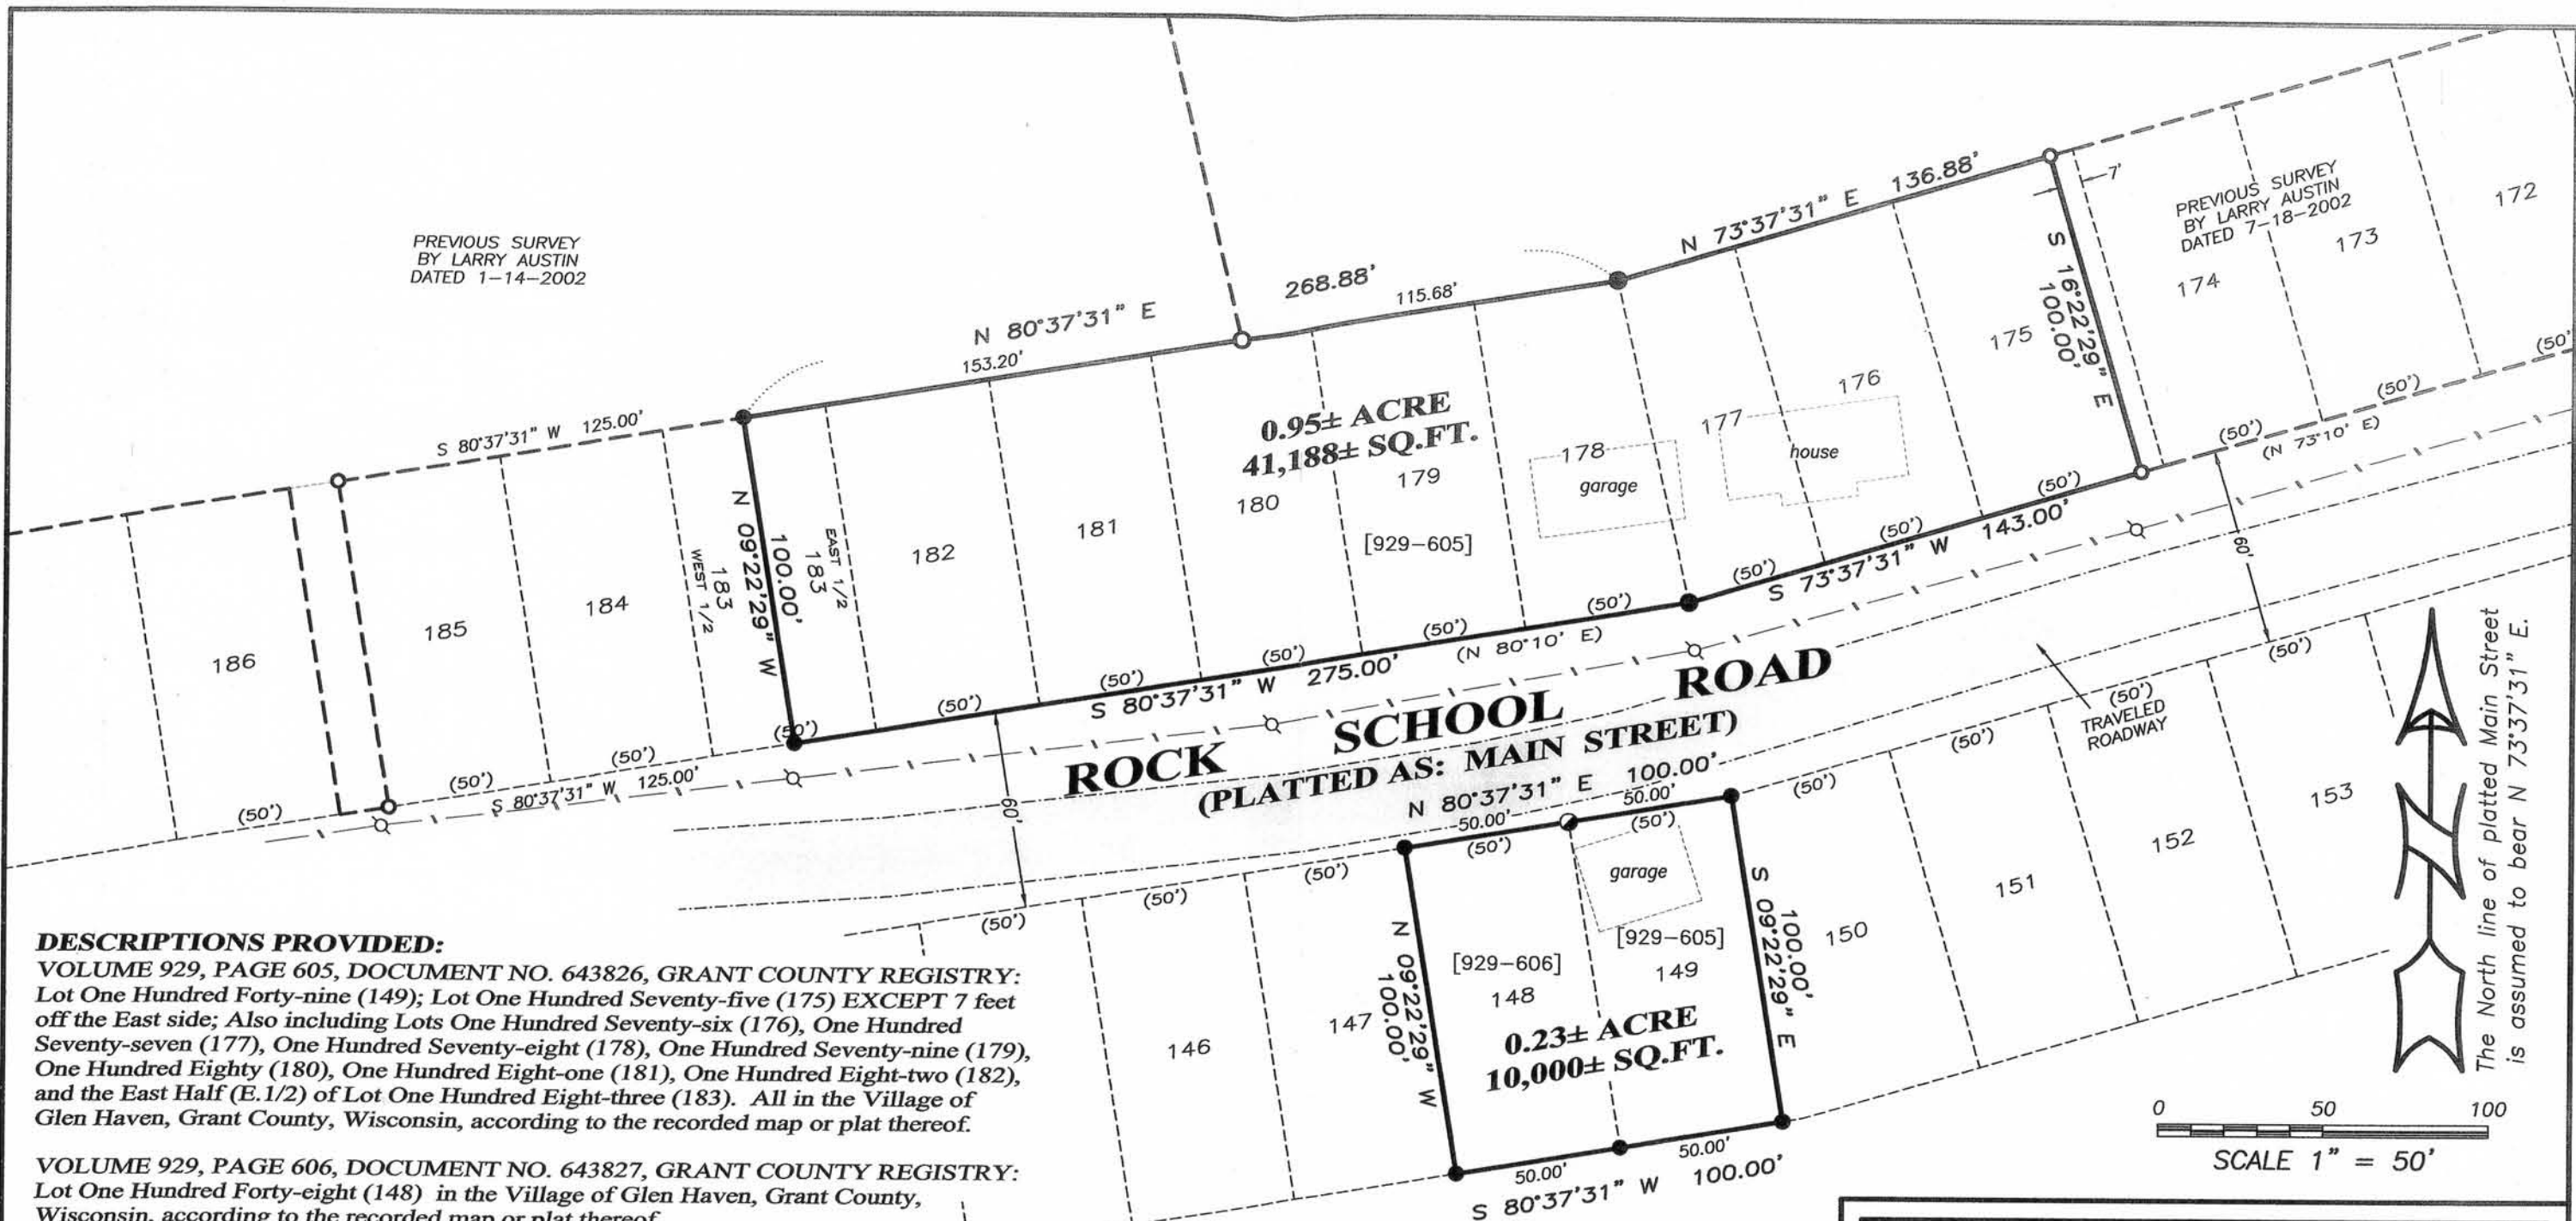

DESCRIPTIONS PROVIDED:

VOLUME 929, PAGE 605, DOCUMENT NO. 643826, GRANT COUNTY REGISTRY:
Lot One Hundred Forty-nine (149); Lot One Hundred Seventy-five (175) EXCEPT 7 feet off the East side; Also including Lots One Hundred Seventy-six (176), One Hundred Seventy-seven (177), One Hundred Seventy-eight (178), One Hundred Seventy-nine (179), One Hundred Eighty (180), One Hundred Eight-one (181), One Hundred Eight-two (182), and the East Half (E.1/2) of Lot One Hundred Eight-three (183). All in the Village of Glen Haven, Grant County, Wisconsin, according to the recorded map or plat thereof.

VOLUME 929, PAGE 606, DOCUMENT NO. 643827, GRANT COUNTY REGISTRY:
Lot One Hundred Forty-eight (148) in the Village of Glen Haven, Grant County, Wisconsin, according to the recorded map or plat thereof.

SURVEYOR'S CERTIFICATE:

I, Larry L. Austin, Registered Wisconsin Land Surveyor, hereby certify:
That the above descriptions were surveyed, mapped and monumented as shown on this plat by me or under my direct supervision.
That this survey was prepared under the instructions of Mark Schleicher.
That to the best of my knowledge and belief, this plat is an accurate representation thereof.
Dated this 31st day of March, 2010.

Larry L. Austin
Larry L. Austin, S-1903

ALL PLANS THAT DO NOT SHOW A SEAL
IMPRINT IN RED INK MAY CONTAIN
UNAUTHORIZED ALTERATIONS.
THE CERTIFICATION CONTAINED ON THIS
DOCUMENT SHALL NOT APPLY TO ANY COPIES.



LEGEND

- No. 6 rebar found
- No. 6 x 24" rebar set with cap
- ⊙ 1/2" x 4 3/4" Cotton Spindle set
- ⊘ Existing Utility Pole
- Overhead Utility Line
- + No monument set
- () Recorded as
- [-] Property described in Volume and Page, Grant County Registry

PLAT OF SURVEY

PREPARED FOR: MARK SCHLEICHER
LOCATED IN THE MAP OF GLEN HAVEN,
GRANT COUNTY, WISCONSIN



4211 HWY 81 E
LANCASTER, WI 53813
PHONE 608-723-6363
FAX 608-723-6702

JOB NO: 10s020
FIELDBOOK: TDSR
G:\T4NR6W\15
H:\PLAT\GlenHaven\10s020-SCHLEICHER

DRAWN BY: AJ AUSTIN
APPROVED: LL AUSTIN
CREW: BS-SA-BD

SHEET 1 OF 1