


FOUNDATION SURVEY

Foundation Survey for Lot 17, Certified Survey Map No. 589, recorded in Volume 4 of Certified Survey Maps on Page 213 as Document No. 615436, Grant County Registry, being located in the SW 1/4 of the NE 1/4 of Section 26, T3N R4W of the 4th P.M., Grant County, Wisconsin

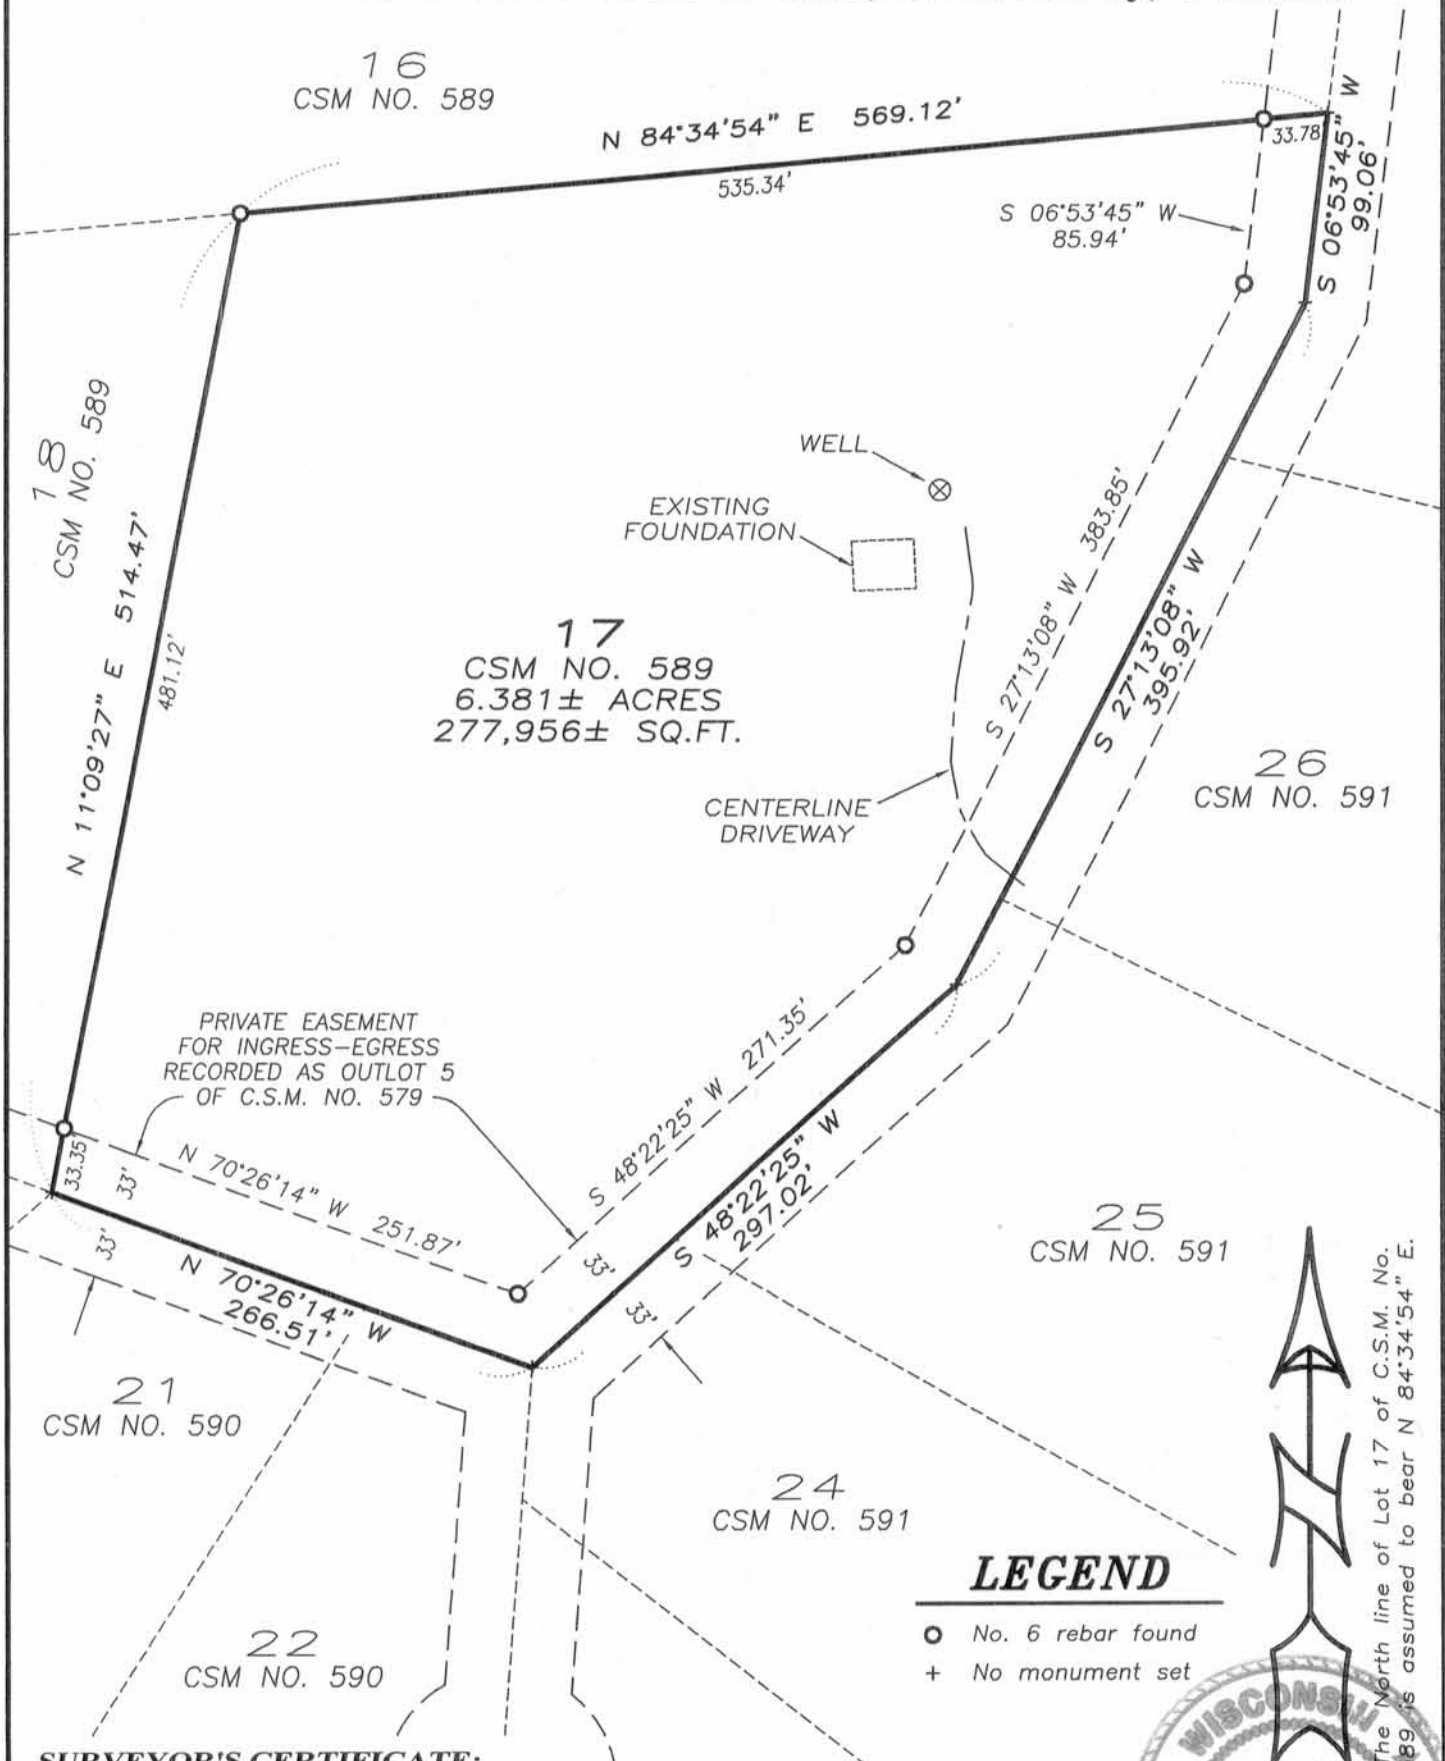

SURVEYOR'S CERTIFICATE:

I, Larry L. Austin, Registered Wisconsin Land Surveyor, hereby certify:

That this Foundation Survey was surveyed and mapped as shown on this plat by me or under my direct supervision, all in accordance to the instructions of Linda Poss, Vice President/Branch Manager of United Bank, Ettrick Office and to the best of my knowledge and belief, this plat is an accurate representation thereof.

Dated this 16th day of April, 2010.

Larry L. Austin
Larry L. Austin, S-1903

That all plans that do not show a seal imprint in red ink may contain unauthorized alterations. The certification contained on this document shall not apply to any copies.

0 100 200
SCALE 1" = 100'



Austin
Engineering LLC
austineengineeringllc.com

Prepared for: UNITED BANK

JOB NO: 10s090
FIELDBOOK: 2911
G:\H:\PLAT\T3NR4W\26\10s090-United Bank

DRAWN BY: AJ AUSTIN
APPROVED: LL AUSTIN
CREW: SB-BD

SHEET 1 OF 1

APR 22 2010