


PLAT OF SURVEY

Right of Way established from Conveyance of Lands for Highway Purposes recorded in Volume 1 of Highway Conveyances, Page 386 as Doc. No. 75687, Grant County Registry and Plat of Right of Way Project No. 376C and 208 Re.

ALL PLANS THAT DO NOT SHOW A SEAL IMPRINT IN RED INK MAY CONTAIN UNAUTHORIZED ALTERATIONS. THE CERTIFICATION CONTAINED ON THIS DOCUMENT SHALL NOT APPLY TO ANY COPIES. DATED: 5-4-2010.

Randy L. Austin

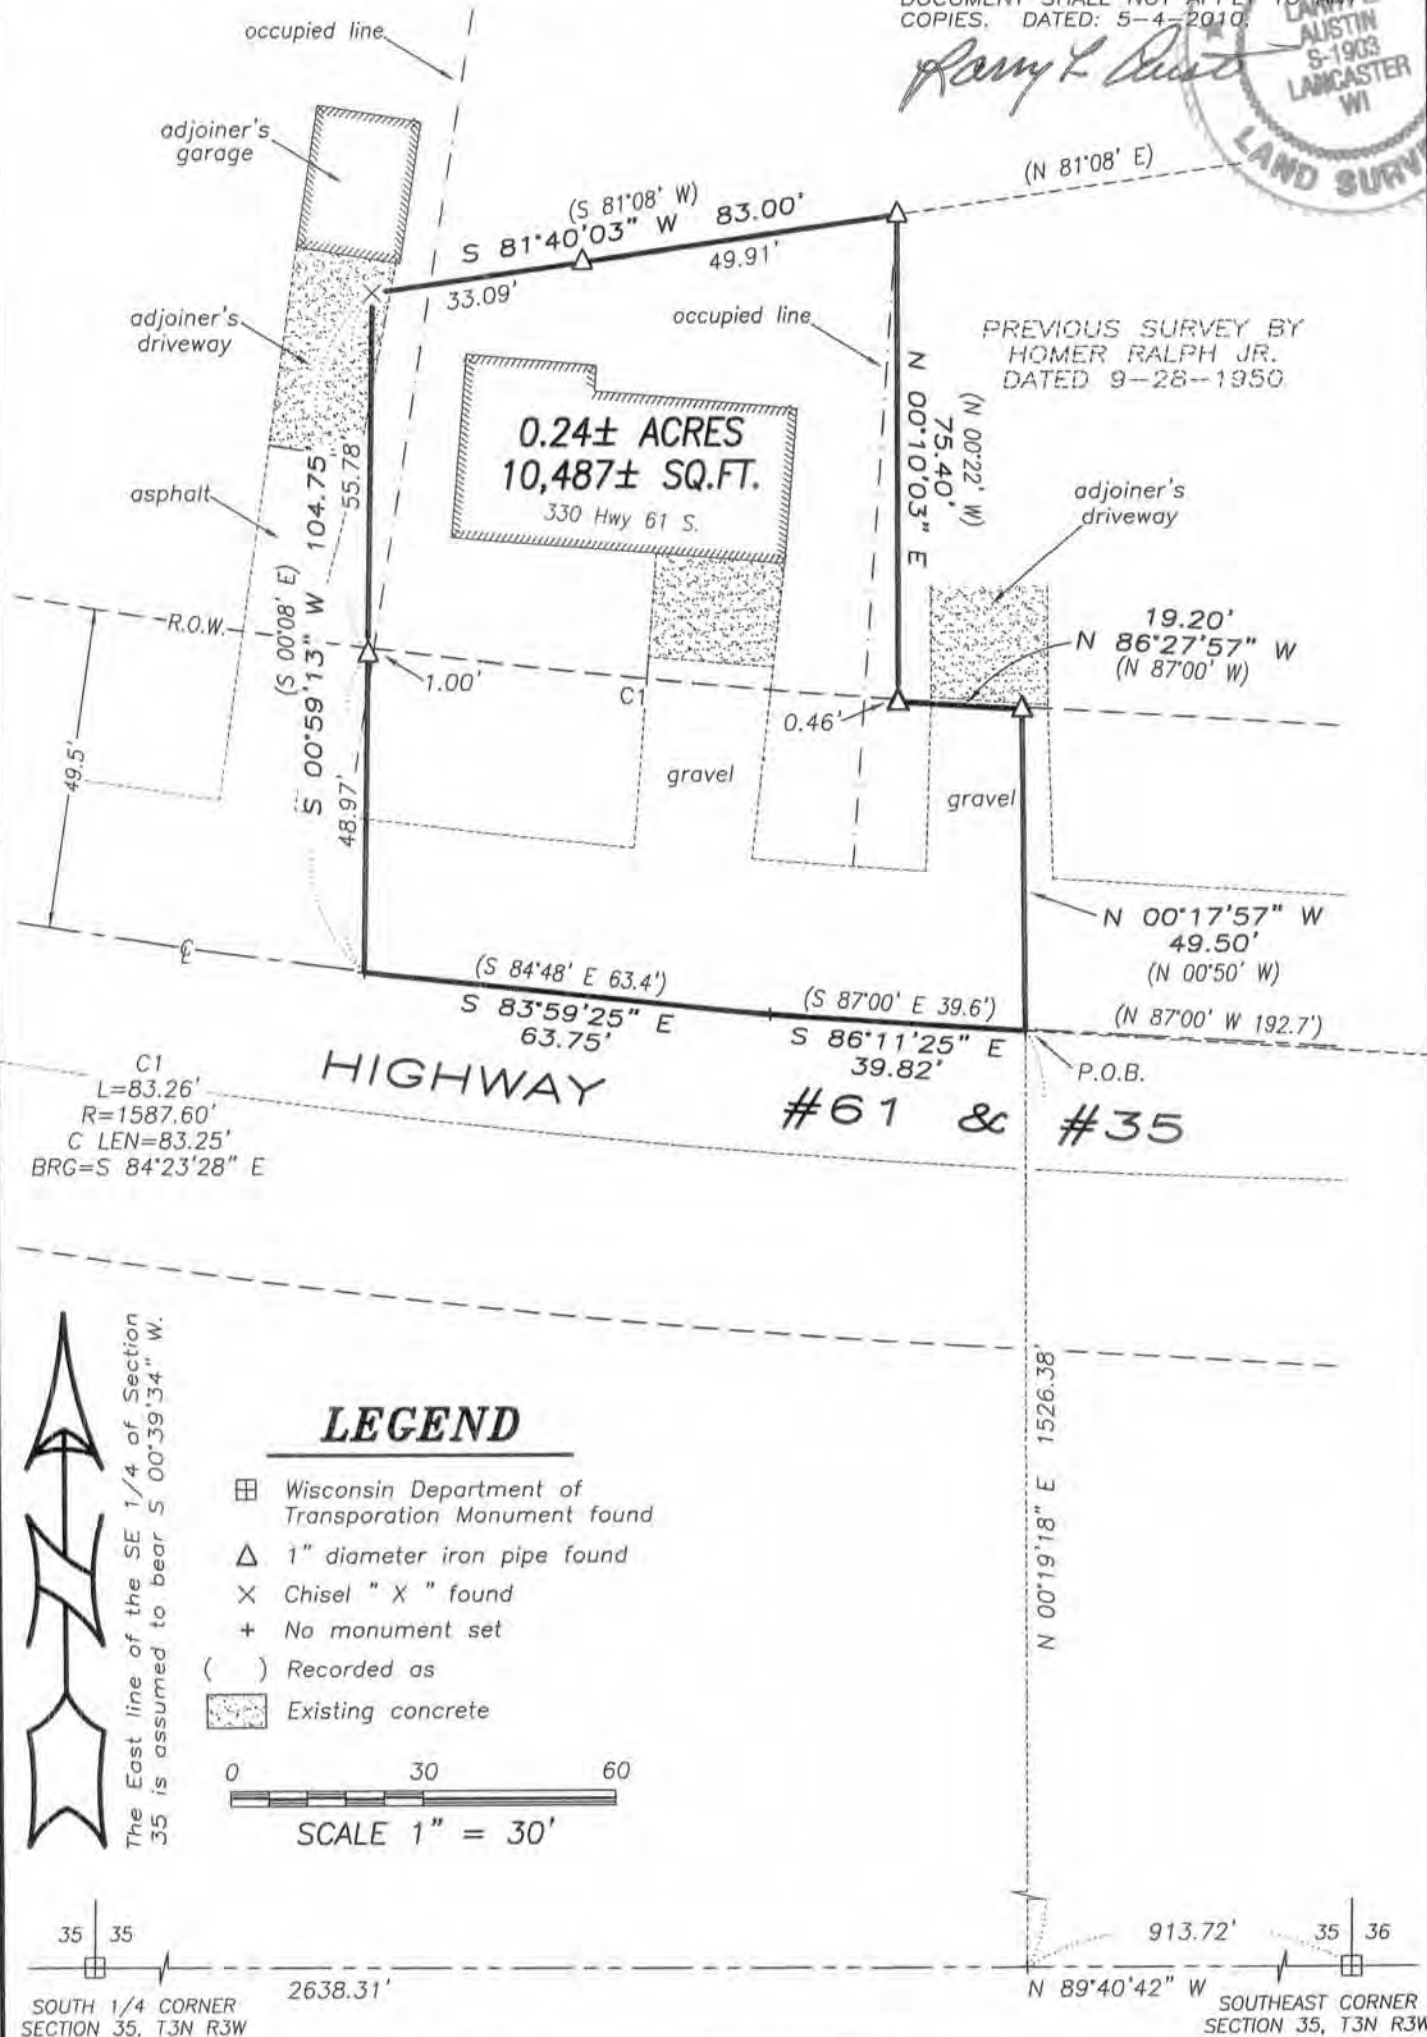

The East line of the SE 1/4 of Section 35 is assumed to bear S 00°39'34" W.

Prepared for: KATHY MURDOCK



Austin Engineering LLC
austineengineeringllc.com

4211 HWY 81 E, LANCASTER, WI 53813
PHONE: 608-723-6363 FAX: 608-723-6702

JOB NO: 10s076
FIELDBOOK: TDS RANGER
G:\POTOSI\POTOSI
H:\PLAT\TENNYSON\10s076-MURDOCK

DRAWN BY: AJ AUSTIN
APPROVED: LL AUSTIN
CREW: BS-SA-BD

SHEET 1 OF 2

MAY 26 2010

PLAT OF SURVEY

DESCRIPTION PROVIDED:

Part of Lots 38 and 44 of the Subdivision of Section 35, T 3 N, R 3 W of the 4th P.M., Village of Tennyson, Grant County, Wisconsin, described as follows, to-wit:
Commence at the East 1/4 corner of said Section 35;
thence South 1379.4 feet;
thence North 68° 00' West 608.5 feet to a point on the centerline of U.S. Highway #61;
thence North 82° 29' West 168.1 feet along said centerline;
thence North 87° 00' West 192.7 feet along said centerline to the place of beginning;
thence North 00° 50' West 49.5 feet;
thence North 87° 00' West 19.2 feet;
thence North 00° 22' West 75.4 feet;
thence South 81° 08' West 83 feet;
thence South 00° 08' East 104.75 feet to a point on said centerline;
thence South 84° 48' East 63.4 feet along said centerline;
thence South 87° 00' East 39.6 feet along said centerline to the place of beginning.

SURVEYOR'S CERTIFICATE:

I, Larry L. Austin, Registered Wisconsin Land Surveyor, hereby certify:

That the above description was surveyed, mapped and monumented as shown on this plat by me or under my direct supervision.

That conformance with local ordinances are not guaranteed with this survey.


That this survey was prepared under the instructions of Kathy Murdock.

That to the best of my knowledge and belief, this plat is an accurate representation thereof.

That all plans that do not show a seal imprint in red ink may contain unauthorized alterations.

The certification contained on this document shall not apply to any copies.

Dated this 4th day of May, 2010.

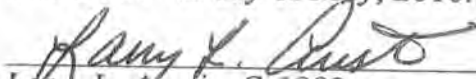
Larry L. Austin, S-1903



SURVEYOR'S NOTES:

Surveyor has made no investigation for easements of record, encumbrances, restrictive covenants, ownership title evidence except as specifically shown on this plat. No distance should be assumed by scaling. No improvements have been located unless shown and noted. No representation as to ownership, use or possession should be hereon implied. Refer to abstract, title or local ordinances for any additional restriction, easements or building setback lines. No abstract, nor title commitment, nor results of title searches were furnished the surveyor.



Austin

Engineering LLC

austinengineeringllc.com

4211 HWY 81 E, LANCASTER, WI 53813
PHONE: 608-723-6363 FAX: 608-723-6702

Prepared for: KATHY MURDOCK

JOB NO: 10s076
FIELDBOOK: TDS RANGER
G:\POTOSI\POTOSI
H:\PLAT\TENNYSON\10s076-MURDOCK

DRAWN BY: AJ AUSTIN
APPROVED: LL AUSTIN
CREW: BS-SA-BD

SHEET 2 OF 2