


PREPARED BY: IIV ENGINEERS & SURVEYORS P.C. 4155 PENNSYLVANIA AVE, DUBUQUE, IOWA, (563) 556-2464

PLAT OF SURVEY

LOT 3 IN BLOCK 6 WEST OF EDWARD'S ADDITION TO THE VILLAGE OF LOWER HAZEL GREEN, GRANT COUNTY, WISCONSIN

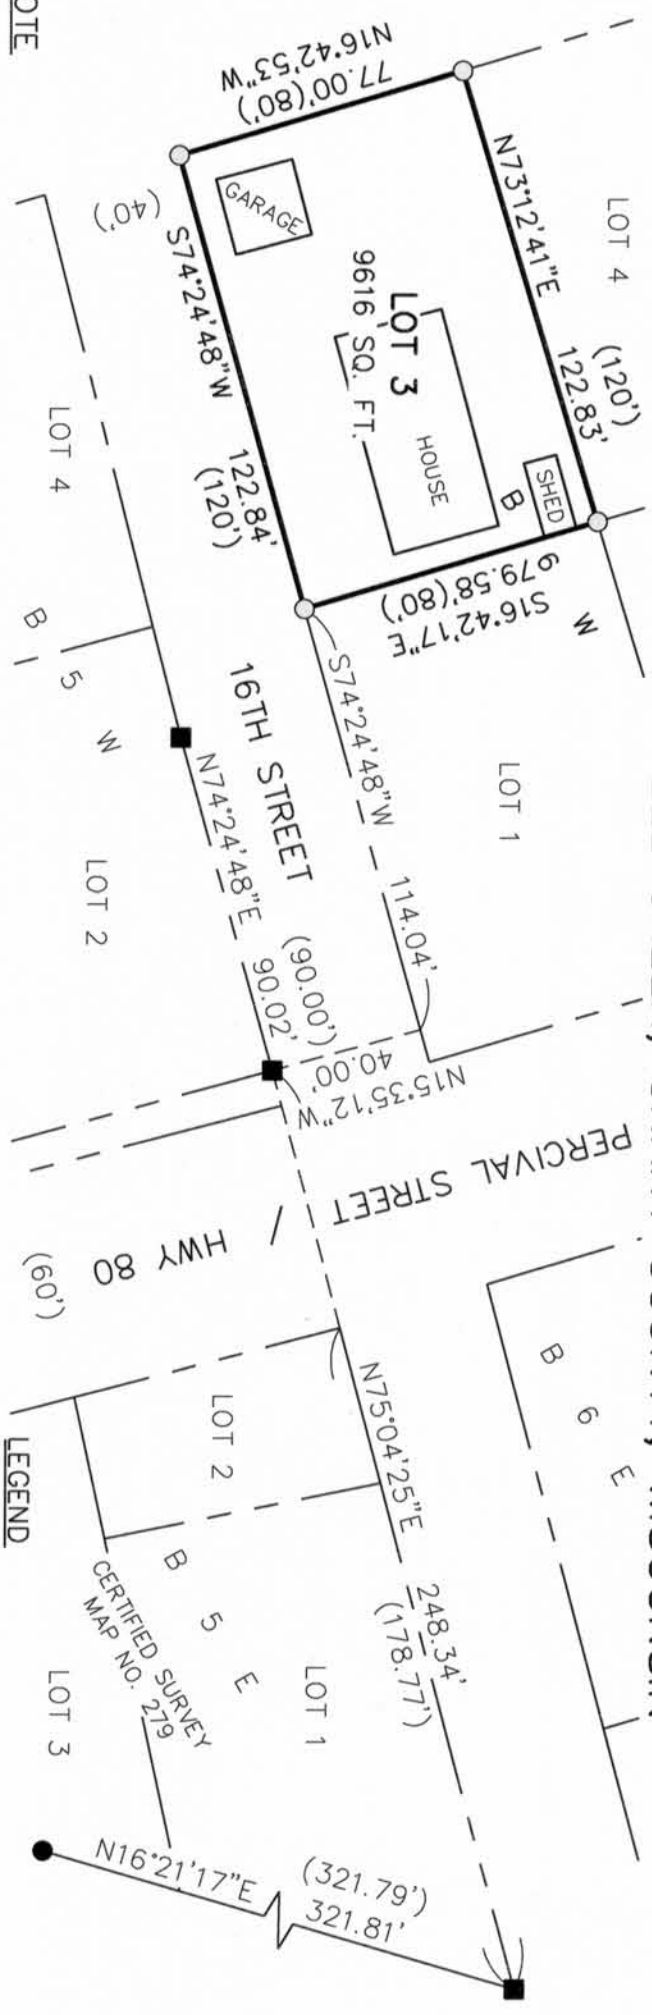

NOTE

THIS SURVEY IS SUBJECT TO EASEMENTS, RESERVATIONS, RESTRICTIONS AND RIGHTS-OF-WAY OF RECORD AND NOT OF RECORD. BEARINGS ARE BASED ON AN ASSUMED BEARING SYSTEM.

DESCRIPTION: LOT 3 IN BLOCK 6 WEST OF EDWARD'S ADDITION TO THE VILLAGE OF LOWER HAZEL GREEN, GRANT COUNTY, WISCONSIN

PROPRIETOR: TERRY E. STASKAL
SURVEYED FOR: TERRY STASKAL
DATE OF SURVEY: MAY, 2010


TOTAL AREA SURVEYED: 9616 SQ. FT.

LEGEND

- PLAT BOUNDARY
- DIMENSION LINE
- FOUND 3/4" IRON ROD
- FOUND 1" IRON PIPE
- SET 3/4" x 24" IRON ROD
- WEIGHING 1.50 LBS/LINEAR FOOT
- RECORD INFORMATION



GRAPHIC SCALE

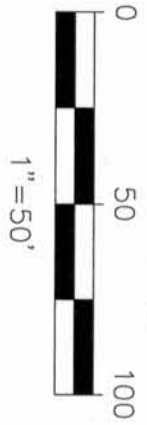

DRAWING MAY HAVE BEEN REDUCED



I HEREBY CERTIFY THAT THE ABOVE DESCRIPTION WAS SURVEYED, MAPPED, AND MONUMENTED AS SHOWN ON THIS PLAT BY ME OR UNDER MY DIRECT SUPERVISION AND THAT TO THE BEST OF MY KNOWLEDGE AND BELIEF, THIS PLAT IS AN ACCURATE REPRESENTATION THEREOF.
FOR IIV ENGINEERS & SURVEYORS, P.C.
JOHN M. TRANNER
REGISTERED LAND SURVEYOR NO. 2215-008
PAGES OR SHEETS COVERED BY THIS SEAL THIS SHEET ONLY
DATE 6/23/10



IIV ENGINEERS & SURVEYORS, P.C. INTEGRITY. EXPERTISE. SOLUTIONS. DUBUQUE, IA HAZEL GREEN, WI 4155 PENNSYLVANIA AVE. DUBUQUE, IA 52002 VOICE (563) 556-2464 FAX (563) 556-7811 www.iivengr.com			
DRAWN	ARC	PLAT NO.	1-W-10
CHECKED	JMT	PROJ. NO.	10712
DATE	06-23-10	SHEET	1 of 1

JUN 23 2010