



PLAT OF SURVEY

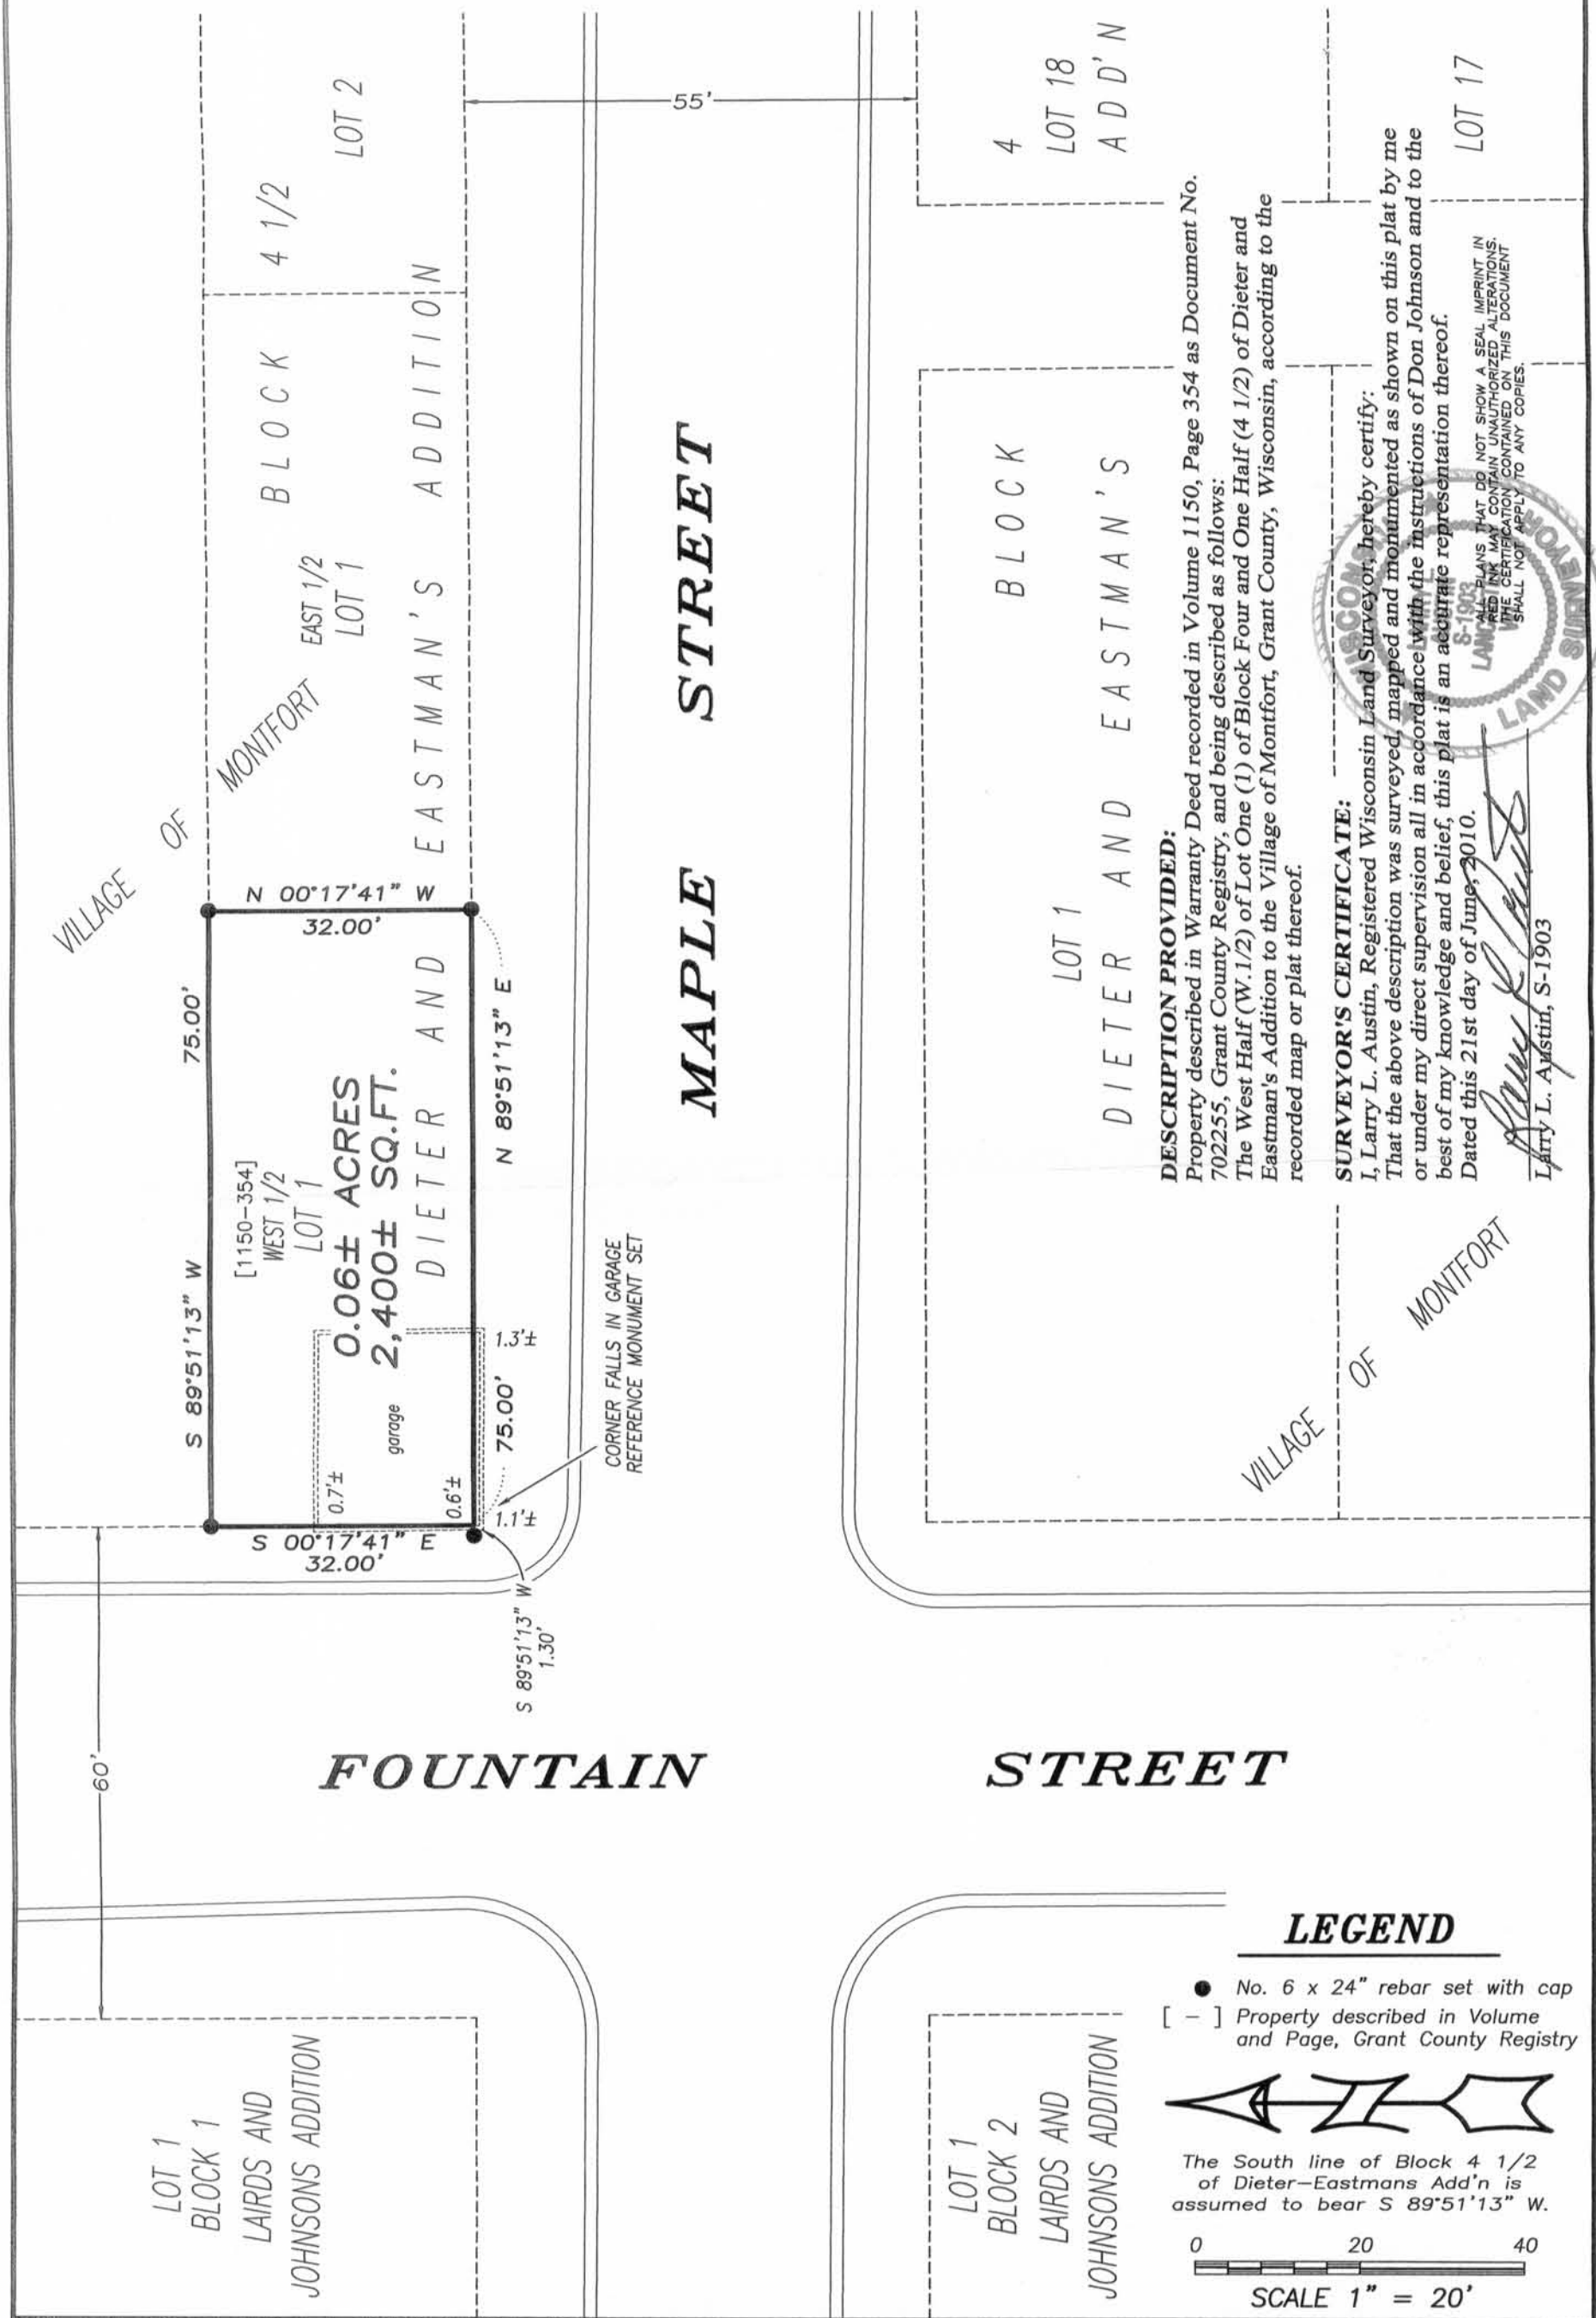

DESCRIPTION PROVIDED:
Property described in Warranty Deed recorded in Volume 1150, Page 354 as Document No. 702255, Grant County Registry, and being described as follows:
The West Half (W. 1/2) of Lot One (1) of Block Four and One Half (4 1/2) of Dieter and Eastman's Addition to the Village of Montfort, Grant County, Wisconsin, according to the recorded map or plat thereof.

SURVEYOR'S CERTIFICATE:
I, Larry L. Austin, Registered Wisconsin Land Surveyor, hereby certify:
That the above description was surveyed, mapped and monumented as shown on this plat by me or under my direct supervision all in accordance with the instructions of Don Johnson and to the best of my knowledge and belief, this plat is an accurate representation thereof.
Dated this 21st day of June, 2010.

Larry L. Austin
Larry L. Austin, S-1903

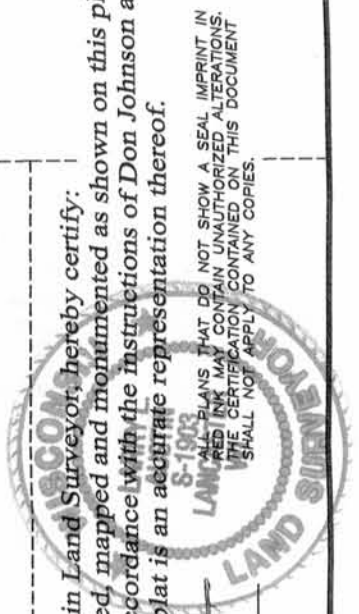

Austin Engineering LLC
austinenengineeringllc.com
4211 HWY 81 E, LANCASTER, WI 53813
PHONE: 608-723-6363 FAX: 608-723-6702

Prepared for: DON JOHNSON

JOB NO: 10s126
FIELDBOOK: 2204
G:\MONTFORT\MONTFORT
H:\PLAT\MONTFORT\Dieter & Eastman\10s126-Johnson

DRAWN BY: AJ AUSTIN
APPROVED: LL AUSTIN
CREW: BS-SB-BD

SHEET 1 OF 1

JUN 28 2010