


PLAT OF SURVEY

DESCRIPTION PROVIDED:

Property described in Volume 813, Page 706 recorded as Document No. 603911, Grant County Registry and being described as follows: Lots 12 and 13 of Weekend Retreat, a subdivision located in the Village of Bagley, Grant County, Wisconsin according to the recorded plat thereof in the office of the Register of Deeds for Grant County, Wisconsin.

LEGEND


- No. 6 x 18" rebar set with cap
- ⊙ PK Nail Set
- 60 Penny Nail Set
- ⊙ Paint Spray Mark placed
- No. 6 rebar found
- No. 10 rebar found

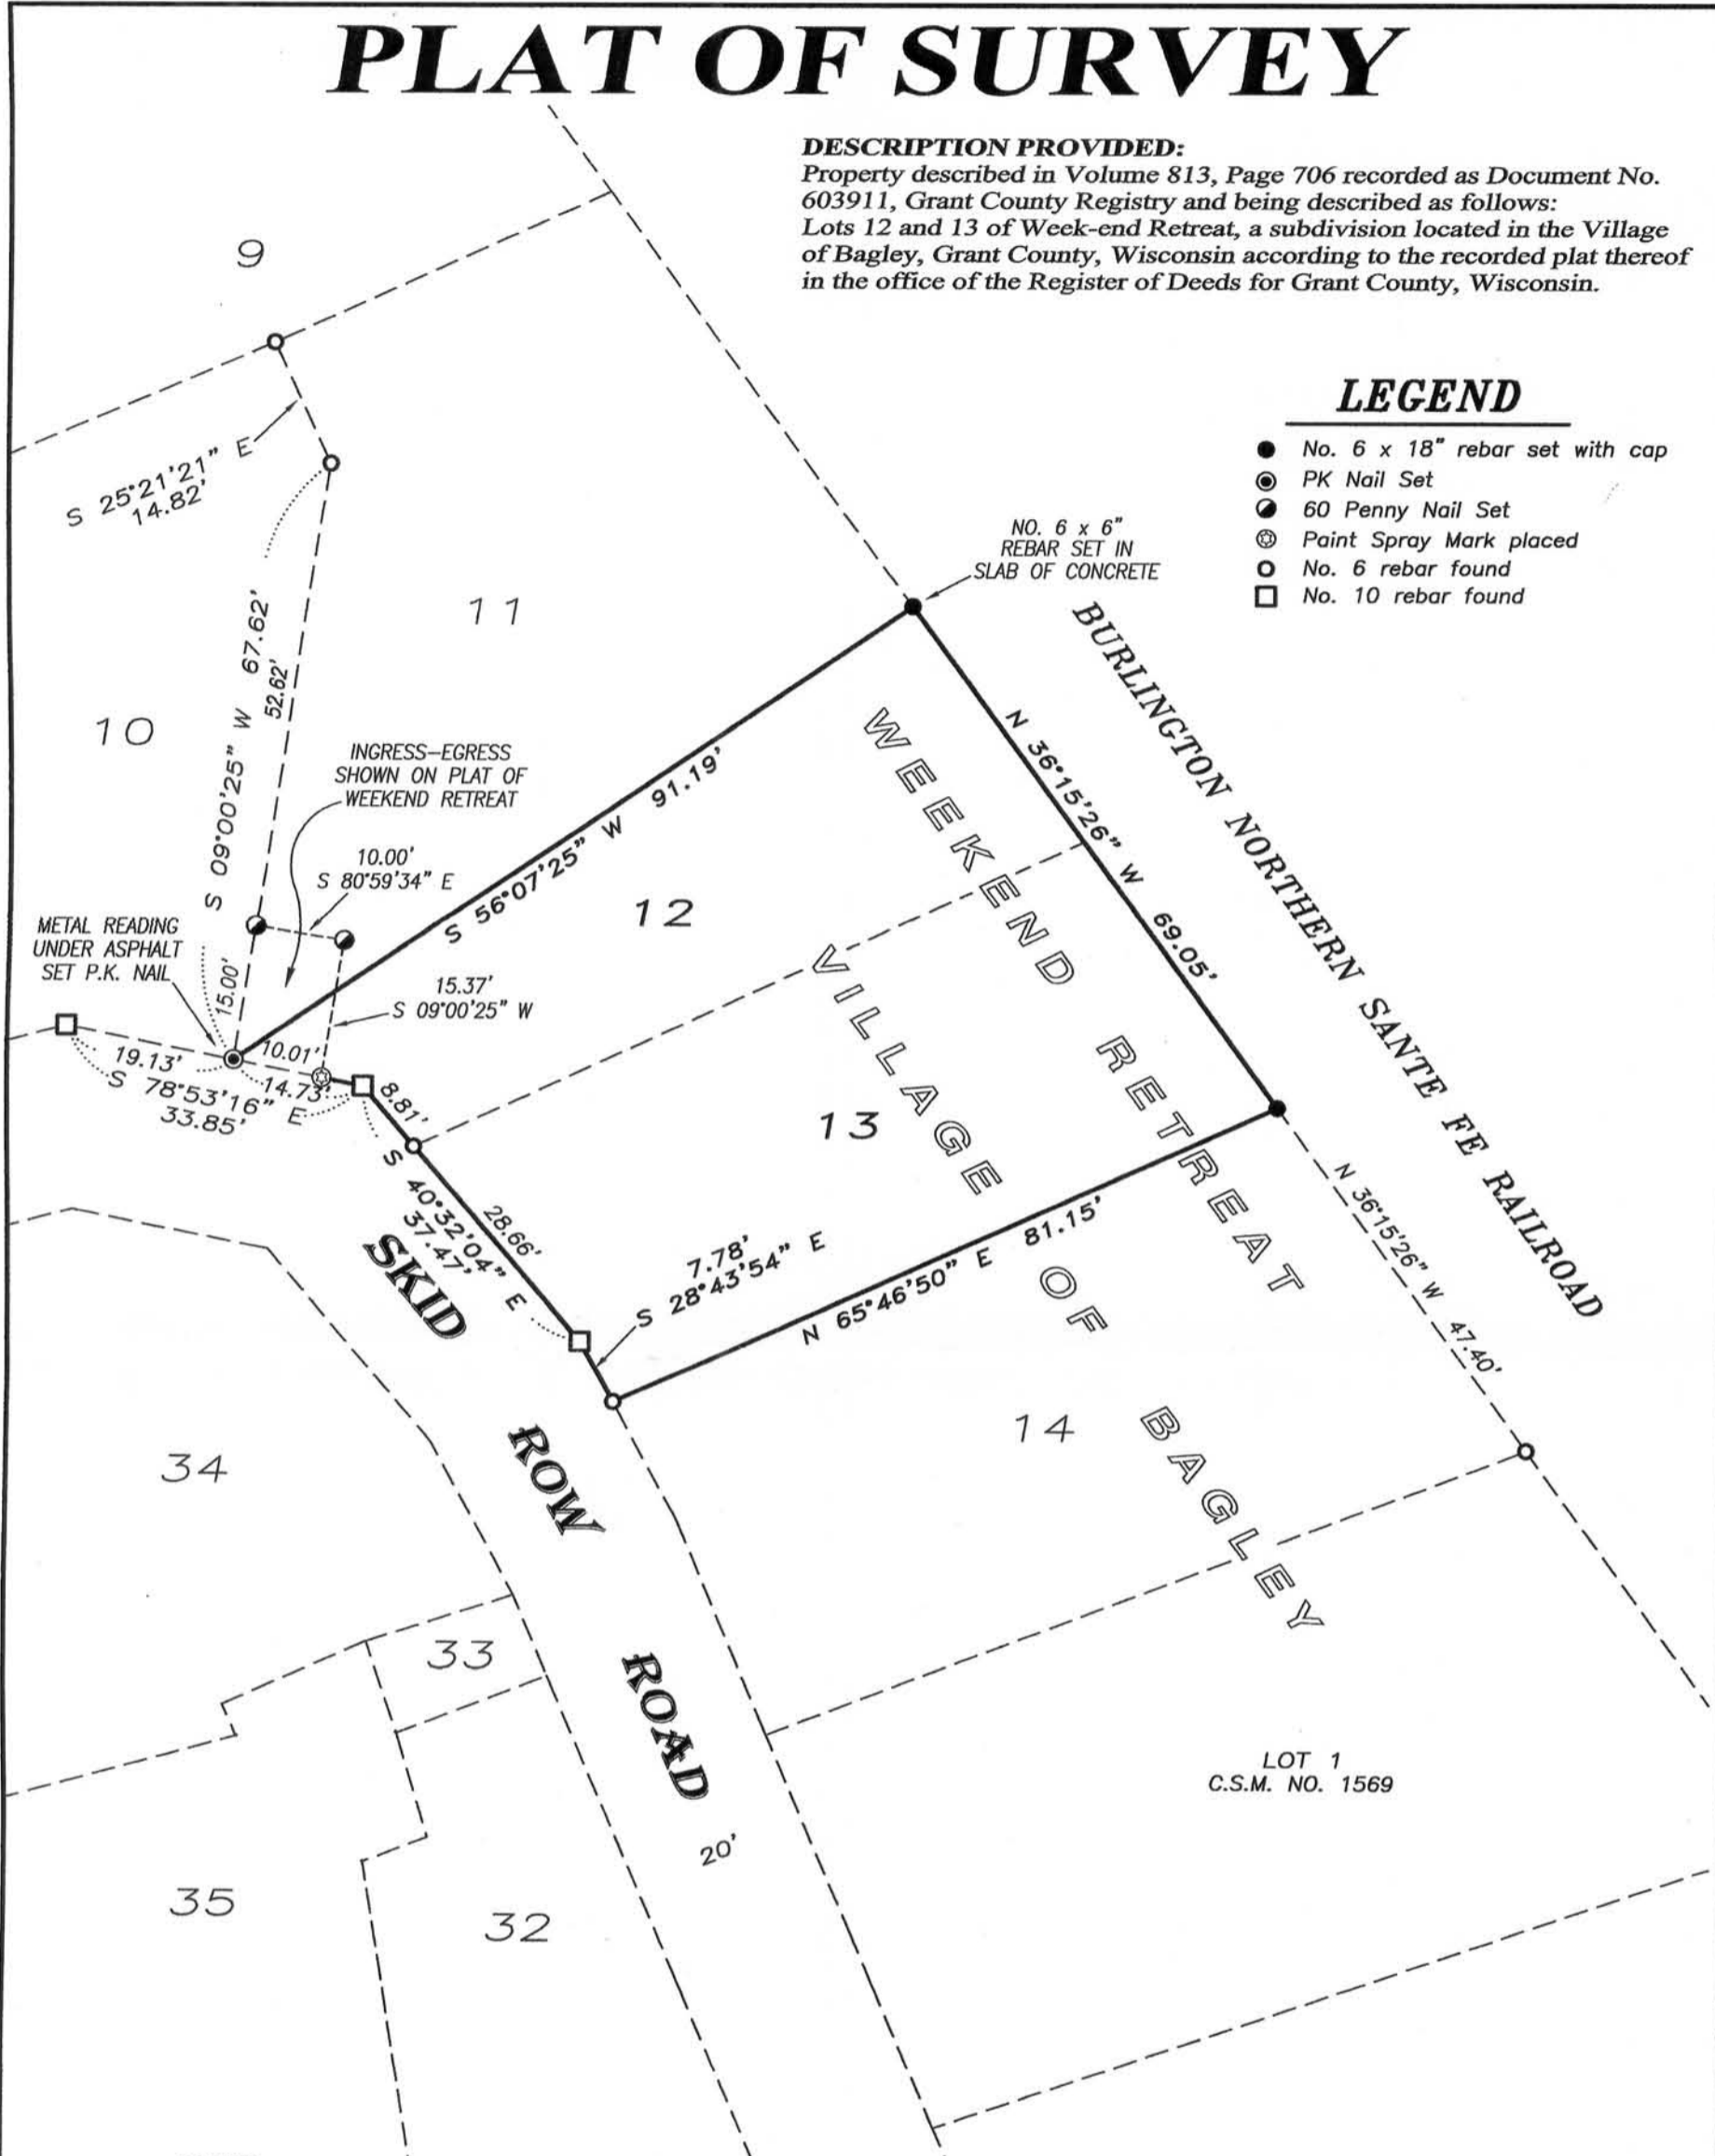


SURVEYOR'S CERTIFICATE:

I, Aaron J. Austin, Registered Wisconsin Land Surveyor, hereby certify: That the above description was surveyed, mapped and monumented as shown on this plat by me or under my direct supervision. That this survey was prepared under the instructions of Ron Roling. That to the best of my knowledge and belief, this plat is an accurate representation thereof. That all plans that do not show a seal imprint in red ink may contain unauthorized alterations. The certification contained on this document shall not apply to any copies. Dated this 19th day of June, 2012.

Aaron J. Austin
 Aaron J. Austin, S-2922

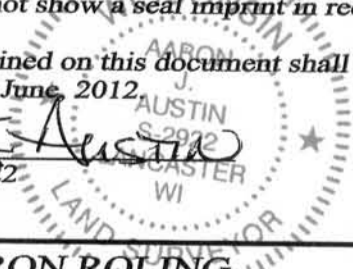

Prepared for: **RON ROLING**

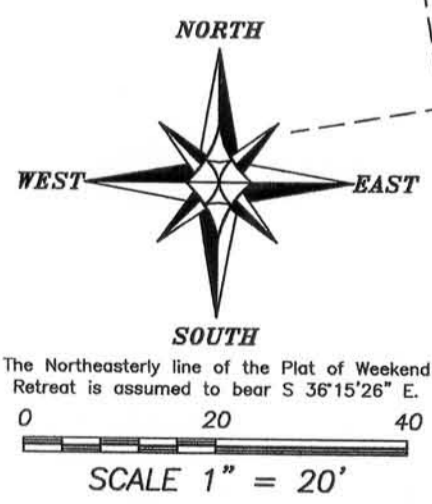

Austin Engineering LLC
 austinengineeringllc.com

4211 HWY 81 E, LANCASTER, WI 53813
 PHONE: 608-723-6363 FAX: 608-723-6702

JOB NO: 12s097
 G:\T5NR6W\21
 H:\PLAT\BAGLEY\WEEKEND\12s097-ROLING

FIELDBOOK: TDSR
 DRAWN BY: AJ AUSTIN
 CREW: BS-SB