

RETRACEMENT SURVEY

DESCRIPTION OF SURVEY:

The East line of Lot 1 of Week-end Retreat, a subdivision located in the Village of Bagley, Grant County, Wisconsin, according to the recorded plat thereof in the office of the Register of Deeds for Grant County, Wisconsin.


SURVEYOR'S CERTIFICATE:

I, Aaron J. Austin, Registered Wisconsin Land Surveyor, hereby certify:
 That the above description was surveyed, mapped and monumented as shown on this plat by me or under my direct supervision.
 That conformance with local ordinances are not guaranteed with this survey.
 That this survey was prepared under the instructions of Bill Jeidy.
 That to the best of my knowledge and belief, this plat is an accurate representation thereof.
 That all plans that do not show a seal imprint in red ink may contain unauthorized alterations.
 The certification contained on this document shall not apply to any copies.
 Dated this 10th day of June, 2015.

Aaron J. Austin
 Aaron J. Austin, S-2922
 LANCASTER
 WISCONSIN
 SURVEYOR

- LEGEND**
- 3/4" rebar set with cap
 - 1 1/4" rebar found
 - 3/4" rebar found
 - ⊙ 5/8" rebar found
 - + No monument set
 - () Recorded as
 - [-] Property described in Volume and Page, Grant County Registry

The East line of Lot 1 of Weekend Retreat bears N 00°58'37" W according to the Grant County Coordinate System (2011 adjustment) which was determined by G.P.S. observation.

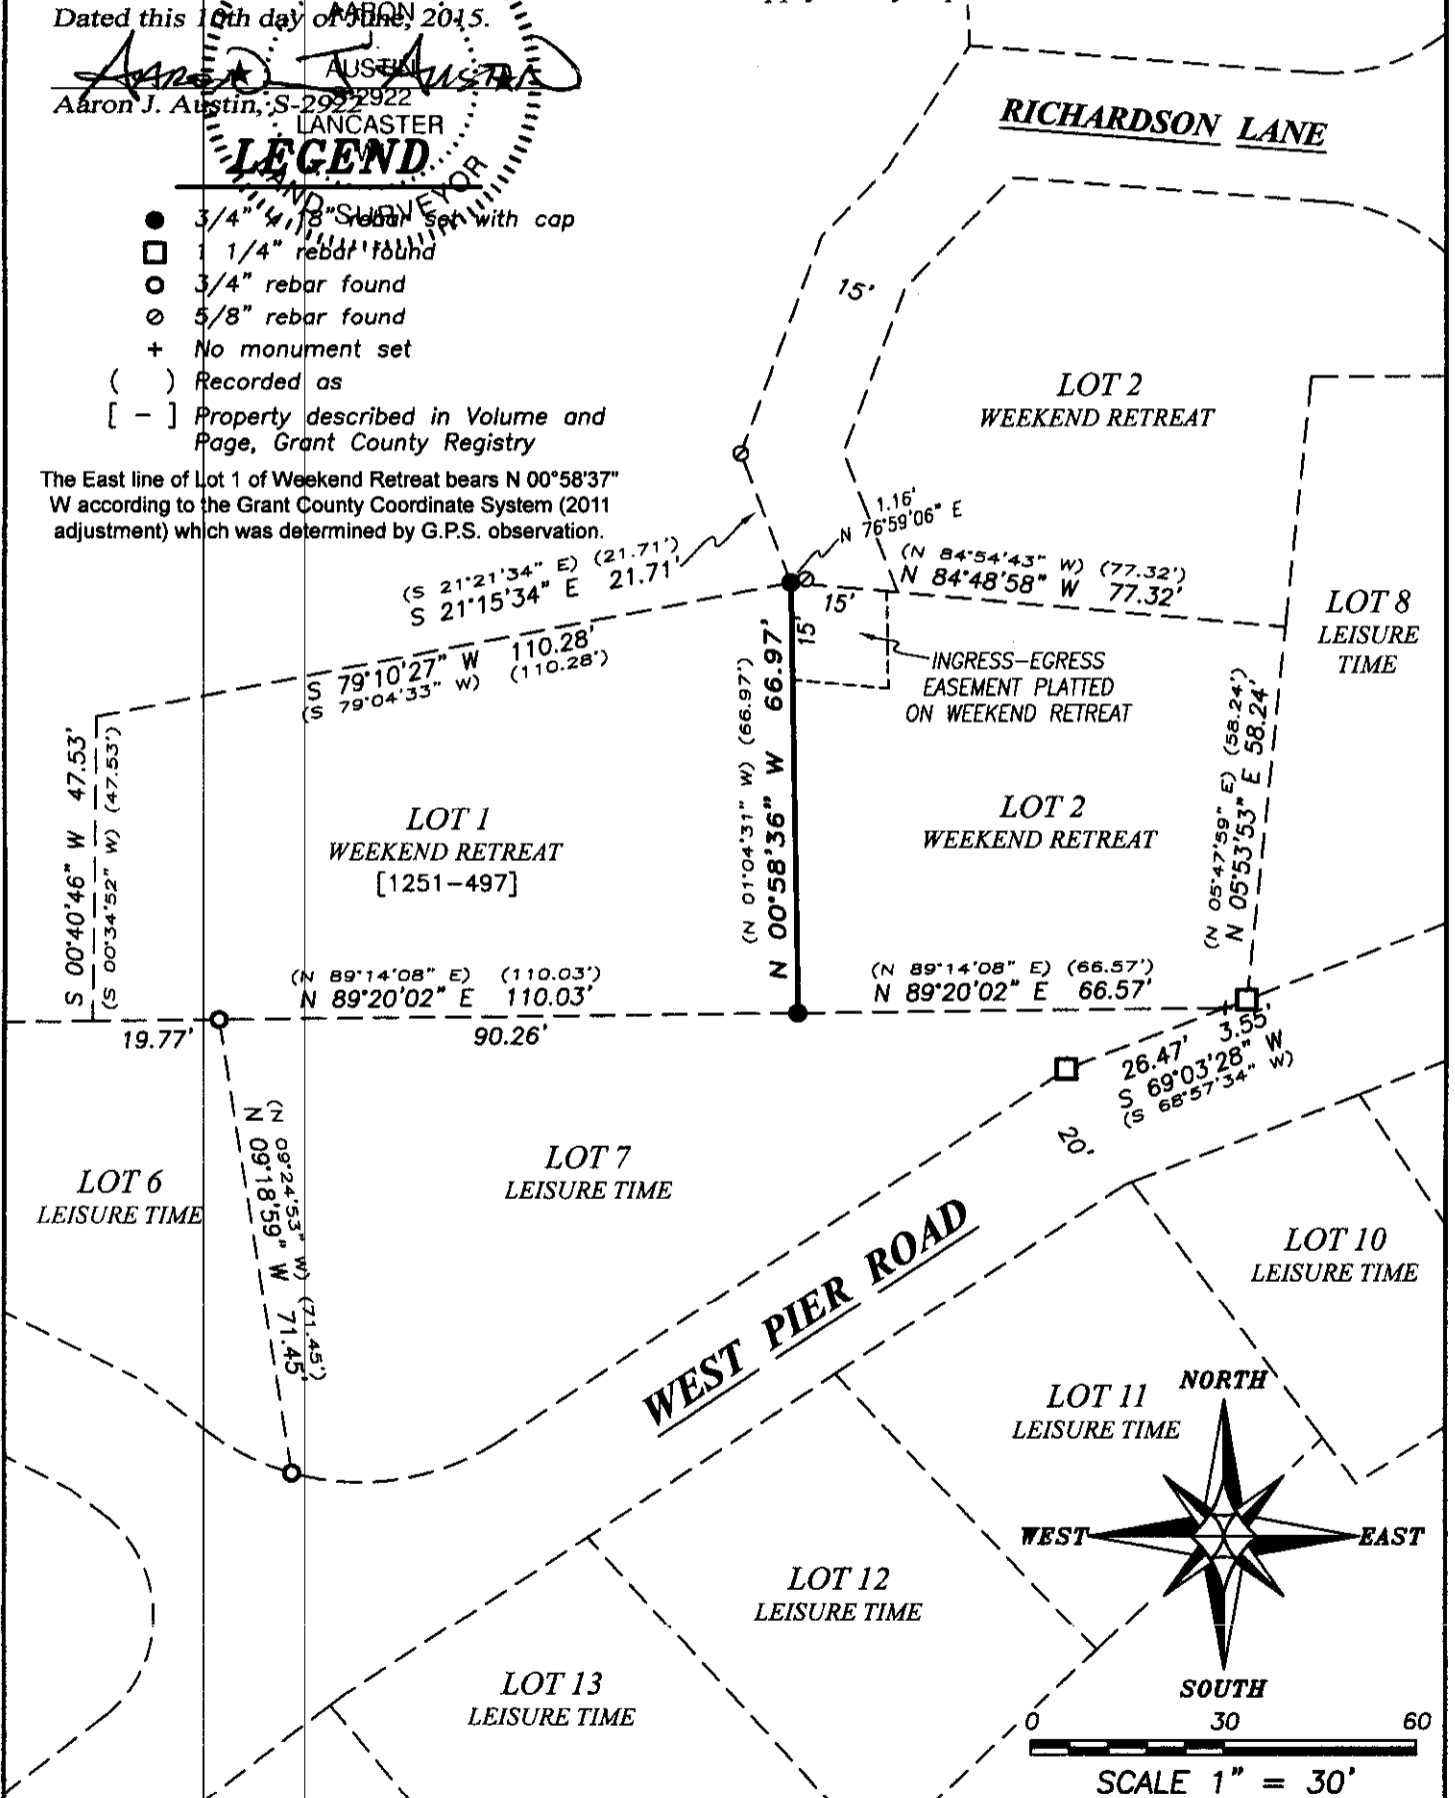

Austin Engineering LLC
 austinengineeringllc.com

4211 HWY 81 E, LANCASTER, WI 53813
 PHONE: 608-723-6363 FAX: 608-723-6702

Prepared for: RIVER LAKES RESORT

JOB NO: 15s107
 H:\CRD\14S075
 H:\PLAT\BAGLEY\WEEKEND\15s107-RIVER LAKES RESORT

FIELDBOOK: TDSR
 DRAWN BY: AJ AUSTIN
 CREW: SW AUSTIN

SHEET 1 OF 1

JUN 12 2015