


# PLAT OF SURVEY

JUL 25 JUL 25 2017

Book 40 Page 49

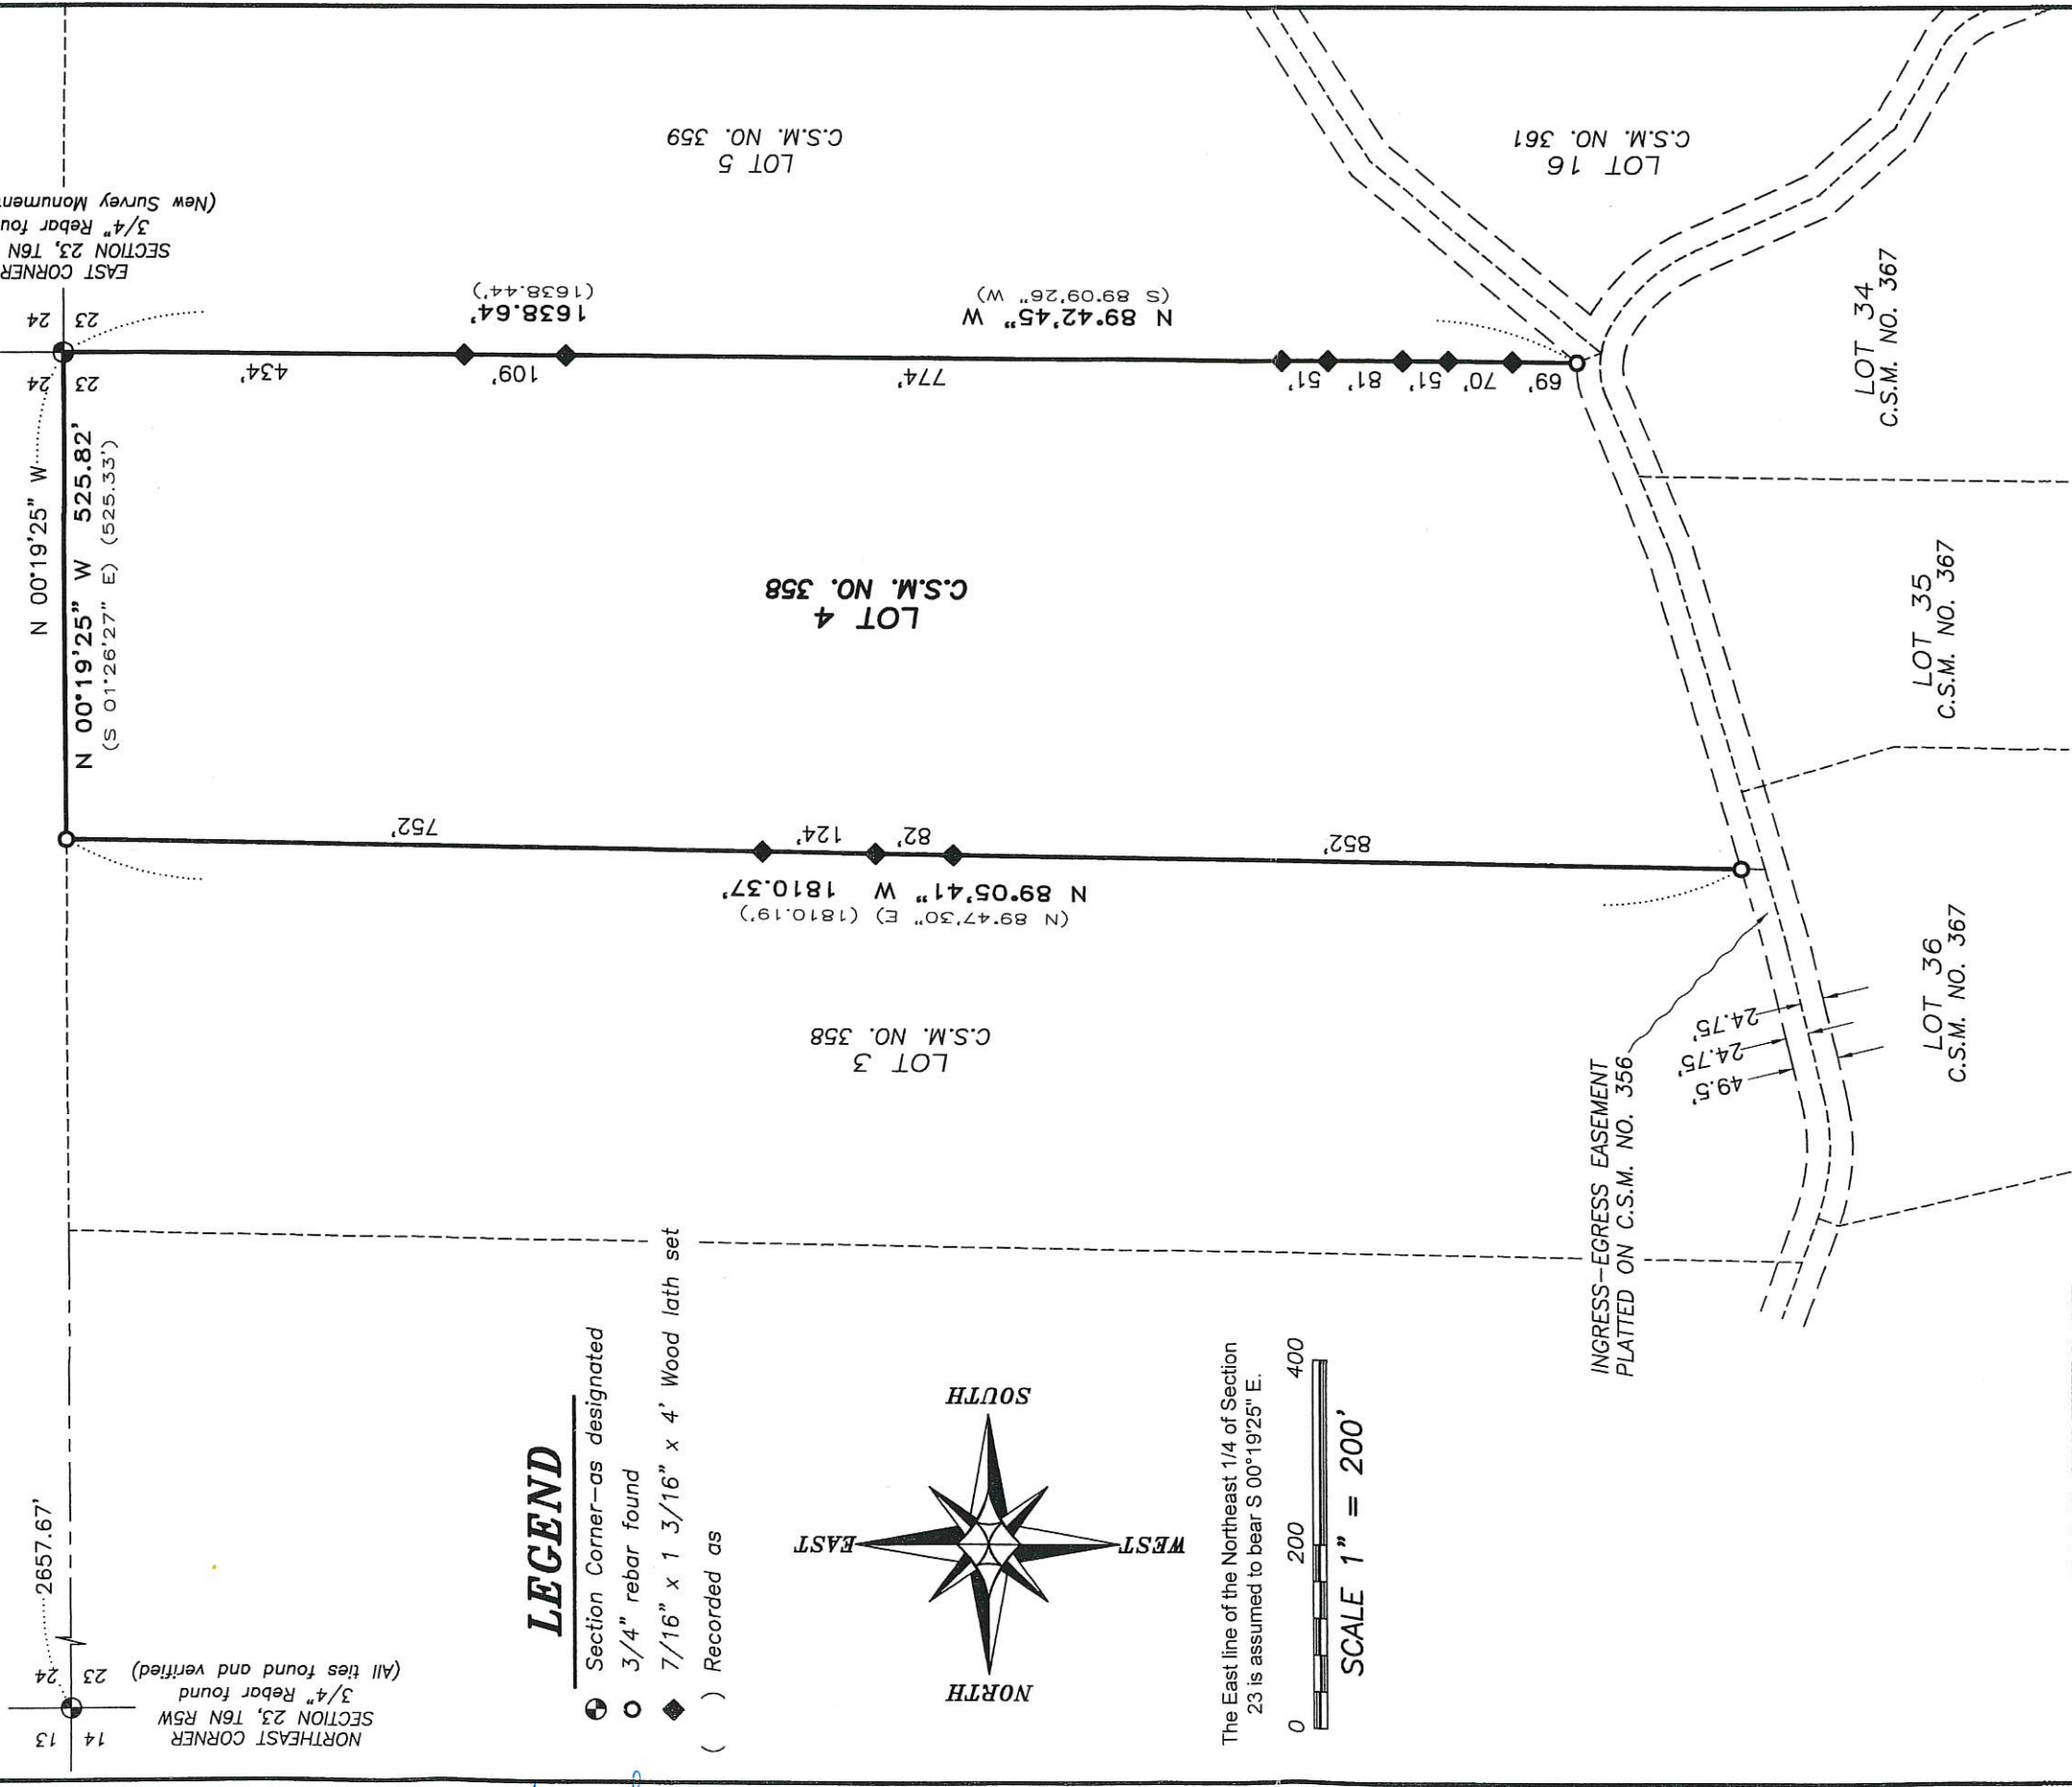

**SURVEYOR'S CERTIFICATE:**

I, Aaron J. Austin, Professional Wisconsin Land Surveyor, hereby certify:

That the North, East and South line of Certified Survey Map Number 358 recorded in Volume 2 of Certified Survey Maps on Page 222 as Document Number 564920, Grant County Registry which is located in Section 23, Township 6 North, Range 5 West of the 4th P.M., Town of Patch Grove, Grant County, Wisconsin was surveyed, mapped and monumented as shown on this plat by me or under my direct supervision and field work was completed on 7-7-2017.

That this survey was prepared under the instructions of Travis Cliff. That this survey complies with Chapter A-E 7 of the Wisconsin Administrative Code and to the best of my knowledge and belief, this plat is an accurate representation thereof.

That all plans that do not show a seal imprint in red ink may contain unauthorized alterations. The certification contained on this document shall not apply to any copies.

Dated this 18th day of July, 2017.

Aaron J. Austin, S-2922  
 Austin Engineering LLC  
 4211 HWY 81 E, LANCASTER, WI 53813  
 PHONE: 608-723-6363 FAX: 608-723-6702



Prepared for: TRAVIS CLIFF

JOB NO: 17s102  
 Hi:\CRD\17s102  
 Hi:\PLAT\T6NR5W\23\17s102-CLIFF

FIELDBOOK: TDSR  
 DRAWN BY: AJ AUSTIN  
 CREW: S. AUSTIN, O. AUSTIN