

SEC 4

026-00255-0020

Old Farm House -

4

Received 8/10/2021


January 20, 1983

47020


Kunkel Tract Westerly Of And
Adjacent To Burnell C. Pickel Lot

Jamestown Twp.

Commencing at the South 1/4 Corner of Sec. 4, T1N, R2W of the
4th P.M., Town of Jamestown, Grant County, Wisconsin; thence
N. 87°55' E. 709.20 ft.; thence N. 02°03' W. 33.00 ft. to the
point of beginning; thence N. 00°47' E. 199.51 ft.; thence
S. 87°55' W. 87.22 ft.; thence S. 00°47' W. 199.51 ft.; thence
N. 87°55' E. 87.22 ft. to the point of beginning, containing
0.399 acres, more or less, said described tract being a part
of the S.W. 1/4 of the S.E. 1/4 of Sec. 4, T1N, R2W of the
4th P.M.

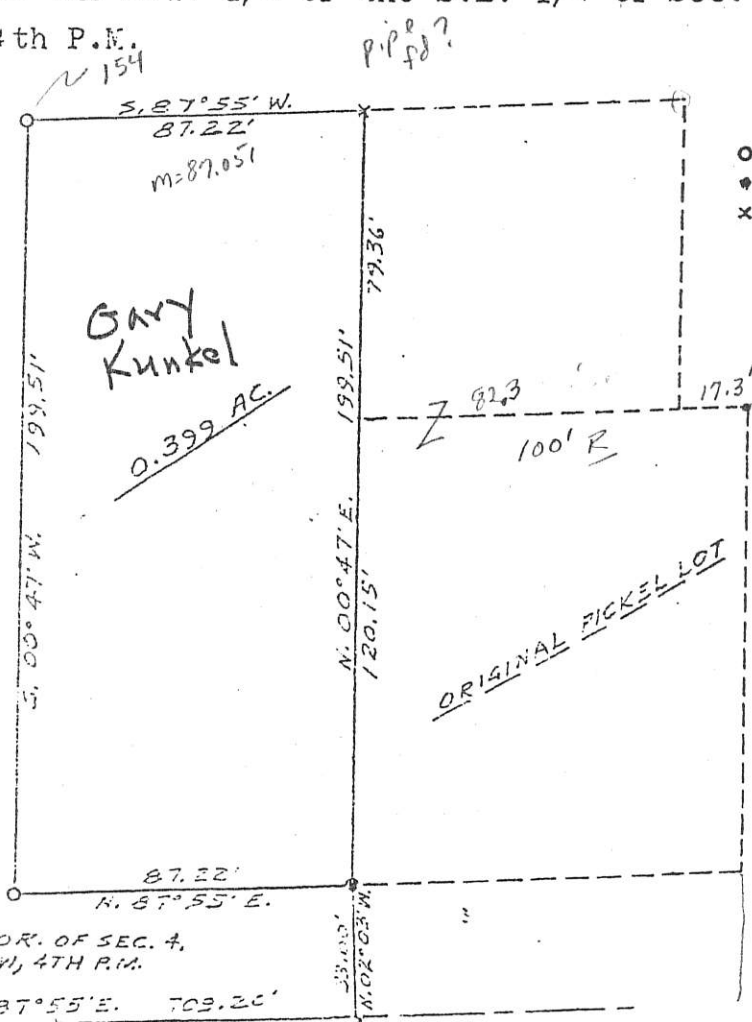

SCALE: 1"=50'
 O 1"X24" IRON PIPE (PLACED)
 ◆ IRON PIPE (FOUND)
 X MARK ON CONCRETE

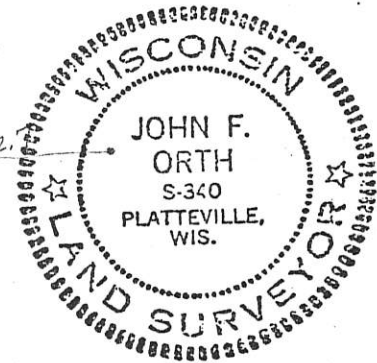

925
 10
 709.20
 100
 809.20 R

Note: Orientation and location tie of this survey based on the
correction deed description of the Bernel C. Pickel lot, recorded
at the Office of the Register of Deeds for Grant County, in
Vol. 501 of Records, page 674, dated Nov. 22, 1974.

John F. Orth

January 20, 1983


UIC 121m

1-2 (4)

Kunkel Tract Westerly Of And
Adjacent To Burnell C. Pickel Lot

Jamestown Twp.

Commencing at the South 1/4 Corner of Sec. 4, T1N, R2W of the
4th P.M., Town of Jamestown, Grant County, Wisconsin; thence
N. 87°55' E. 709.20 ft.; thence N. 02°03' W. 33.00 ft. to the
point of beginning; thence N. 00°47' E. 199.51 ft.; thence
S. 87°55' W. 87.22 ft.; thence S. 00°47' W. 199.51 ft.; thence
N. 87°55' E. 87.22 ft. to the point of beginning, containing
0.399 acres, more or less, said described tract being a part
of the S.W. 1/4 of the S.E. 1/4 of Sec. 4, T1N, R2W of the
4th P.M.

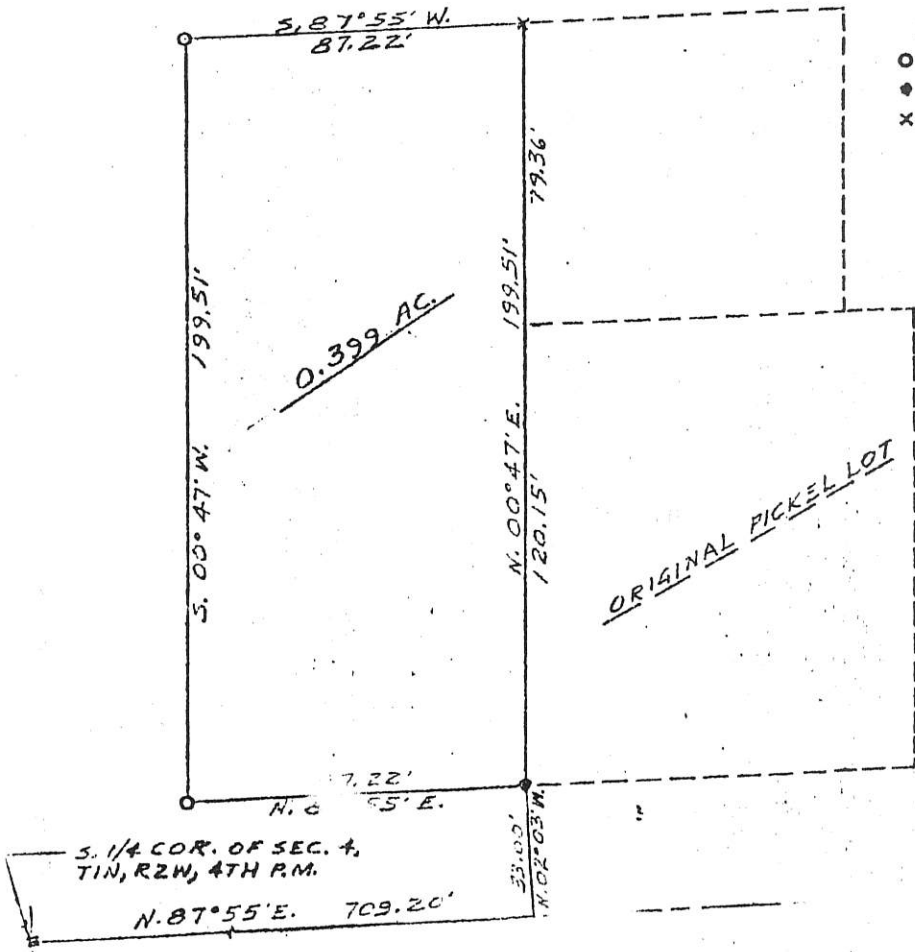

- SCALE: 1"=50'
- 1"X24" IRON PIPE (PLACED)
 - IRON PIPE (FOUND)
 - x MARK ON CONCRETE



Note: Orientation and location tie of this survey based on the
correction deed description of the Bernel C. Pickel lot, recorded
at the Office of the Register of Deeds for Grant County, in
Vol. 501 of Records, page 674, dated Nov. 22, 1974.

John F. Orth
John F. Orth