
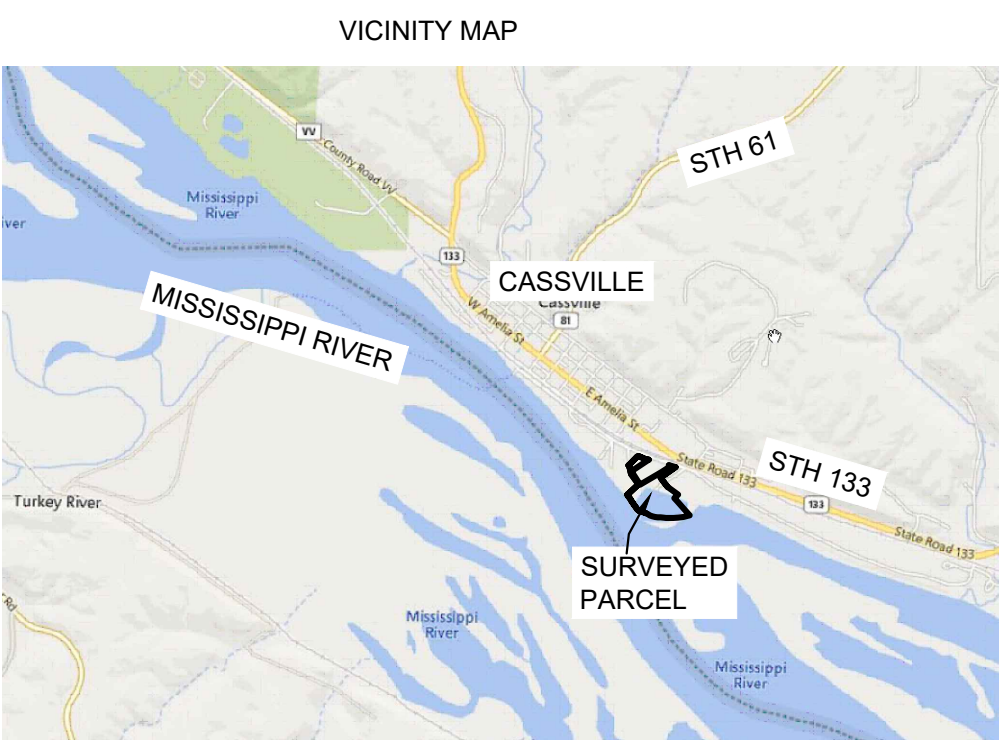



ALTA / NSPS LAND TITLE SURVEY

ALL OF LOT 3 OF CERTIFIED SURVEY MAP NO. 1497 RECORDED AS DOCUMENT NO. 720363 IN VOLUME 14 PAGES 22-30, ALL OF LOTS 2 AND 3 AND OUTLOT 1 OF CERTIFIED SURVEY MAP NO. 2223 RECORDED AS DOCUMENT NO. 840258 IN VOLUME/BOOK 22 PAGES 66-71, AND PART OF GOVERNMENT LOTS 2 AND 3 OF SECTION 29, TOWNSHIP 3 NORTH, RANGE 5 WEST, VILLAGE OF CASSVILLE, GRANT COUNTY, WISCONSIN

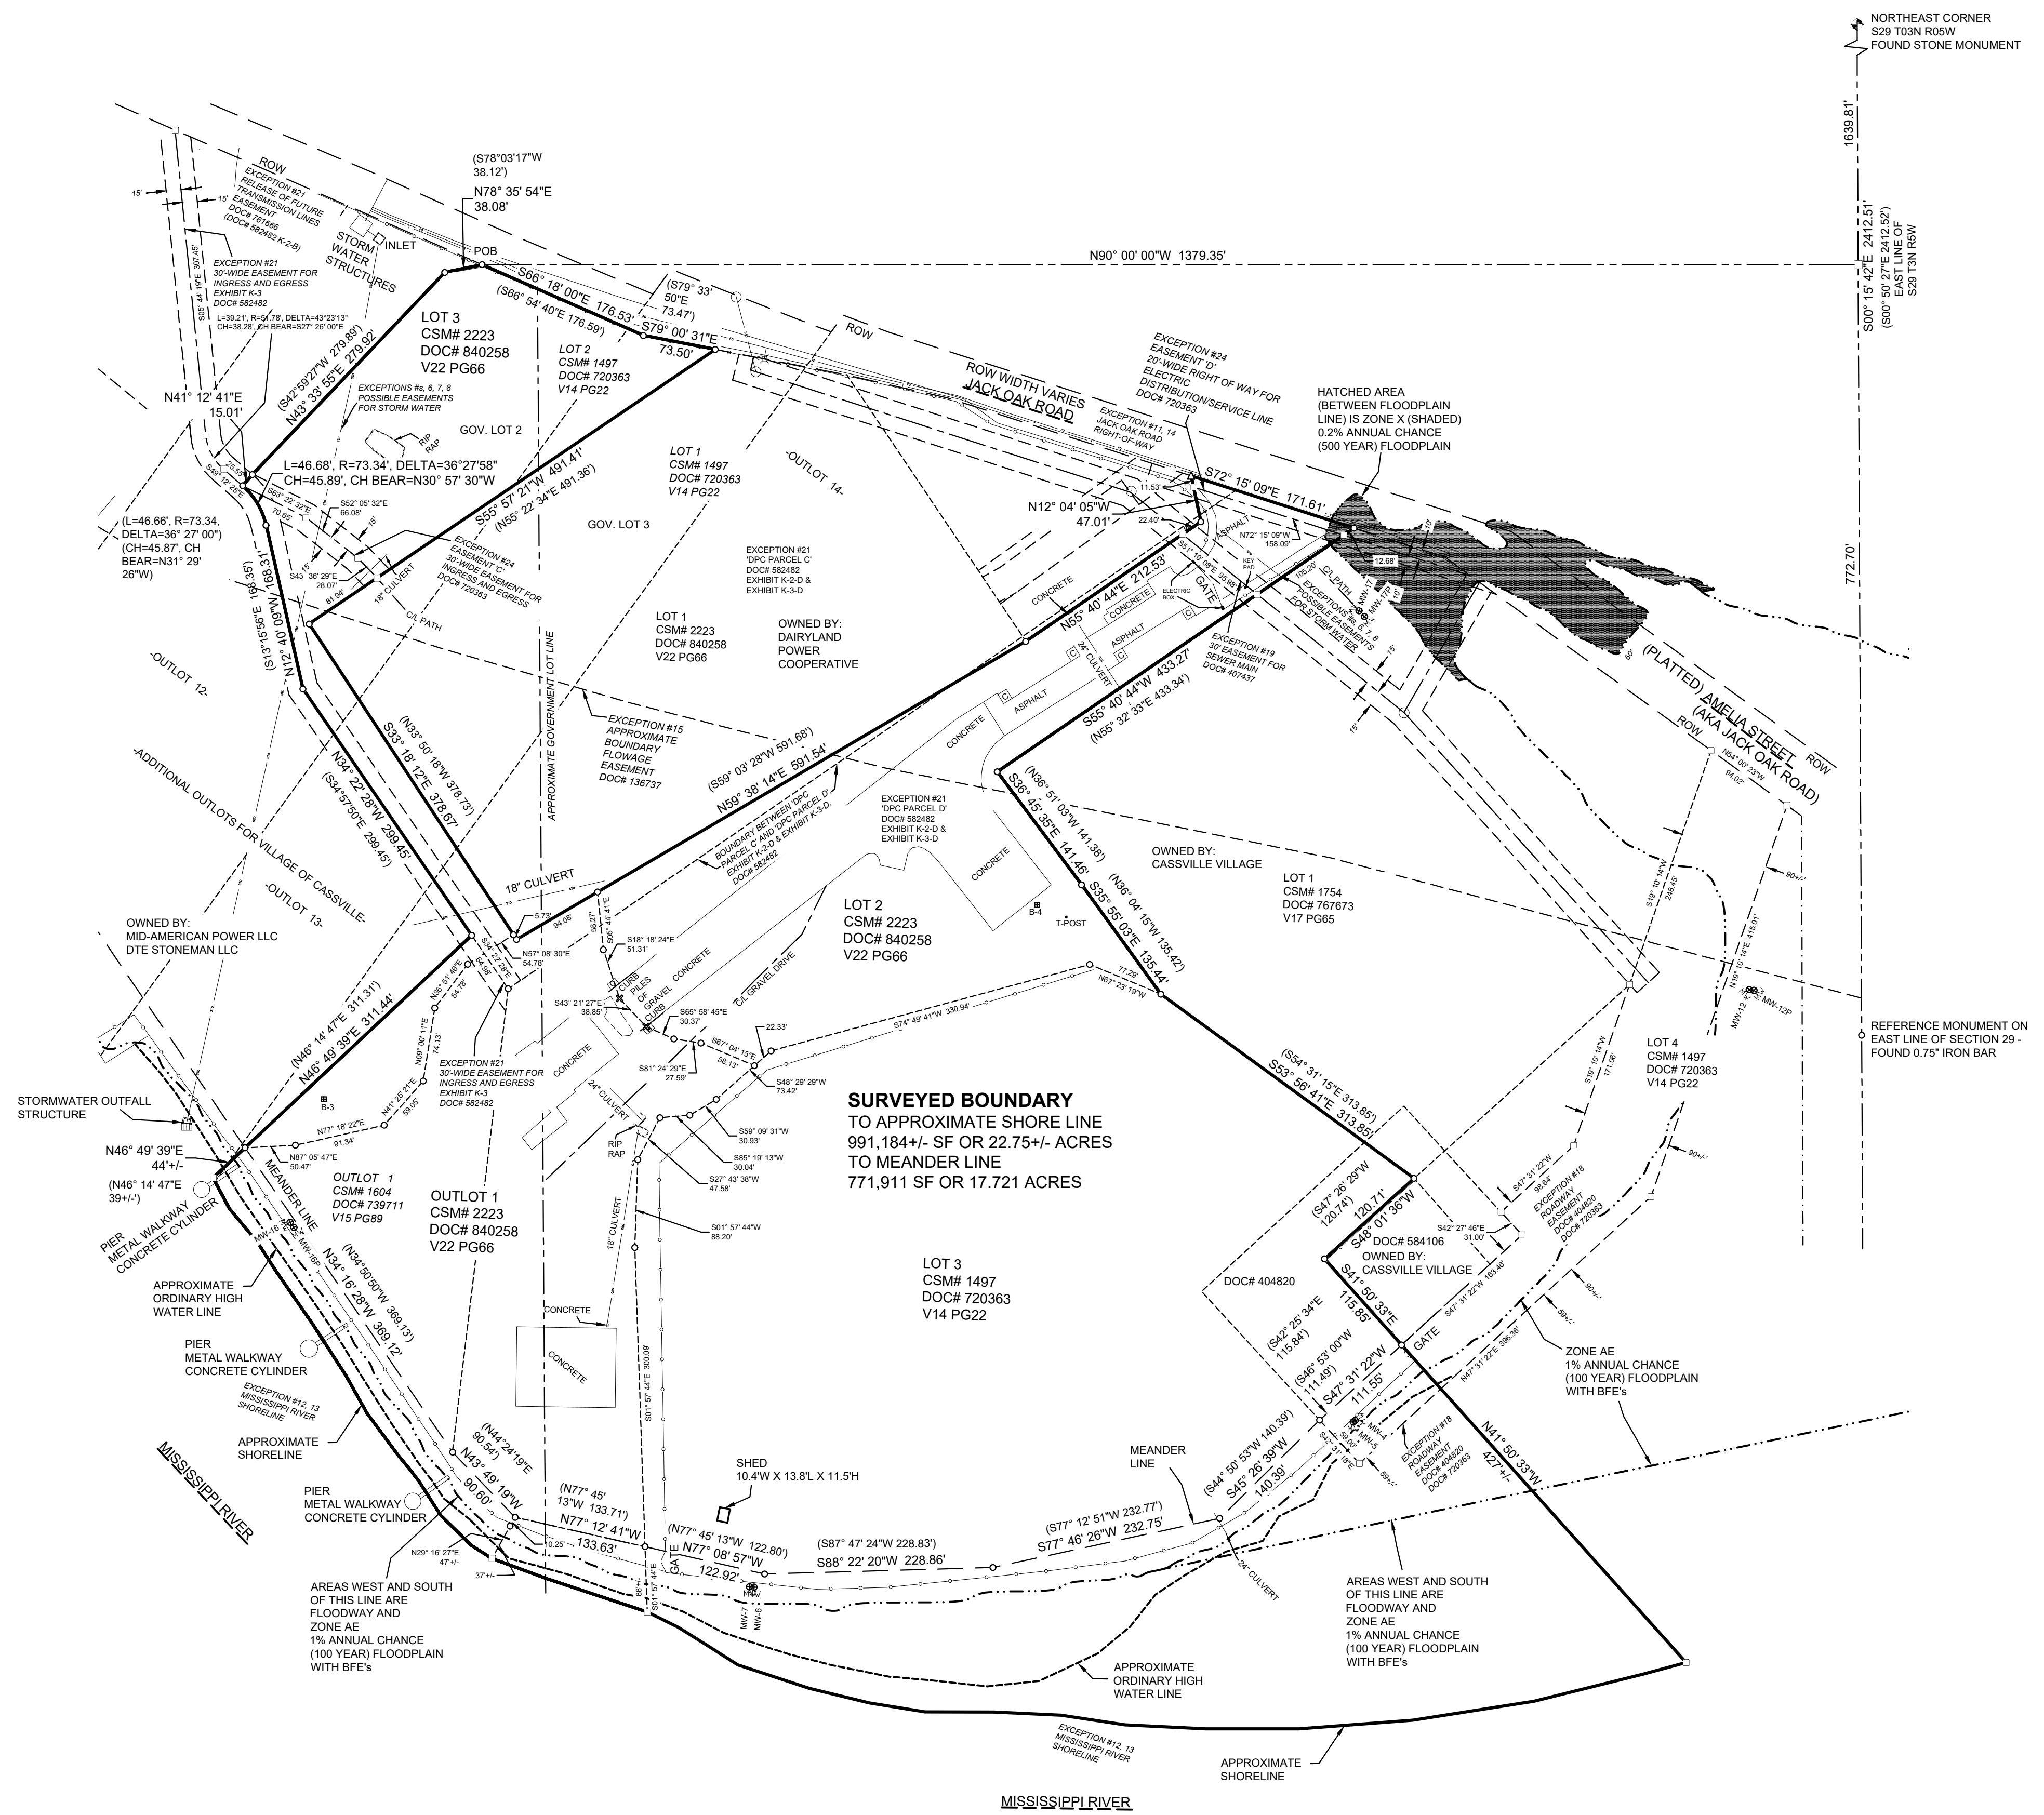

LEGEND

<ul style="list-style-type: none"> ○ GOVERNMENT CORNER ○ FD 3/4" O.D. IRON BAR W/ CAP ○ POB ○ RIGHT-OF-WAY ○ "RECORDED AS" DATA ○ SOIL BORING ○ MONITORING WELL ○ COMPUTED POINT ○ MANHOLE ○ WATER VALVE ○ FD MAG NAIL ○ FD CHISELED 'X' ○ PEDESTAL 	<ul style="list-style-type: none"> — CENTERLINE — SECTION LINE — ROW — EXTERIOR SURVEYED BOUNDARY — EASEMENT LINE — LOT LINES — STORM SEWER — BURIED FIBER OPTIC — BURIED TELEPHONE — CHAIN-LINK FENCE — EDGE OF GRAVEL — FLOODPLAIN BOUNDARY (SEE NOTATIONS) — APPROXIMATE ORDINARY HIGHWATER LINE — OR — CONTOUR LINE
--	---

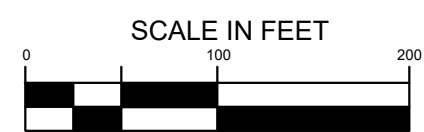

Bearings were measured to the WISCONSIN State Plane (NAD 83) and referenced to the East Line of S29, T3N, R5W measured as S00° 15' 42"E

SURVEYOR'S CERTIFICATE

To Michels Corporation, Cassville 2000PTSK LLC, Knight Barry Title Inc., First American Title Insurance Company, and any person or entity taking title to the property within one year from the date of this survey, and any lender providing financing to the owner of the property and placing a mortgage on the property within one year from the date of this survey:

This is to certify that this map or plat and the survey on which it is based were made in accordance with the "Minimum Standard Detail Requirements for ALTA/NSPS Land Title Surveys", jointly established and adopted by ALTA and NSPS in 2021 and includes items 1, 2, 3, 4, 5, 7(a)(b)-(1)(c), 8, 11, 13, 14, 16, 17, 18, and 19 of Table A thereof. Pursuant to the Accuracy Standards as adopted by ALTA and NSPS and in effect on the date of this certification, undersigned further certifies that in my professional opinion, as a land surveyor registered in the State of Wisconsin, the Relative Positional Accuracy of this survey does not exceed that which is specified therein. The field work was completed in April and November of 2023.

Dated: December 14, 2023

Preston A. Liptack
 Wisconsin - Professional Land Surveyor, S-3063
 Mi-Tech Services, Inc.
 46 S. Rolling Meadows Drive
 Fond Du Lac, WI 54937
 920-924-3690
 pliptack@mi-tech.us



Project Number	110040
Sheet Reference Number	1 of 2
Designed:	
Drawn:	
Checked:	
Approved:	
Project Number	
Revision	Date
Revision	Date
ALTA/NSPS LAND TITLE SURVEY
 PROPERTY OF DAIRYLAND POWER COOPERATIVE, A WISCONSIN COOPERATIVE ASSOCIATION
 LOCATED IN PART OF GOVERNMENT LOTS 2 AND 3 OF SECTION 29, TOWNSHIP 03 NORTH, RANGE 05 WEST, VILLAGE OF CASSVILLE, GRANT COUNTY, WISCONSIN



