

PLAT OF SURVEY

FOR: IAN J SCOTT
KATHRYN G SCOTT
1095 WALNUT DELL RD
PLATTEVILLE, WI 53818


PARCEL DESCRIPTION:

Being Lot 1 of CSM #2178, located in the NW 1/4 of the SE 1/4 of Section 3, T3N, R1W, Town of Platteville, Grant County, Wisconsin.

SURVEYOR'S CERTIFICATE:


I hereby certify that I have surveyed and mapped the parcel of land hereon and that I am in full compliance with the provisions of Chapter A-E 7 of the Wisconsin Administrative Code to the best of my knowledge and belief.

Michael G. Rochon 7/7/2026
Michael G. Rochon, PLS No. S-2767 Date

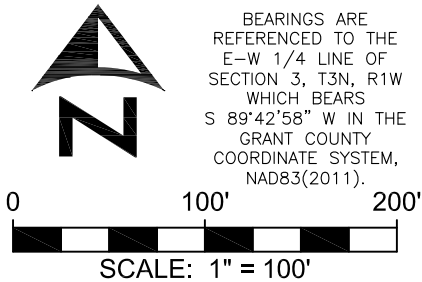

LEGEND:

- ▲ 3/4" REBAR FOUND
- ✦ SECTION CORNER
ALL TIES FOUND & VERIFIED
- () RECORDED AS
- x— EXISTING FENCELINE
- ⊗ REFERENCE POINT

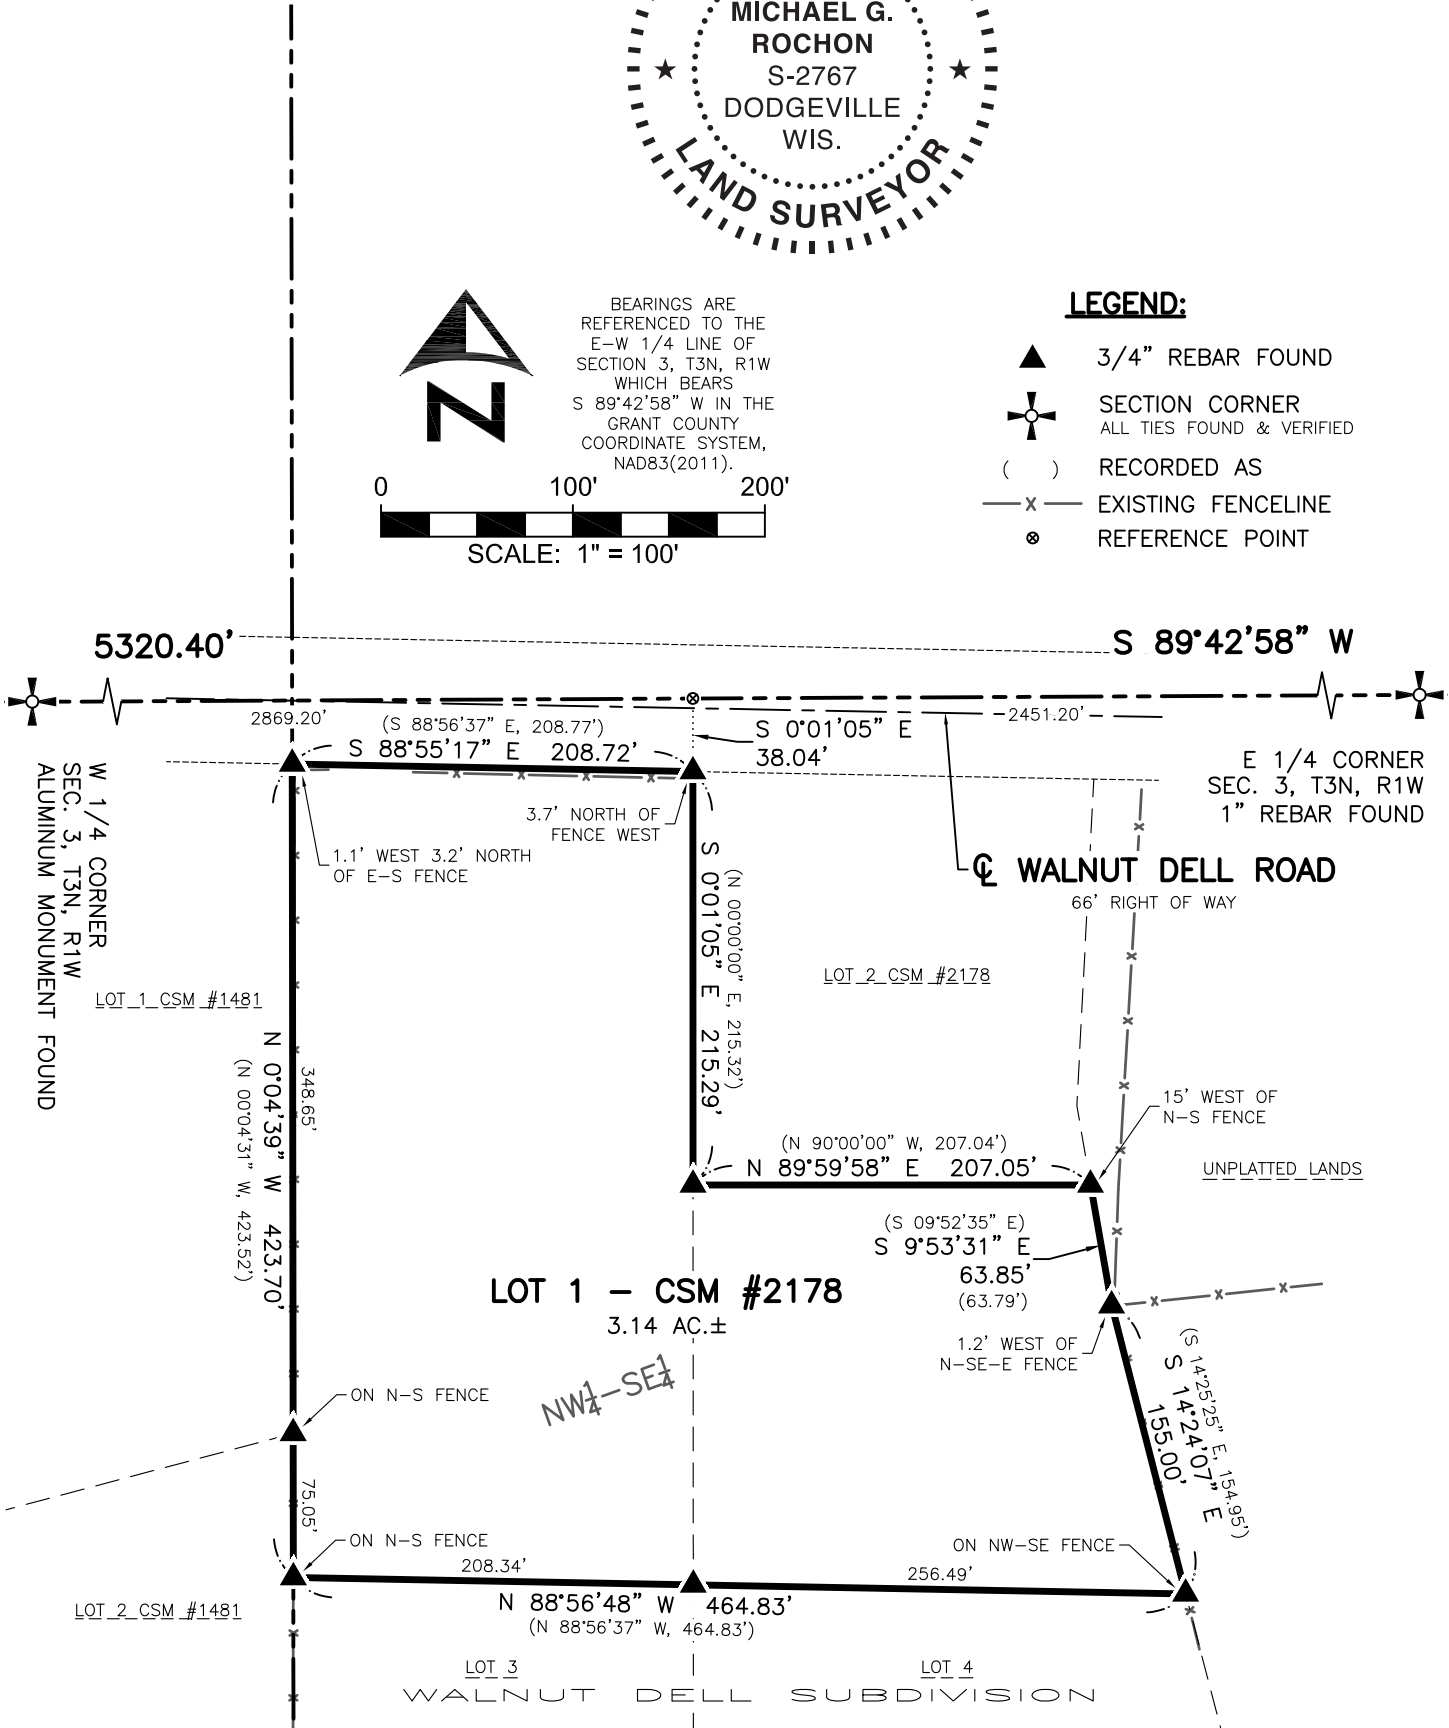

FULLCIRCLE
ENGINEERING & SURVEYING

3462 Spring Valley Road,
Dodgeville, WI 53533
608-935-0294
www.fullcircleES.com

SHEET 1 OF 1
JOB ID: 2606291B
DWG: MGR BWJ
FIELDWORK COMPLETED 7/1/2026