

PLAT OF SURVEY

FOR: CHRISTINE C BARTELS
719 HARRISON ST
LANCASTER, WI 53813

PARCEL DESCRIPTION:

Lot 9, Block 4 and the
E 1/2 of Unopened Alley of
Reed's Addition, located in
the NE 1/4 of the NW 1/4
of Section 10, T4N, R3W,
City of Lancaster, Grant
County, Wisconsin.

SURVEYOR'S CERTIFICATE:



I hereby certify that I have surveyed and
mapped the parcel of land hereon and that I
am in full compliance with the provisions of
Chapter A-E 7 of the Wisconsin Administrative
Code to the best of my knowledge and belief.

Michael G. Rochon 8/24/2026
Michael G. Rochon, PLS No. S-2767 Date




LEGEND:

- 3/4" X 20" REBAR SET
- 1-1/4" OD. IRON PIPE FOUND
- ✦ SECTION CORNER
ALL TIES FOUND & VERIFIED
- () RECORDED AS

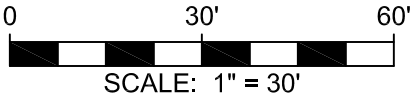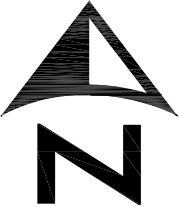

BEARINGS ARE REFERENCED
TO THE NORTH LINE OF
THE NW 1/4 SECTION 10,
T4N, R3W, WHICH BEARS
S 89°47'22" W IN THE
GRANT COUNTY COORDINATE
SYSTEM, NAD83(2011).

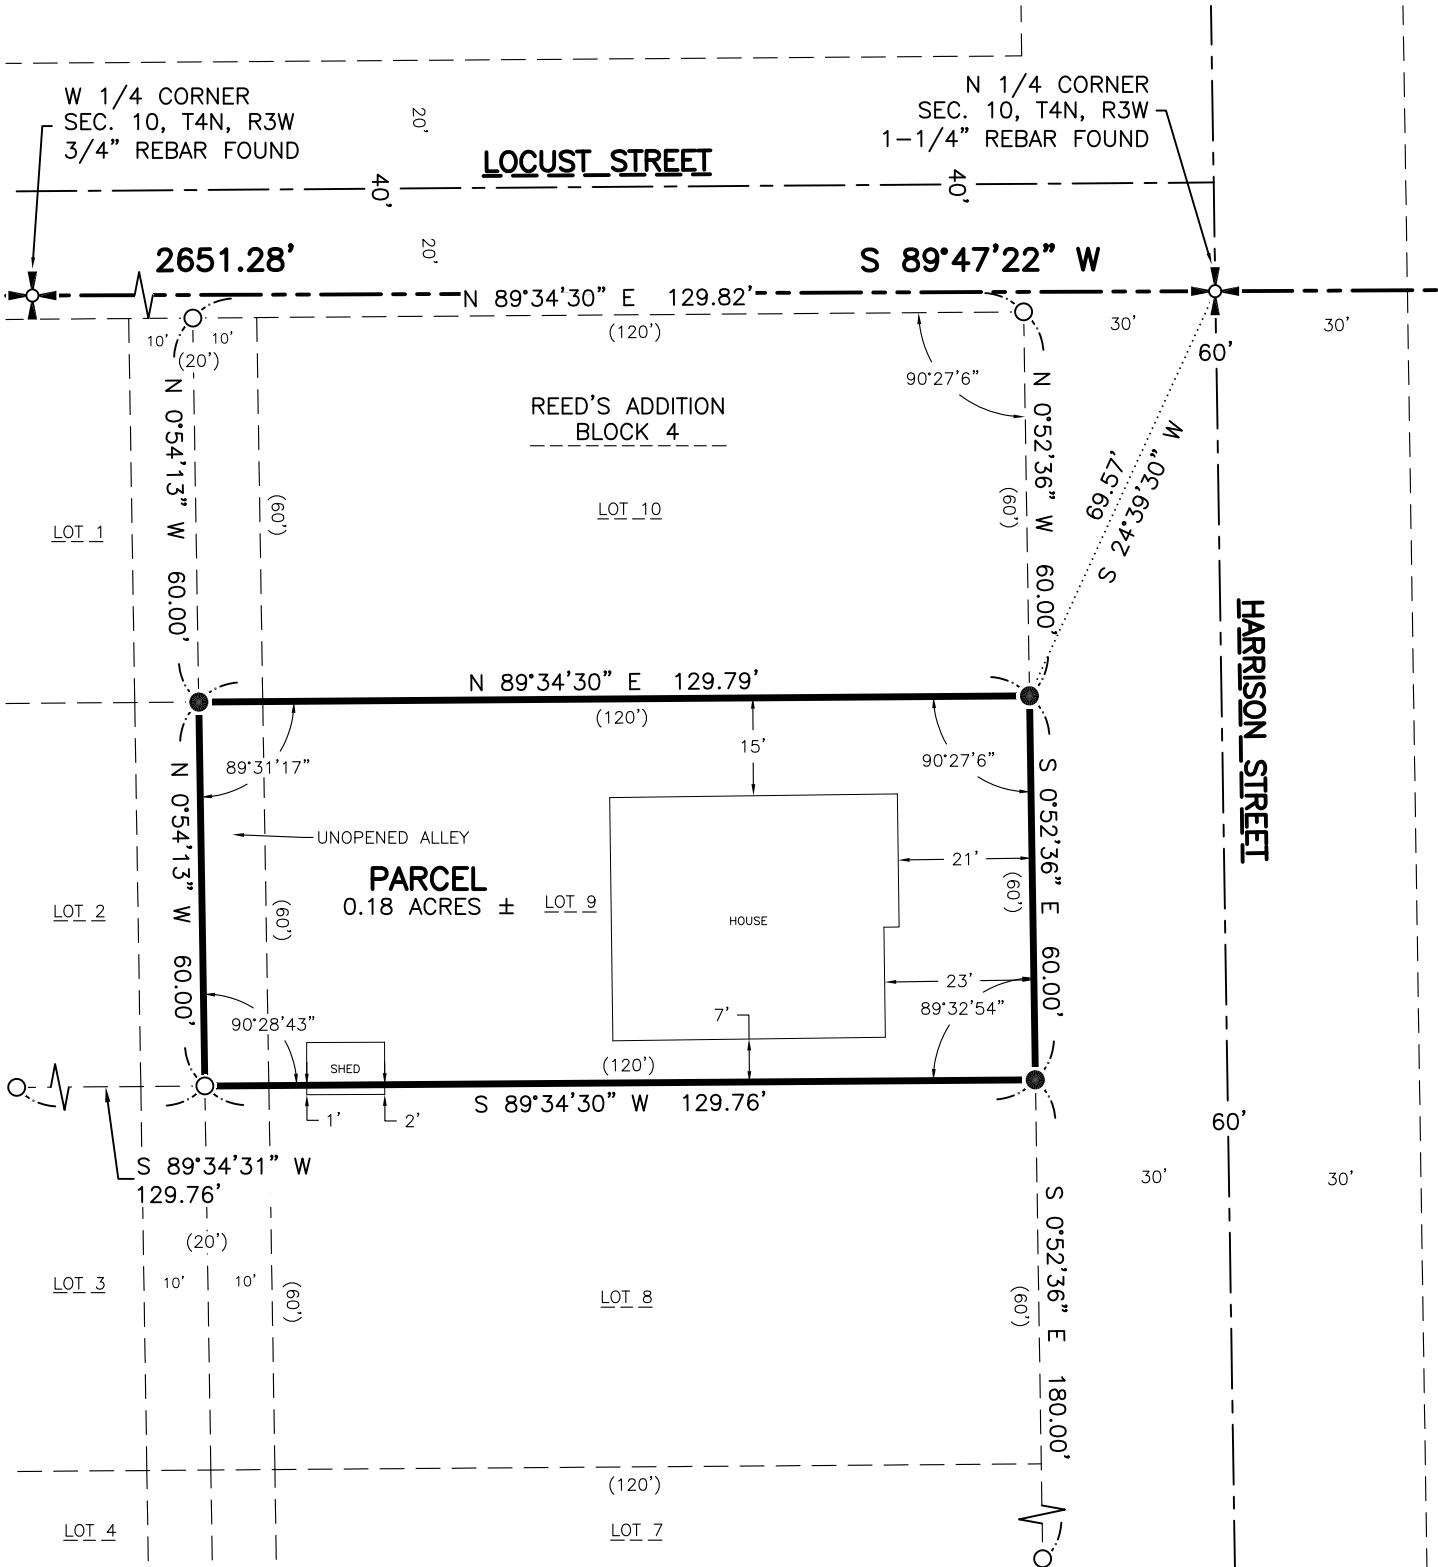

FULLCIRCLE
ENGINEERING & SURVEYING

3462 Spring Valley Road
Dodgeville, WI 53533
608-935-0294
www.fullcircleES.com

SHEET 1 OF 1
JOB ID: 2608211B
FIELD: MGR
DWG. BY: MGR BWJ
FIELD WORK COMPLETED 8/21/2026