


PLAT OF SURVEY

FOR: BRIAN NORTHOUSE
1104 CEDAR ROAD
BOSCOBEL, WI 53805

OWNER: MARK A & DEBORAH K ASHMORE
3470 COUNTY ROAD M
BOSCOBEL WI 53805

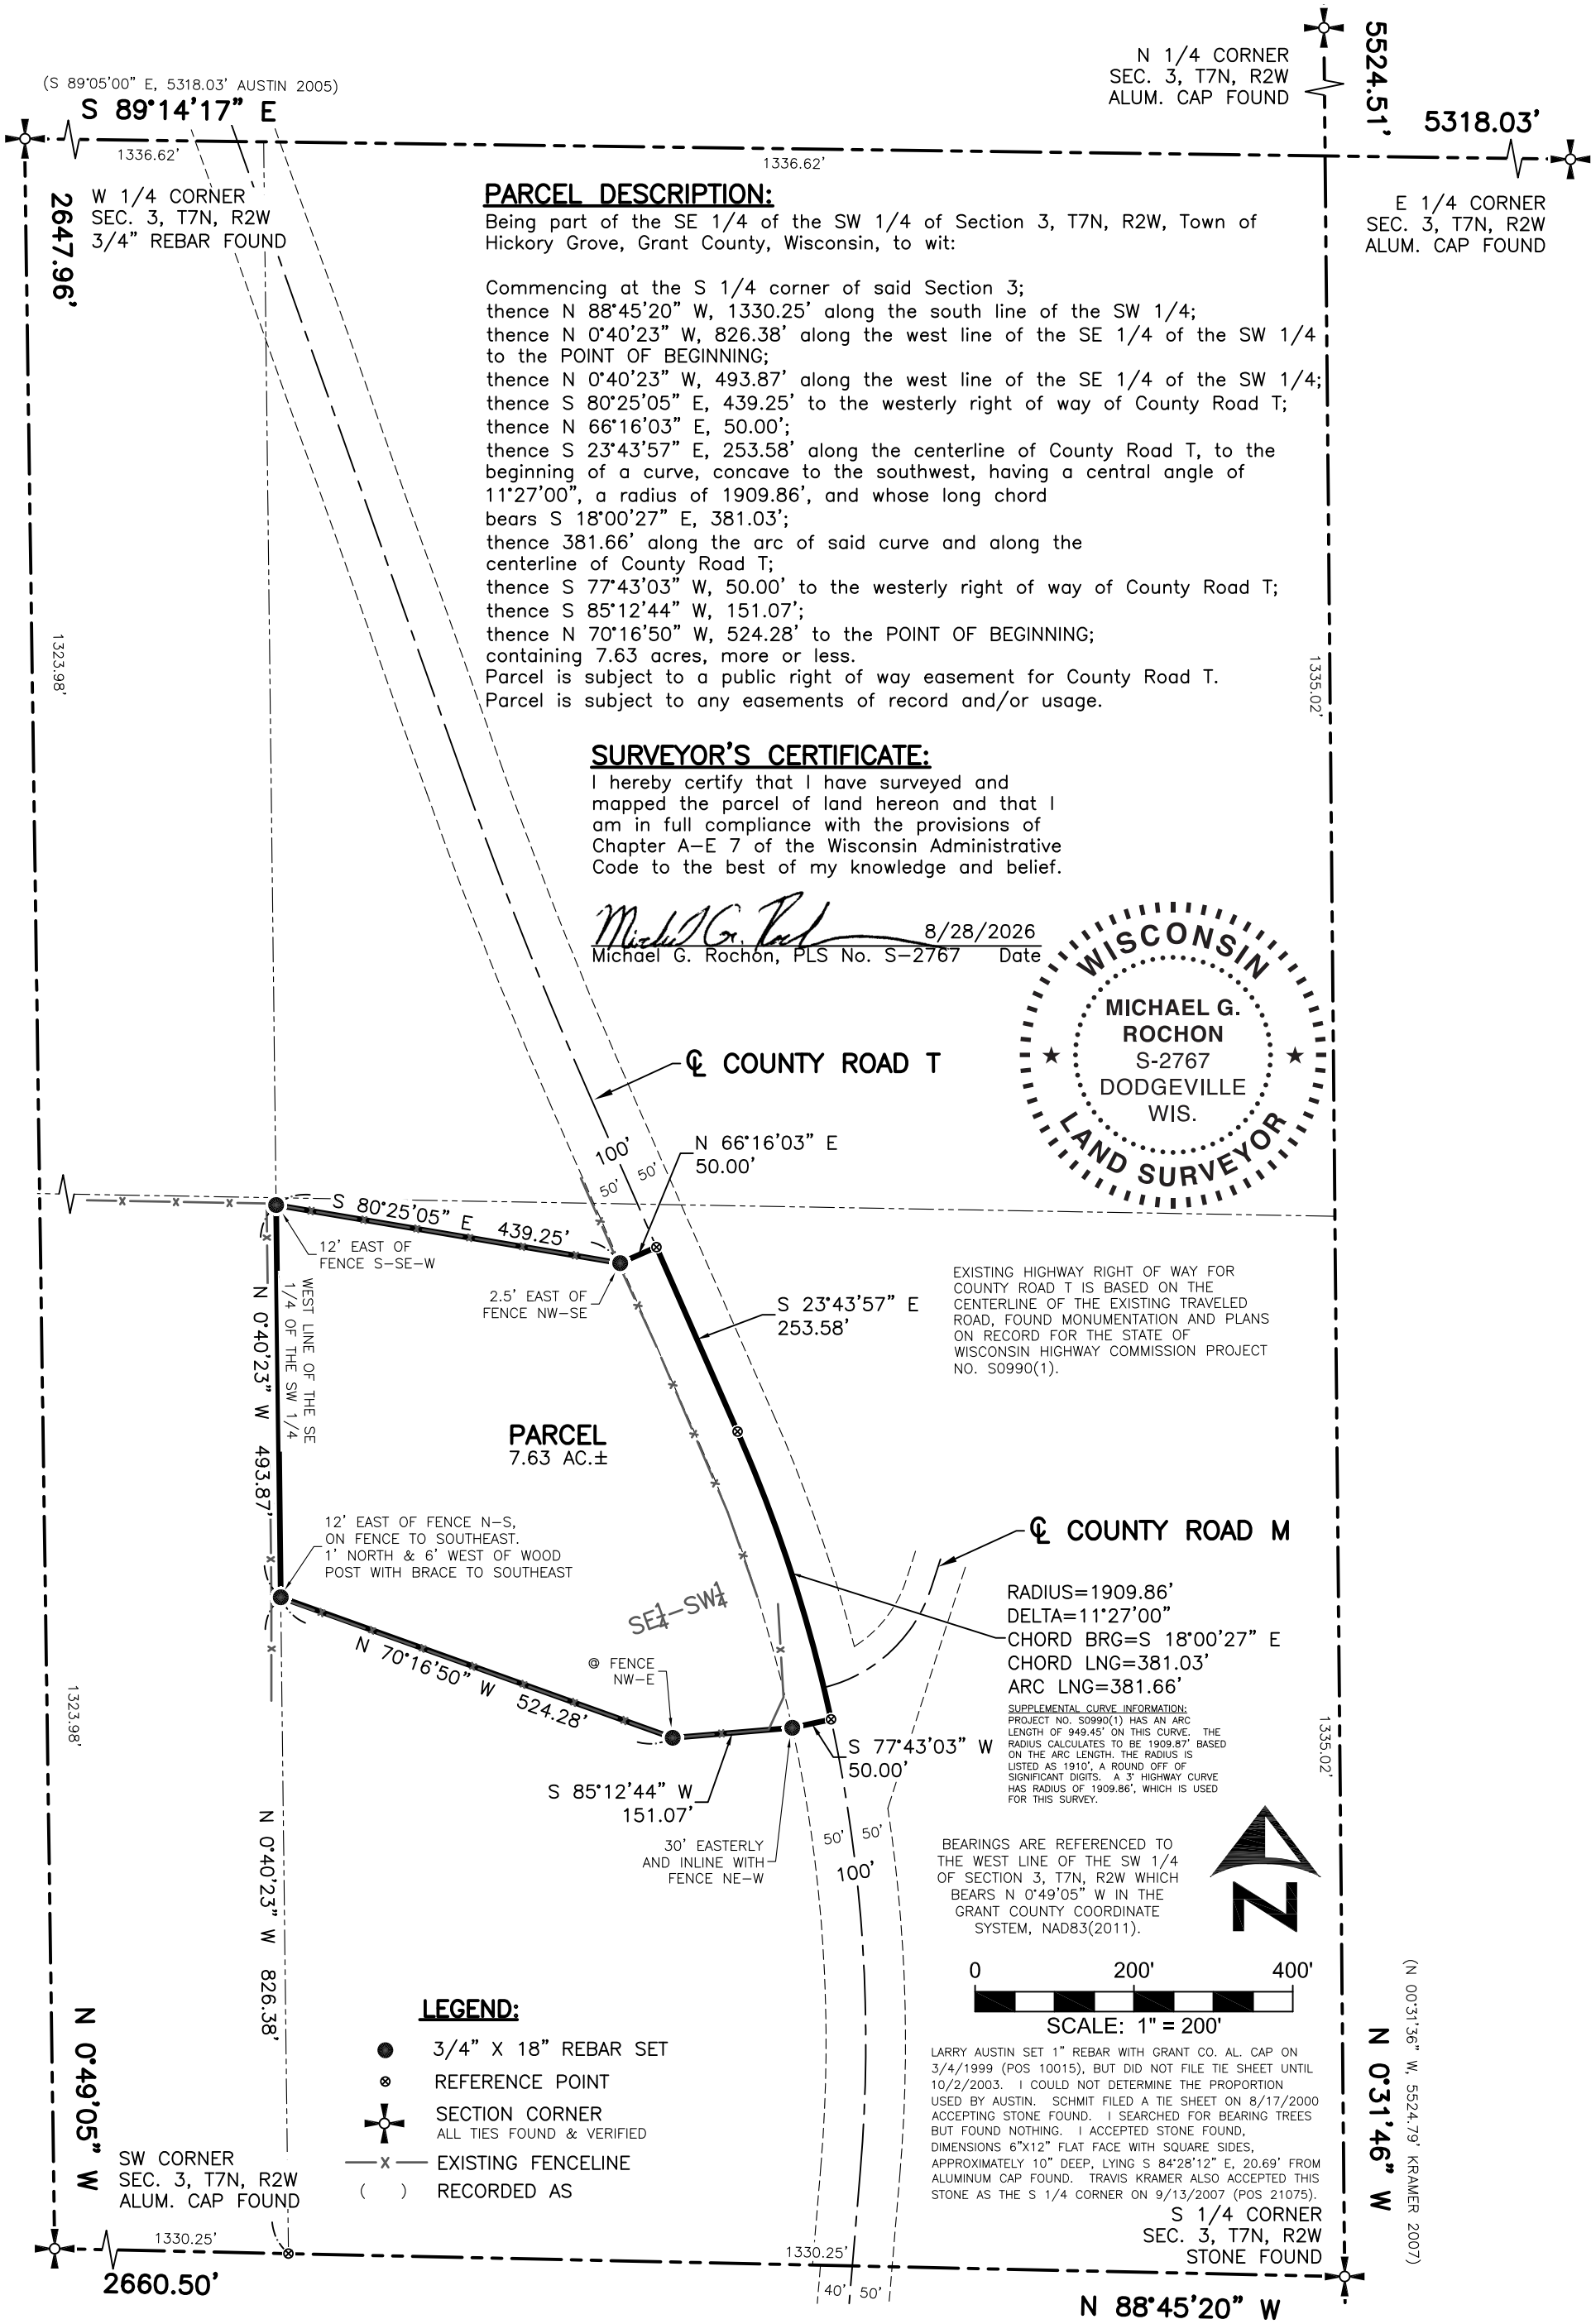

FULLCIRCLE
ENGINEERING & SURVEYING

3462 Spring Valley Road,
Dodgeville, WI 53533
608-935-0294
www.fullcircleES.com

SHEET 1 OF 1
JOB ID: 2608261B
DWG: MGR BWJ
FIELDWORK COMPLETED 8/27/2026