

PLAT OF SURVEY

FOR
PETER SCHWENZFEIER
P.O. BOX 5
MONTFORT, WI 53569

SURVEYOR'S CERTIFICATE:



I hereby certify that I have surveyed and mapped the parcel of land hereon and that I am in full compliance with the provisions of Chapter A-E 7 of the Wisconsin Administrative Code to the best of my knowledge and belief.

Michael G. Rochon 8/18/2026
Michael G. Rochon, PLS No. S-2767 Date



NE CORNER
SEC. 25
T6N, R1W
AL. MON. IN
CASING FOUND

N 1/4 CORNER
SEC. 25, T6N, R1W
2" IRON PIPE FOUND

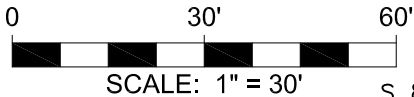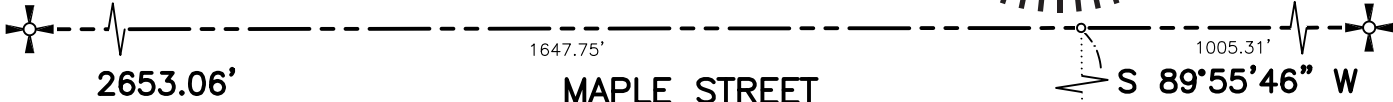

MAPLE STREET

S 89°16'42" W 210.50'

DIETER AND EASTMAN'S ADDITION
BLOCK 4

PARCEL DESCRIPTION:

LOT 16, N 1/2 OF LOT 15 and 1/2
OF ADJACENT ALLEYS,
BLOCK 4, DIETER & EASTMAN'S
ADDITION,
VILLAGE OF MONTFORT, GRANT COUNTY,
WISCONSIN


LEGEND:

- 3/4" x 18" REBAR SET
- ▲ 3/4" REBAR FOUND
- 1" REBAR FOUND
- ⊗ MAG NAIL FOUND
- ⊕ SECTION CORNER
ALL TIES FOUND AND VERIFIED
- REFERENCE POINT
- () RECORDED AS

BEARINGS ARE REFERENCED
TO THE NORTH LINE OF THE
NE 1/4 SECTION 25, T6N,
R1W, WHICH BEARS
S 89°55'46" W IN THE GRANT
COUNTY COORDINATE SYSTEM.



MADISON STREET

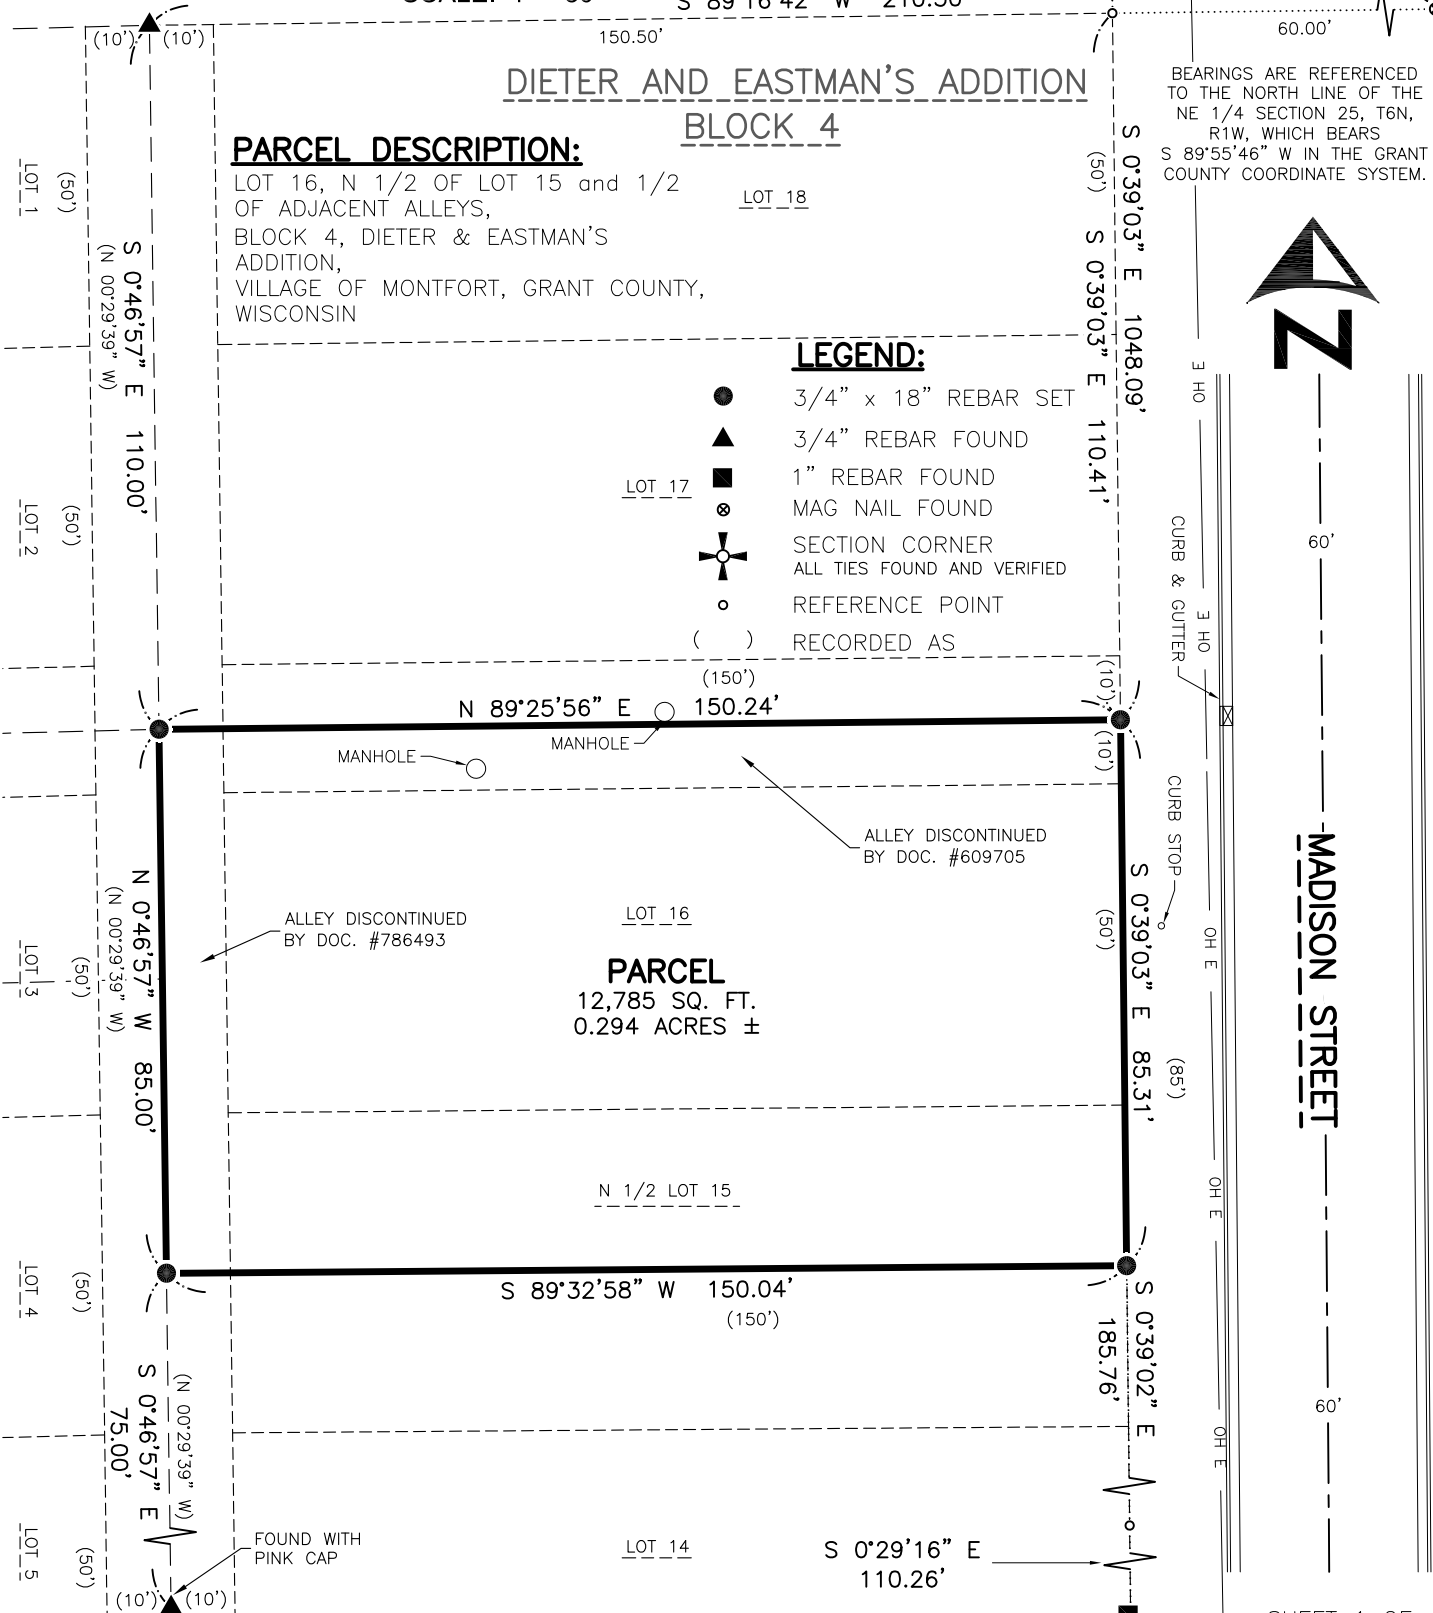

FULLCIRCLE
ENGINEERING & SURVEYING

3462 Spring Valley Road
Dodgeville, WI 53533
608-935-0294
www.fullcircleES.com

SHEET 1 OF 1
JOB ID: 2607261B
FIELD CREW: MGR BWJ
DWG. BY: MGR BWJ
FIELD WORK COMPLETE 8/7/2026