


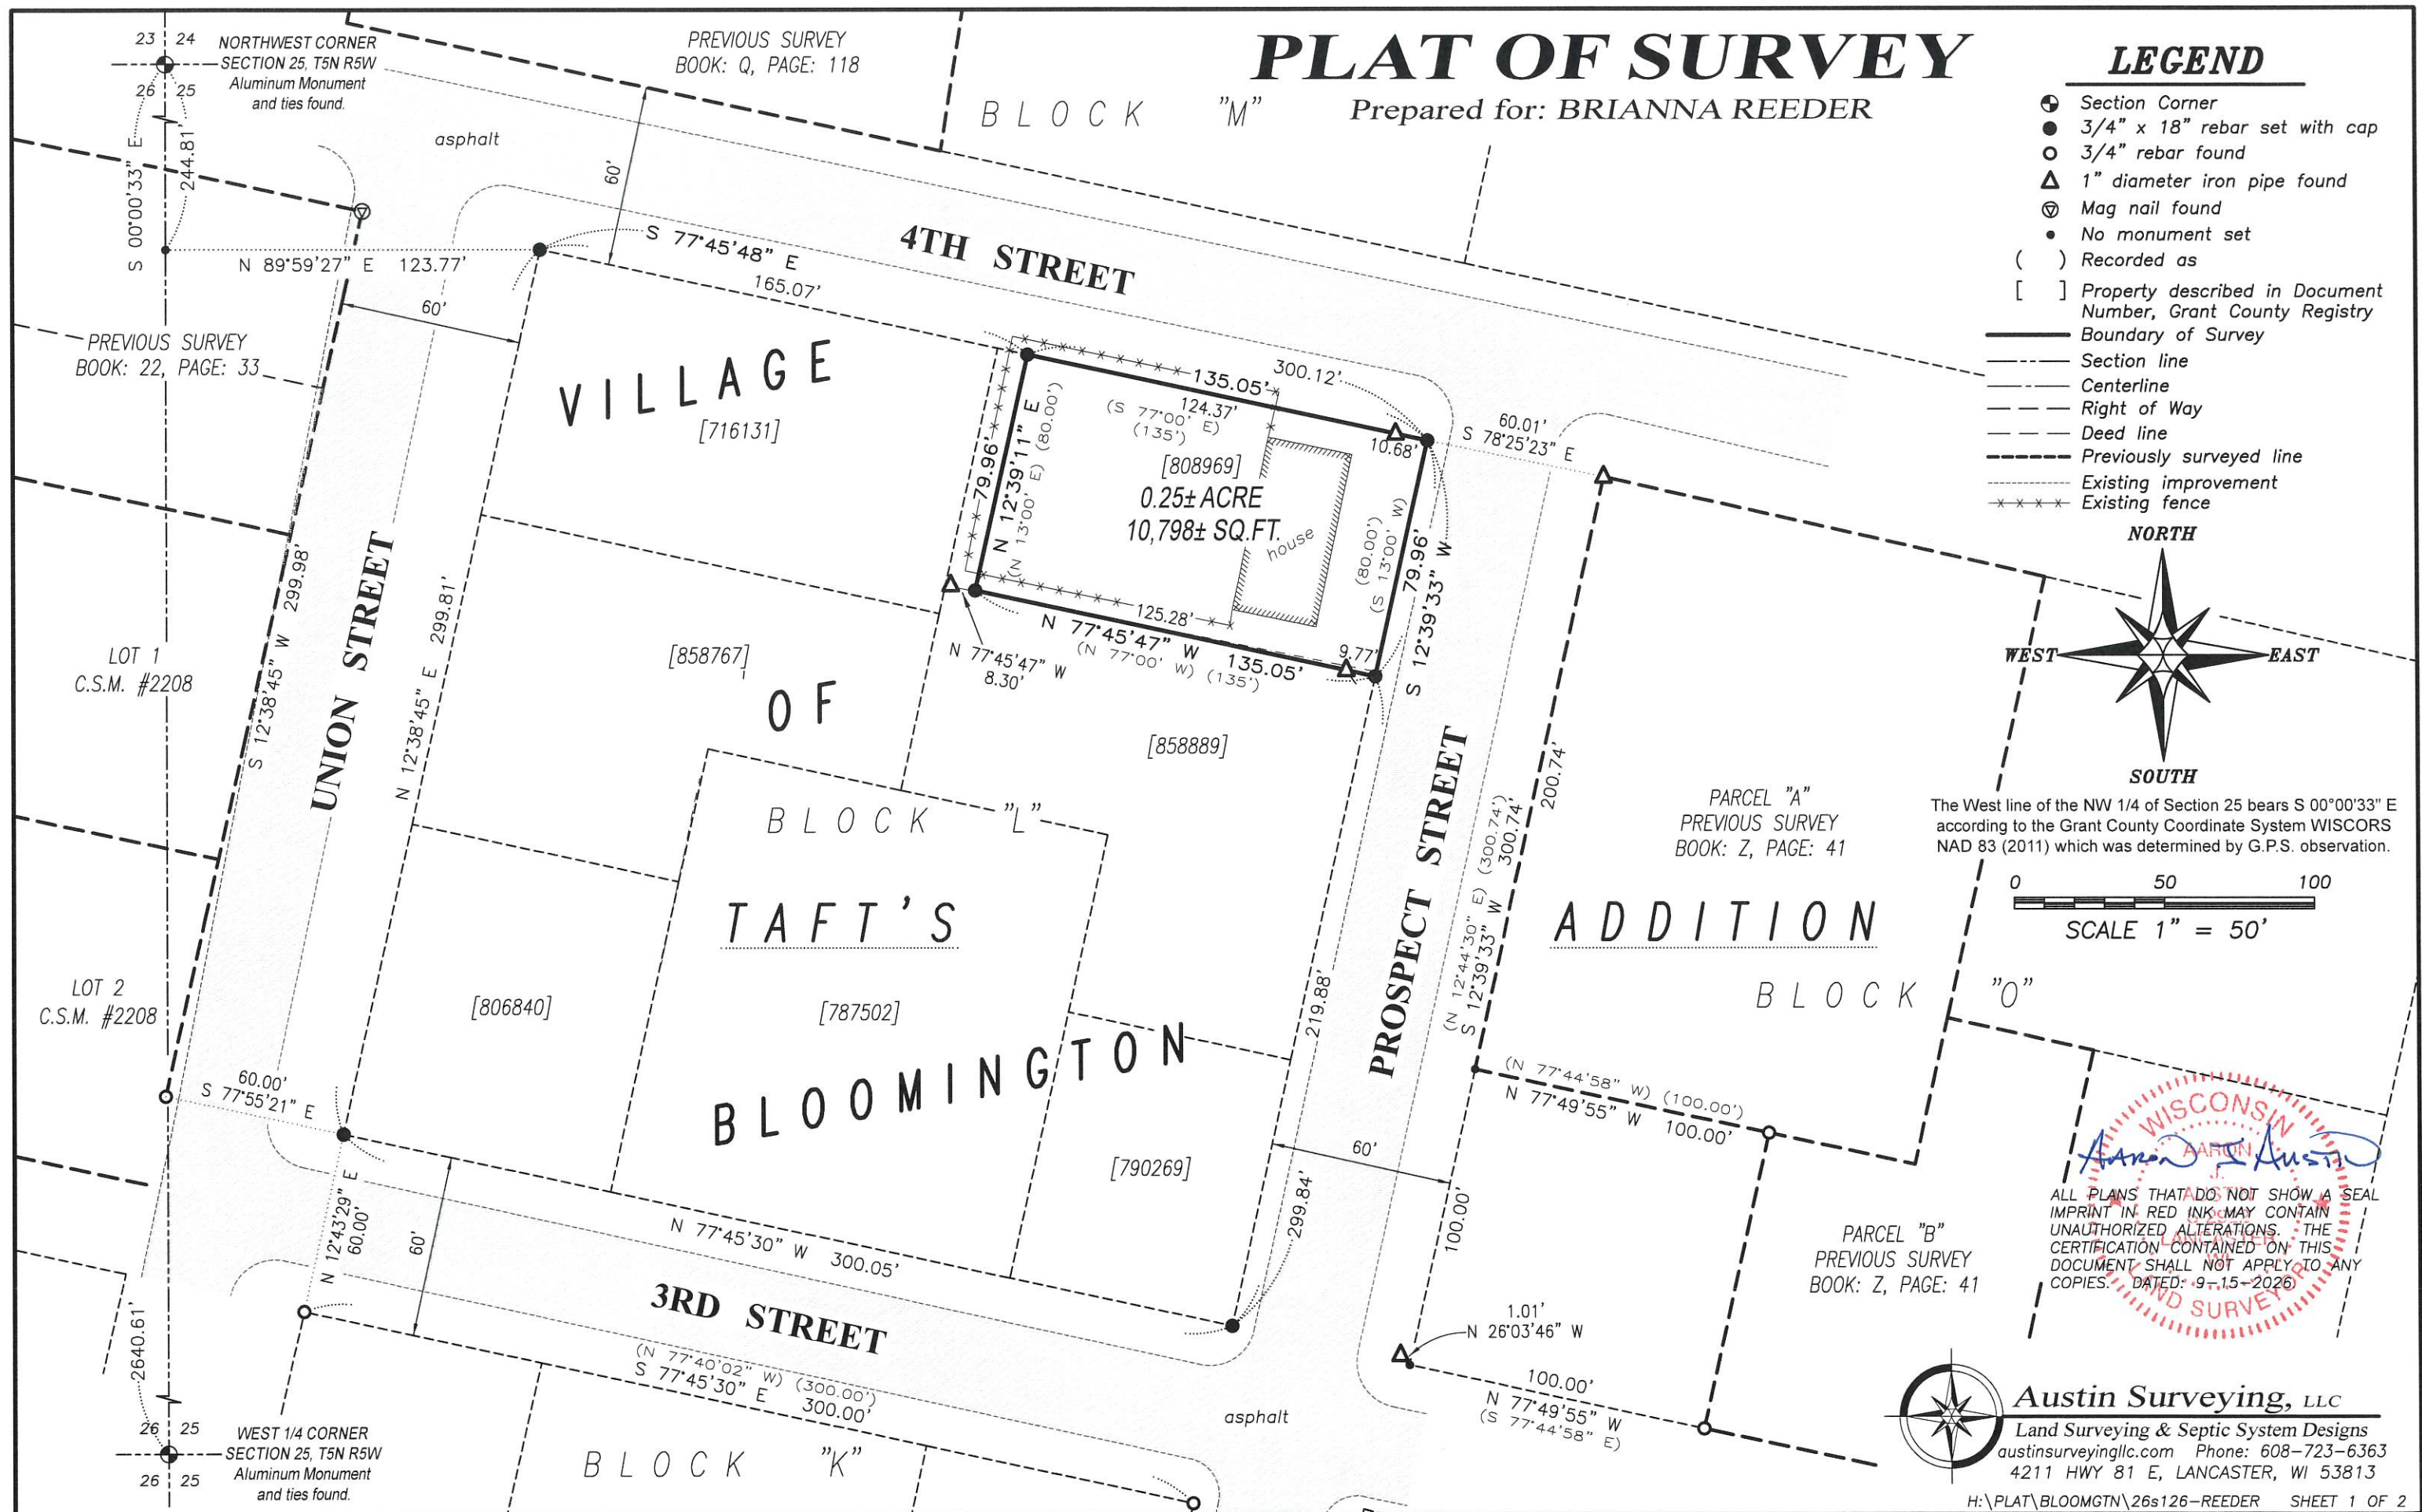

PLAT OF SURVEY

DESCRIPTION PROVIDED:

Property described in Document Number 808969, Grant County Registry and being described as follows:

Part of Block "L" of Taft's Addition to the Village of Bloomington, Grant County, Wisconsin, described as follows:

Commencing at the Northeasterly corner of Block "L" of Taft's Addition to the Village of Bloomington, Grant County, Wisconsin, described as follows:

thence South 13° 00' West 80 feet;

thence North 77° 00' West 135 feet;

thence North 13° 00' East 80 feet;

thence South 77° 00' East 135 feet to the place of beginning.

SURVEYOR'S CERTIFICATE:

I, Aaron J. Austin, Professional Wisconsin Land Surveyor, hereby certify:

That the above description was surveyed, mapped and monumented as shown on this plat by me or under my direct supervision and field work was completed on 9-1-2026.


That this survey was prepared under the instructions of Brianna Reeder.

That this survey complies with Chapter A-E 7 of the Wisconsin Administrative Code and to the best of my knowledge and belief, this plat is an accurate representation thereof.

That all plans that do not show a seal imprint in red ink may contain unauthorized alterations.

The certification contained on this document shall not apply to any copies.

Dated this 15th day of September, 2026.

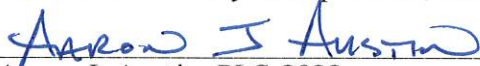

Aaron J. Austin, PLS-2922

Agent, Austin Surveying, LLC



Austin Surveying, LLC

Land Surveying & Septic System Designs
austinsurveyingllc.com Phone: 608-723-6363
4211 HWY 81 E, LANCASTER, WI 53813

Prepared for: **BRIANNA REEDER**

JOB NO: 26s126

H:\CRD\26s126

H:\PLAT\BLOOMGTN\26s126-REEDER

DRAWN BY: AJ AUSTIN
CREW CHIEF: SHANE AUSTIN
CREW: O. AUSTIN, T. AUSTIN

SHEET 2 OF 2