

Harlow

No. 128 Surveyed for Joseph Bonham

50 T 40 B 3
and field
S 30 & 31

The West 1/2 of S.W. 1/4 of Sec. 30 T. 4 R. 3 West
Commencing at Corner of Section 30 & 31
on Town line Running thence North 40
Chas. to 1/2 post on T line Sugar 20 S. 77 1/2


Van. 47 L. W.C. 5 S 45 1/2 E. 46 L.

11° E. East 22.16 L. 1/4 post W.C. 14 N. 70 E. 60 L.

W.C. 16 S. 27 L. South 40 ch to 1/4 post
on Sec. line R. C. 14 S 32 1/2 E 40 Sugar 19 N 9 1/2 E
41 Links thence West 222.5 chas. to place of begin-
ning

March 15th 1841

Jas. C. Freeman
Dep. Dist. Surveyor

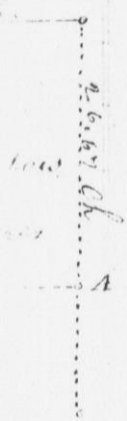

255 L.

65A No. 129 Surveyed for Samuel B Keene

The East 1/2 of S.W. 1/4 of Sec. 30 & 31 of T. 4 R. 3 West
Commencing at 1/2 post between 30 & 31
Running thence West 20 chas. to 1/4 post R. C. 14
S 32 1/2 E 40 L. Sugar 15 N 9 1/2 E 41 L.

Van North 40 to 1/4 post W.C. 14 N. 70 E. 60 Links

11° E. W.C. 16 N 27 Links East 20 Chas. to 1/4 post in centre

W.C. 16 N 49 1/2 E. 44 Link. R. C. 13 N 66 W 48 Links

March 13th 1841

Jas. C. Freeman Dep.

Dist. Surveyor

Dist. Surveyor

2.40

beginning

man

Dist. Surveyor

ham

S. W. 1/4

between

10 chain

32 1/2 E. 32 L.

65B No. 130 Surveyed for the estate of Nathan

Dey deceased by order of James Bonham
administrator. the E. 1/2 S.W. 1/4 & W. 1/2 of S.E. 1/4
of Sec. 7 T. 3 R. 3 N.
Commencing at 1/2 post between 7 & 14

Thence West 20 chas. to 1/4 post R. C. 4 N. 13 E. 45 L.

Sugar 12 S 61 W 57 L North 40 chas. to 1/4 post

R. C. 24 S 41 W 68 L. Sugar 4 S 41 E. 41 L.

East 20 to centre Sugar 5 S 89 W 53 L. Heavy 7 N 65 1/2 E. 37

20.4 L. W.C.

to cor. S 30 & 31

Sec. (See Sun)

an

Surveyor