


(17) **PLANT of RED DOG DIGGINES**

From at or near hole No. 5 on
Druen & Goyas range and No. 6 on
Disputed Range the ground
ascends East West & South

High $\frac{1}{2}$ of a mile

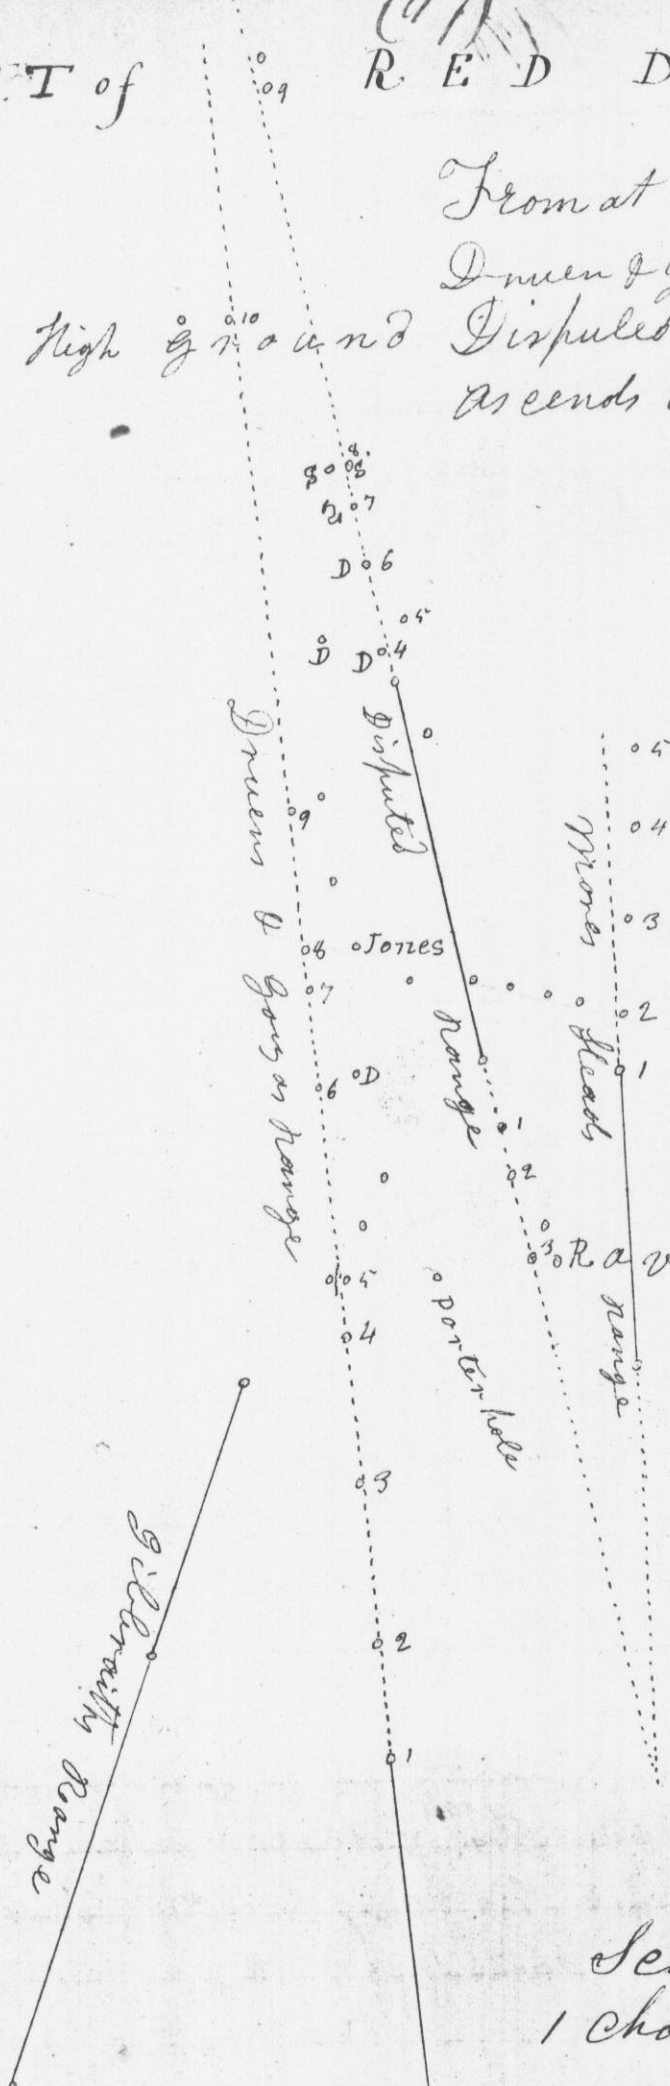

References
 the dotted lines
 represent Ranges
 Black lines represent
 Drifts where the
 mineral has been
 worked out
 o holes
 D " sunk by Druen & Co.
 S " " by Sevens & Co.
 Ch. chains

Scale
1 chain to an inch

Surveyed April 20th 1842 Jos. E. Freeman
Dist. Surv.

Beers S 47 1/2 W
 and Drift
 and S. 7 W. 15 ch
 Beers S. 47 1/2 W.
 south of Range
 " "
 " "
 " "
 holes
 one which
 ge
 N 39 1/2 W 4
 B
 page