

Containing 1 acre & 1/4<sup>th</sup>  
July 19<sup>th</sup> 1843  
For E. Freeman  
Dist. Surveyor

No. 275

Survey made for E. Allen Barber & Henry, of  
the E. 1/2 of the N. W. 1/4 and the W. 1/2 of the N. E. 1/4 of  
Section No. 24, in Town No. 3, in Range No. 37,  
of the 4<sup>th</sup> Principal M. G. T. S.

Commencing at 1/4 Section post on south side  
of said section, thence north, ~~thence north~~  
~~80° 10' E.~~ 80° 60' 100 chains to 1/4 Post on N. side of same  
Thence connected back to center-variation, 8° 15' E.


Commencing at 1/4 Post on east side of  
said section, thence west, 80° 60' 100 chains to 1/4  
on east side of same. Thence connected back  
to ~~west~~ and established center post at  
intersection of connected lines and 6 links  
east of center of large ~~rock~~ rock. A prom  
on top of rock bears N. 14° W. 65 Links. Vari  
ation of E & W line 7° 40' E.

Commencing at the N. E. corner of said sec  
tion, thence west 79.92/100 chains to N. W. corner  
same - connected variation of N. side of section  
8° 10' E.

Commencing At N. W. corner of East 1/2 of N. W. 1/4  
1/4 - N. 15 S. 60 W 21 S. also Burr 0. 12 N. 82 E. 29 S, then  
South, variation 8° 14' E. to S. W. corner of same  
Post and mound.

Commencing at S. E. corner of W. 1/2 of  
N. E. 1/4 thence N. - variation 8° 13' E. to N. E.

Said 1/4<sup>th</sup>  
9 E. 51 S.  
The bearing  
on N. E. 1/4  
of said section  
January 11<sup>th</sup>

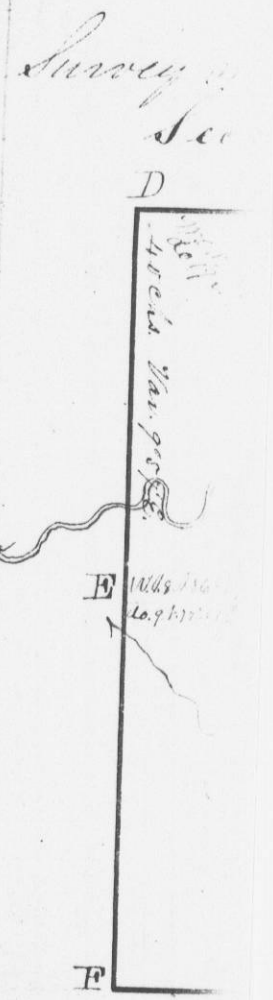

the West half of  
Commence  
thence East 78.75  
variation 9° E.  
From B. ...  
From D. E. ...  
From A. ...  
From E. ...