
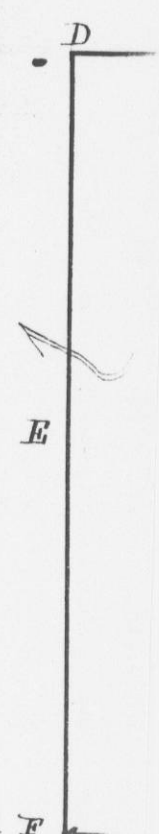


164
 Survey in Sec. 21 T. 4, R. 3, Continued

Bearings at C: N.O. 14 S. 28 W. 114 - N.O. 12 S. 54 E. 125
 I hereby certify that the foregoing is a true and correct statement and plat of said survey, made on the 5th day of February, 1844 H. A. Willey
 Plat. Sur.

Survey made for

No 274
 Survey made for Chas. A. Murray of the N¹/₂ S.E. 1/4 and N¹/₂ of N.E. 1/4 of Section 20, Town 4 N. of Range 3 West of the 10th Prin. Mer. - Grant Co. Mo.

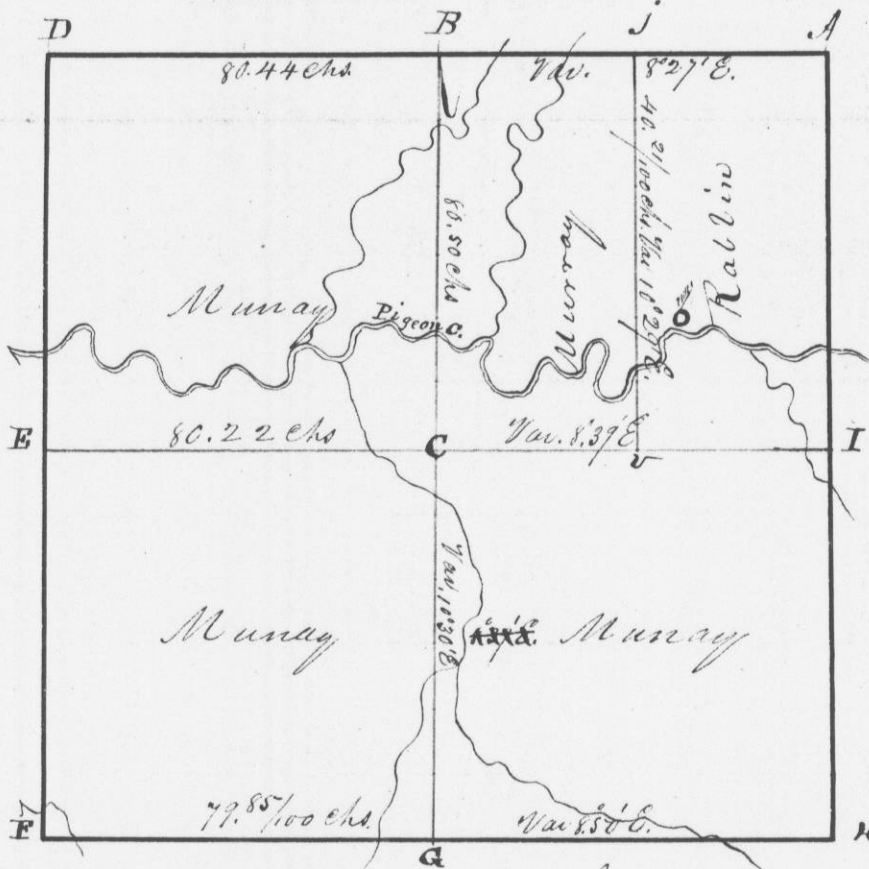

Commencing at K, as represented in the above plat - thence West 77.85/100 chs. to F. Blazed back - var. 8° 50' E.
 From F, North, 80.50/100 chs. to B. Corrected variation 10° 30' E.
 From B, East 80.22/100 chs to I. Blazed back, to v. Var 8° 39' E.
 From D, East 80.44/100 chs to A. Blazed back, establishing a corner at j. var. 8° 27'.
 From j, South, 40.21/100 chs to v. Blazed back - variation 10° 29' E.

Commencing
 Variation 9° E.
 From v.
 From
 Correct statement
 the 7th of Feb.

Bearings at v. N.O. 22 N. 70 W. 55 - N.O. 11 S. 45 E. 87
 do. at j. B.O. 17 N. 79 W. 355.

I hereby certify that the foregoing is a true and correct statement and plat of said survey, made by me on the 5th day of Feb. 1844
 H. A. Willey
 Plat. Surveyor