


No. 278.

165

Survey made for Chas. A. Murray, of the East half of Section 19 Town 4. N. R. 3 West of the 4th P. M. Grant Co. Mo.

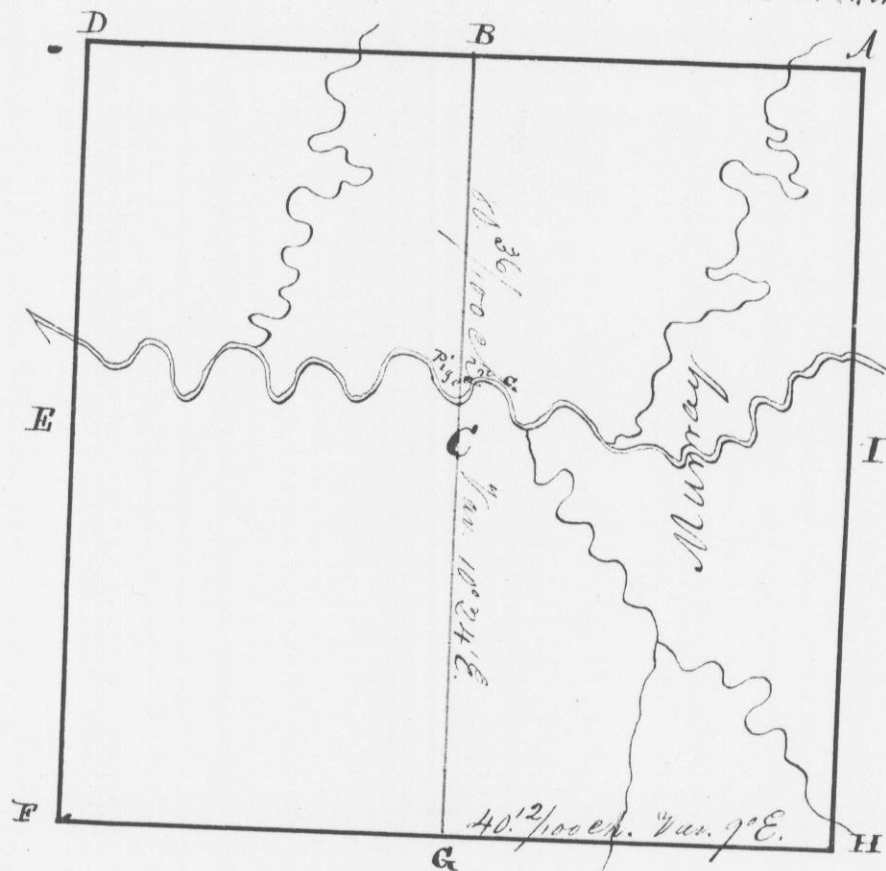

Commencing at H. thence North ^{41 1/2 100 chs} to C. - Blazed back, Variation 9° E.

From C. North 80. ^{36 1/2} 100 chs to B. - Blazed back - variation 10. 24 E.

From B. East 39. ⁸⁰ 100 chs to A. Blazed back - Var. 9° 10' E.

I hereby certify that the foregoing is a true and correct statement and plot of said survey, made by me on the 7th. of February 1844

Chas. A. Murray
Dist. Surveyor
of G. Co. Mo.

125 L
Correct statement on
1844 H. A. Wilcox
West S.

W 1/2 of N. E. 1/4 of
3 West of the



plat - thence West
variation 10. 30 E.
to v. Var 8° 39 E.
establishing a
back variation.

ing is a true and
y, made by me
H. A. Wilcox
Dist. Surveyor