


166  
166

No. 279.

Survey made for Mrs. Rablin of the East 1/2 of the  
N.E. 1/4 of Section 20 in Town 4 N of Range 3 West of  
the 4th P.M. Grant Co W.T.

Survey made  
21, in

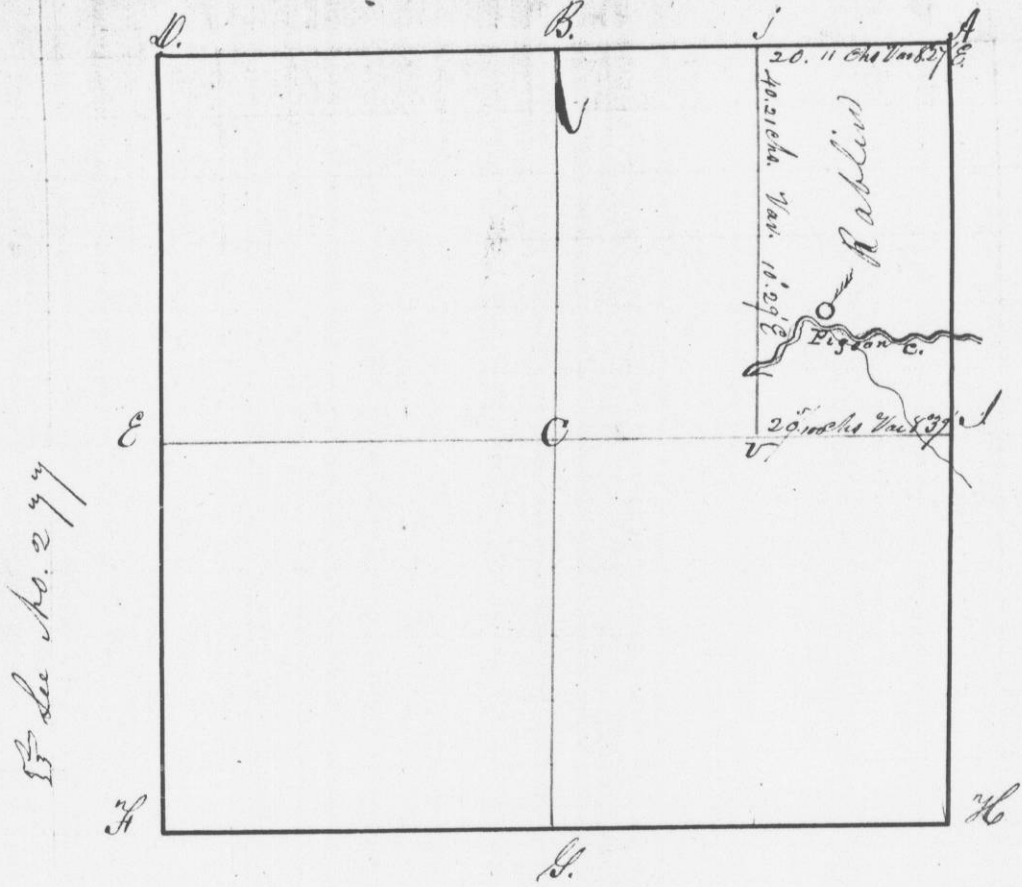

B Sec No. 279

Commencing at G as represented in above Plat  
thence North  $80.5^{\circ}/100$  chs to B. Connected ~~and~~ <sup>to C.</sup> ~~blayed~~ back  
Var.  $16.30^{\circ}$  E

From E. East  $80.22^{\circ}/100$  chs to J. ~~Corrected~~ back to  
blaying to and establishing v. Var.  $8.39^{\circ}$  E.

From B. East  $40.2^{\circ}/100$  chs to A. Connected back to  
j. Var.  $8.27^{\circ}$  E.

From j. South  $40.2^{\circ}/100$  chs to v. Connected ~~back to~~  
and blayed back to j. Var.  $10.29^{\circ}$  E.

Bearing at J. Br. 0.  $17^{\circ}$  N  $79^{\circ}$  W. 355.

do. at v. No. 22 N.  $70^{\circ}$  W. 55 also No. 108. 45 E. 87

I hereby certify that the foregoing is a True  
and correct statement and Plat of said Survey,  
made by me on the 6th. day of February 1844

H. A. Wittse, Dist Sur Genl

Commencing  
thence East 70  
From

Bearing at G.  
and connected  
made by