


No 280

167

1/2 of the
Range 3 West of

Survey made for Tho. Shanley of the S.E. 1/4 of Section
21, in Town 4 N. of Range 3 West of the
4th P.M. N.C. W. S.

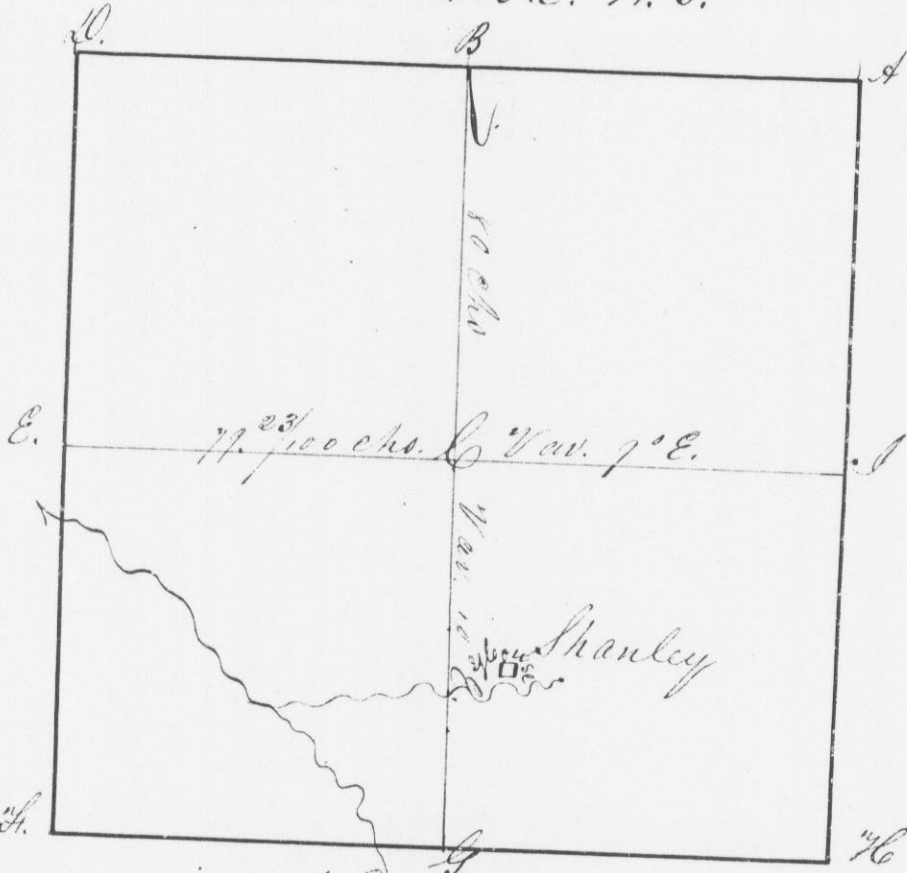

in above Plat
to C.
back

back to
E.

back to

back to

is a True
Survey,

1844

Dist. Sur. Gen.

Commencing at E. as represented in above Plat,
thence East 77.23/100 chs to F. Belayed back to G. Variation 7.04° E.
From G. South 80 chs to H. Belayed back to B. Var. 10° E

at G. - No. 14 S. 287 N. 114 also No. 12 S. 54 E. 125

I hereby certify the foregoing to be a True
and correct Statement and Plat of said Survey
made by me on the 5th day of February 1844

H. A. Wittie
Dist. Surveyor
of N. Co., W. T.