


Survey made for Chas. A. Murray of the South half of Section 21 in Town 4 N. in Range 4 West of the 4th R.M. in Grant Co. W.T.

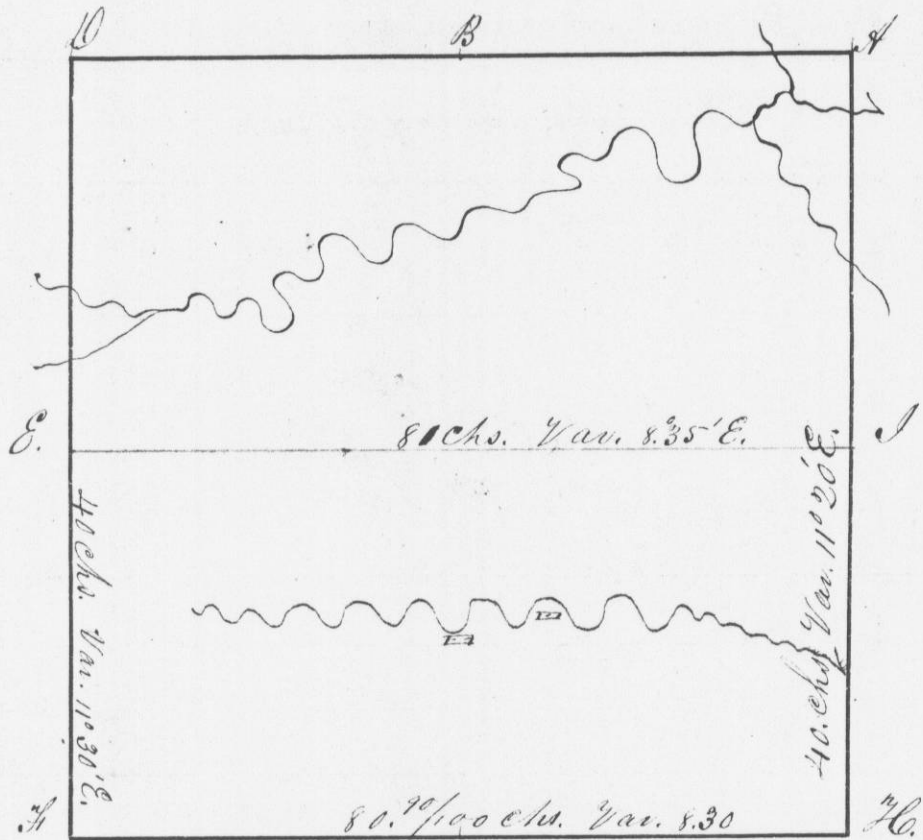

Commencing at E. thence East 81 chs. to J. corrected and blaza back Variation 8.35 E.

From E. South 40 chs. to F. Blaza back - corrected variation 11.30 E.

From F. blaza East 80.90/100 chs. to H. Var. 8.30 E.

From H. Blaza North 40 chs to J. Variation 11.20 E.

I hereby certify that the foregoing is a true and correct statement and Plat of said survey made by me on the 9th day of February 1844

H. A. Wittse,
Dist. Surveyor of
Grant Co. W.T.

West half, S. 1/2
in 4 N. of Range
1. 1. 1.



above Plat,
tion 11.18 E.

and back Var 8.57 E.
to F. corrected

to G. Var-

back to H.

back to

11.13 E.

correct statement and
Feb 1844
H. A. Wittse
Dist. Surveyor of
Grant Co. W.T.