



1178

No. 291.

Survey made for Chas. A. Murray of the S.W. 1/4 of Sec. 12, T. 3, R. 4 N. of 4th P.M., Grant Co. Wis. Survey made

Remains Survey 10 29 N. 24  
at C. { No. 25 S. 33 E. 25

Sec. 12

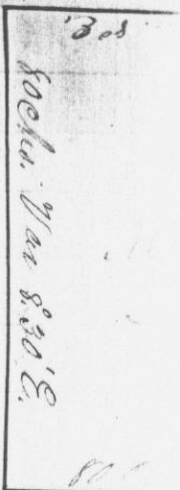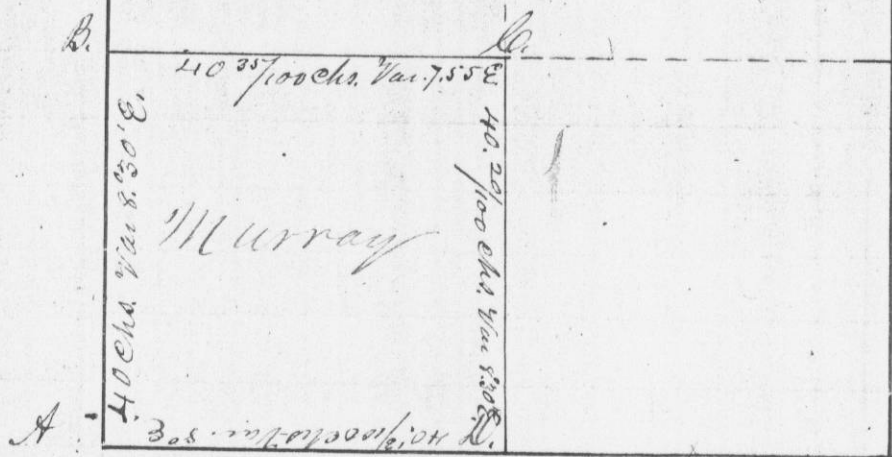

True and correct  
of said Survey  
A.D. 1844.

I hereby certify that the above is a true and correct representation and statement of the minutes of said Survey, made by me on the 11th day of Feb'y A.D. 1844

Jesse C. Wilcox  
Dept. Dist. Sur. of  
Grant Co. Wis.