


180⁸⁰

No. 293.

Survey made for Chas. A. Murray of Section 18, in
Town N., in Range 4 West of the 4th P.M.,
in Grant Co. W.T.

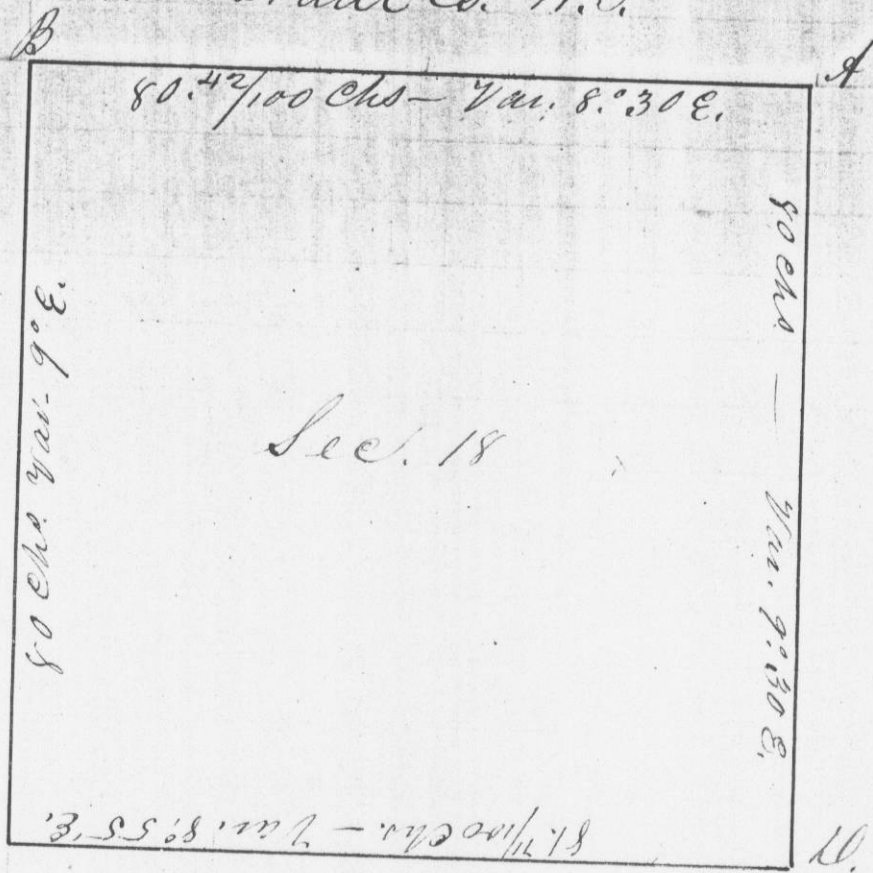


Sec. 18

I hereby certify that the above is a
True and correct representation and state-
ment of the minutes of said survey made by
me on the 14th. day of Feby. A.D. 1844.

Saml. C. Miller
Deputy Dist. Surveyor
of Grant Co. W.T.

Survey made
Section 28,

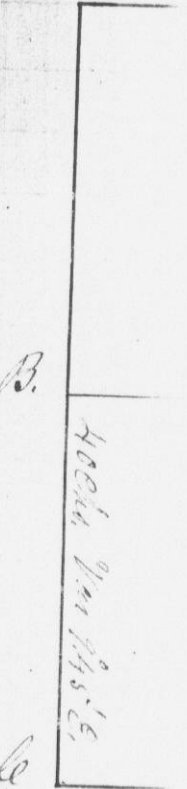

I hereby certify that the above is a
True and correct representation and state-
ment of the minutes of said survey made by
me on the 15th. day of Feby. A.D. 1844.

Saml. C. Miller
Deputy Dist. Surveyor
of Grant Co. W.T.