
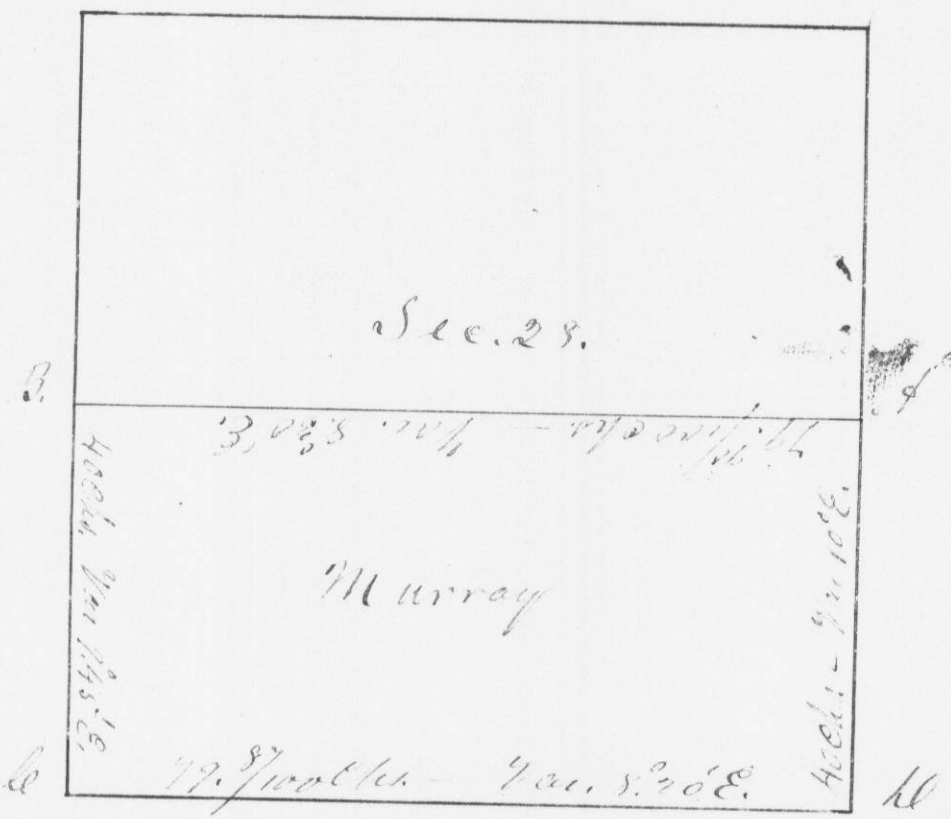


No. 294.

Survey made for Chas. A. Murray of the South half of Section 28, in Town 4. N. R. 4 W. of the 11th. N. W. 116. in Grant Co. W. S.

Section 18, in of the 11th. N. W. 116.

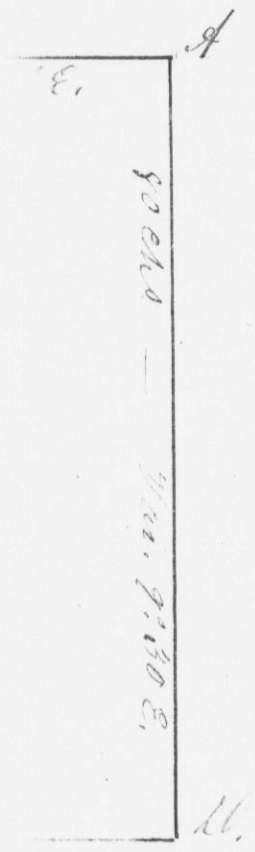

The above is a true and correct statement and representation from the minutes of said survey, made by me on the 15 day of Feb'y. A.D. 1844. H. C. Miller, West. Surveyor Grant Co. W.S.

I hereby Certify that the above is a correct statement and representation from the minutes of said survey, made by me on the 15 day of Feb'y. A.D. 1844. H. C. Miller, West. Surveyor of Grant Co. W.S.