


186

No. 299.

Survey made for Chas. A. Murray of Section
Three, Town 4 N. of Range 4 West of the 4th P. M. 1/4
in Grant Co. W.T.

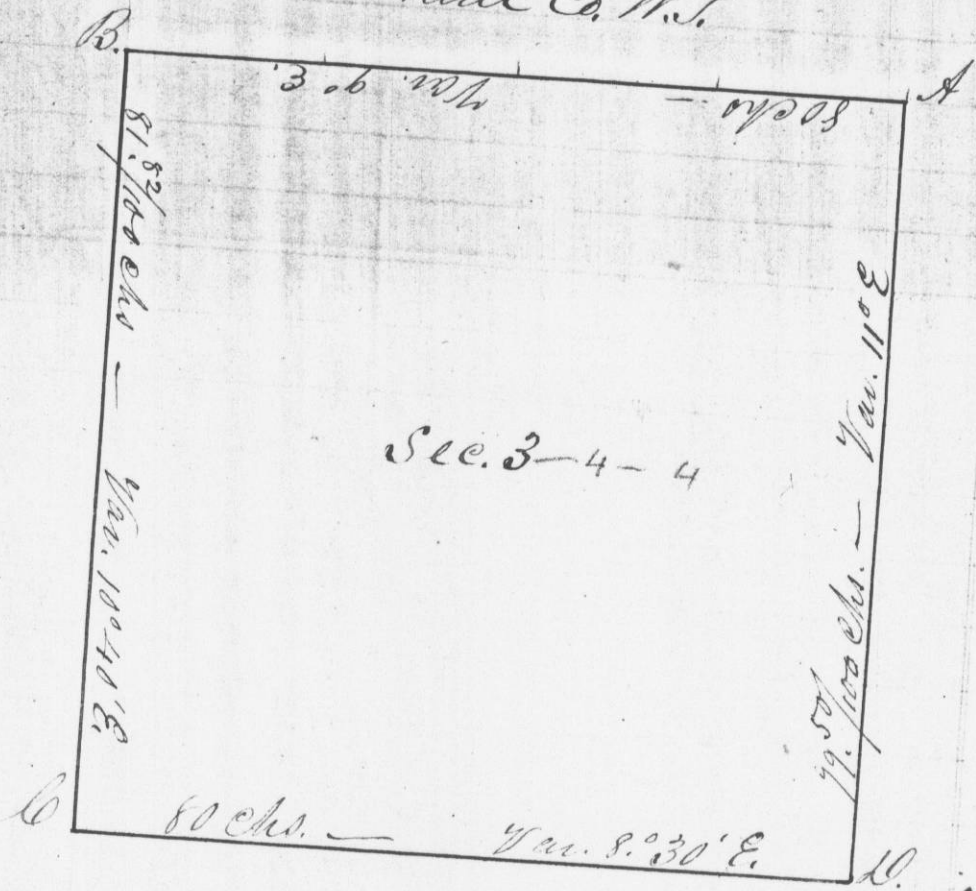

I hereby certify that the above is a
true and correct representation and statement
of the minutes of said survey, made by me on
the 23. day of February, 1844. Saml. C. Miller
Deft. Dist. Sur.
of Grant Co. W.T.

Bearings W.T.
at A {
Bearings 90
at D {
true and
of the
on the 23.