


No 300.

187.

of Section
of the 4th R.M.

Survey made for Chas. A. Murray of the E 1/2 of the
N 1/4 and N 1/2 of the S.E. 1/4 of Section 27, in Town
3 North, of Range 5 West of 4th R.M., in Grant Co. W.T.

A
3 1/2
U.

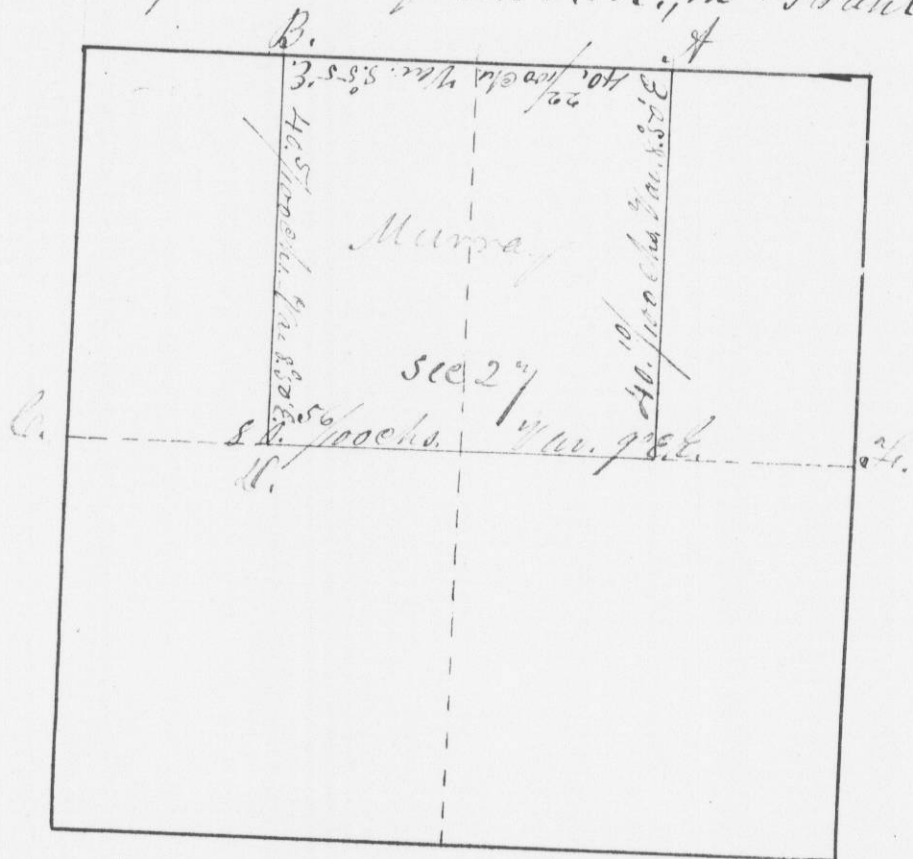

Bearings N. 10. 12 S. 18 1/2 W. 67 2 Bearings Br. C. 12 S. 21 E. 210
 at A } no other near } at B } B. D. 15 S. 55 E. 359 }
 Bearings Jack C. 8 S. 30 1/2 W. 50 } Bearings Elm 8 S. 79 1/2 W. 46 }
 at D } N. 10. 12 S. 40 W. 128 } at E } N. 20 S. 29 E. 103 }

I hereby certify that the above is a
 true and correct statement and representation
 of the minutes of said survey, made by me
 on the 25th day of Feb. A.D. 1844
 Saml. C. Miller
 Cap. Dist. Sur.
 of Grant Co. W.T.

There is a
 statement
 by me
 C. Miller
 Dist. Sur.
 of Grant Co. W.T.