


190

No. 303.

Survey made for Chas. A. Murray of Section 13 and the

West half of Section 24, in Town 4 N. Range 5 West of the 4th R.M., in Grant Co. W.T.

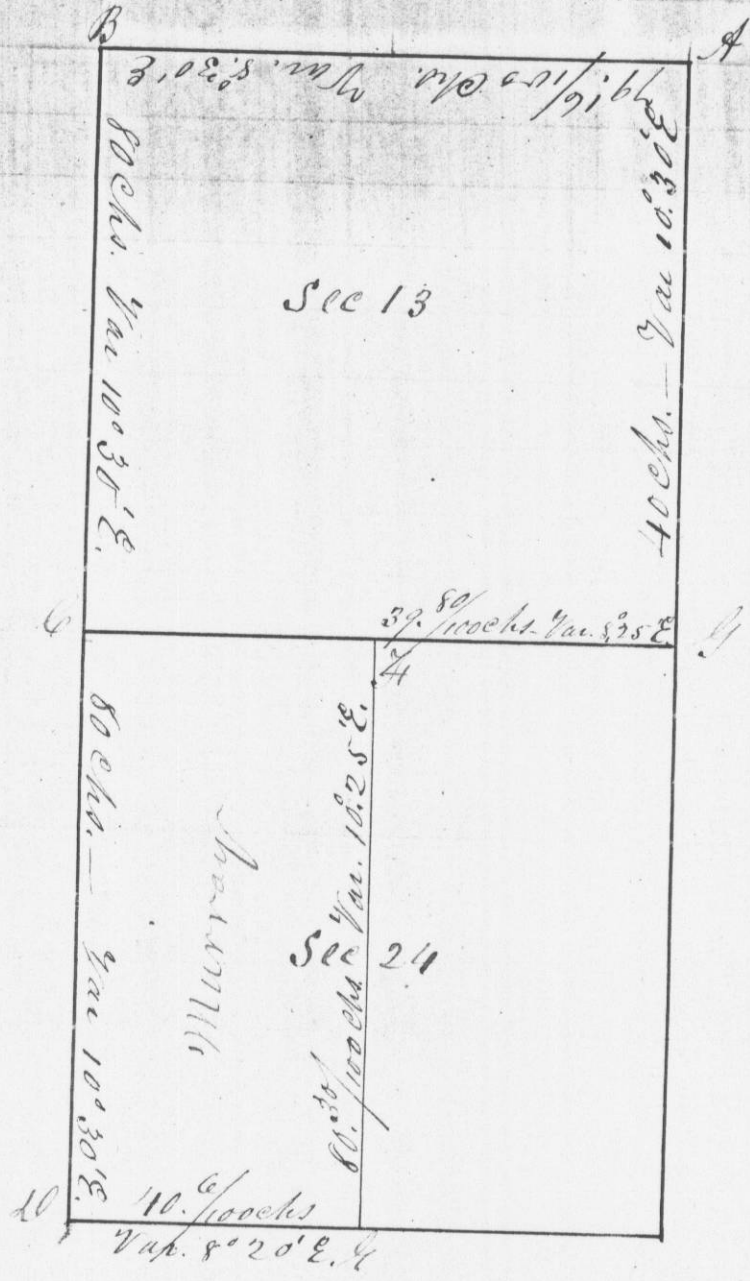

I hereby certify that the above is a True and correct transcript and Plat of the minutes of said Survey taken by me on the 28th. day of Feby. A.D. 1844

Saml. C. Miller
Asst. Dist. Sur.
of Grant Co. W.T.

Survey

21, 2

3,028 mch. Var 101/91 E

and correct
of said Sec
A.D. 1844