


Survey made for Chas. A. Murray, of Sections

21, 22 and 23, in Town 4 N, Range 5 W, Grant Co. W.T.

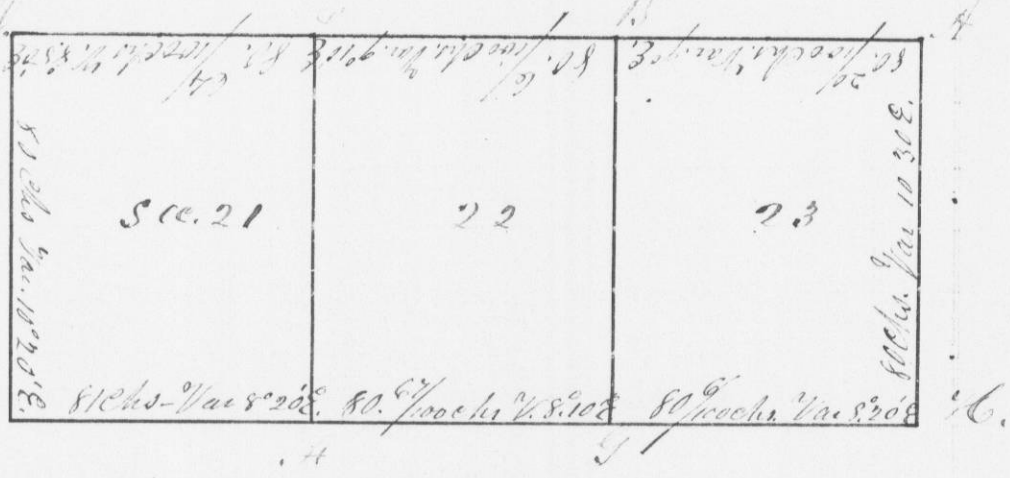

I hereby certify that the above is a true and correct transcript and Plat of the minutes of said Survey, made by me on the 1<sup>st</sup> day of March A.D. 1844

Saml. C. Miltre,  
Deft. Dist. Sur. of  
Grant Co. W.T.

This is a True  
Plat of the  
me on the  
C. Miltre  
Dist. Sur.  
Grant Co. W.T.