


No. 306.

193

West halves Survey made for Chas a Murray of Sections  
27 in Towns 8, 17 and 20, in Section 4, T Range 5 West of 4th R.M.  
in Grant Co. W.V.

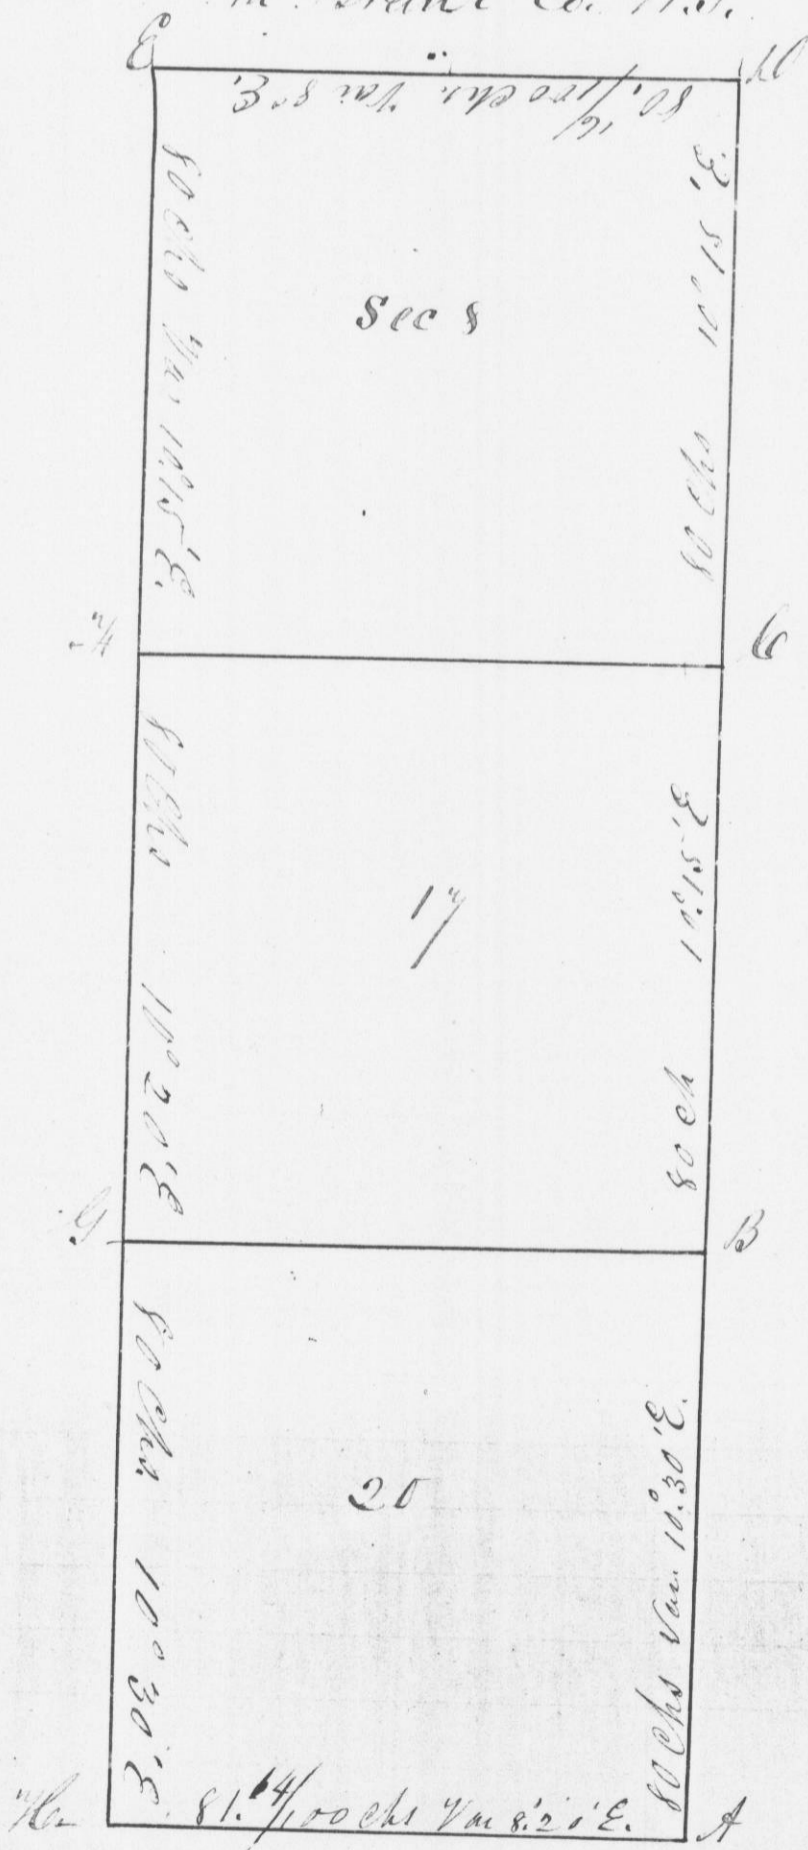

I hereby certify that the above is a true and correct Transcript and Plat of the  
minutes of said Survey taken by me on the 14th day of March  
A.D. 1844  
Saml. C. Hittre, Clerk, Clerk. Sec. of Grant Co. W.V.

1787 84  
1771 71.2.2  
the above  
and Plat  
made by ou  
Hittre  
West Sur.  
Grant Co W.V.