


194

No. 307

Survey made for Chas. A. Murray, of


Section 4, in Town 4 N. of Range 5 W. of 4th
P.M. in Grant Co. W.T.

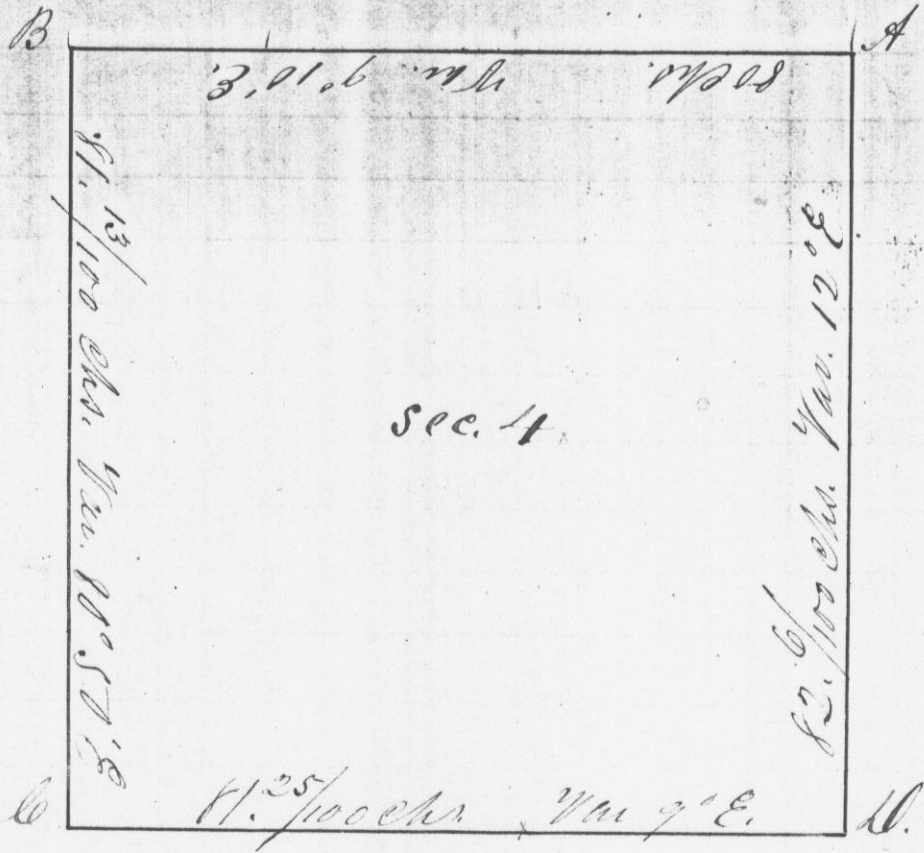

I hereby certify that the above is a true and
correct transcript and Plat of of the min-
utes of said Survey, made by me on the
5th day of March A.D. 1844 Saml. C. Miller

Dept. Dist Surveyor
of Grant Co. W.T.

Survey
S.W. 1/4

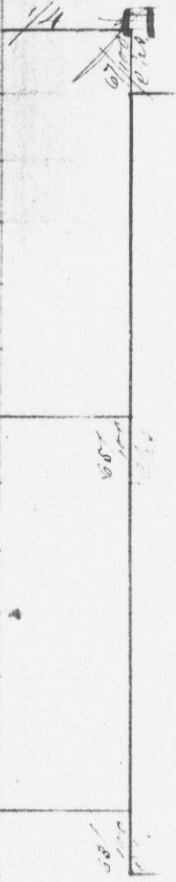

Bearing N.E.
+ A. E. do
Bearing N.W.
+ B. E. B.C. 1/4
~~1/4~~
above a true
statement
of me on