


ray, of
range 5th N. of 4th E.

Survey made for S. P. Roland of the E^{1/4} of the
S. 1/4 of ~~the~~ Sec. 30, T. 4 R. 1, Grant Co. - W. T.

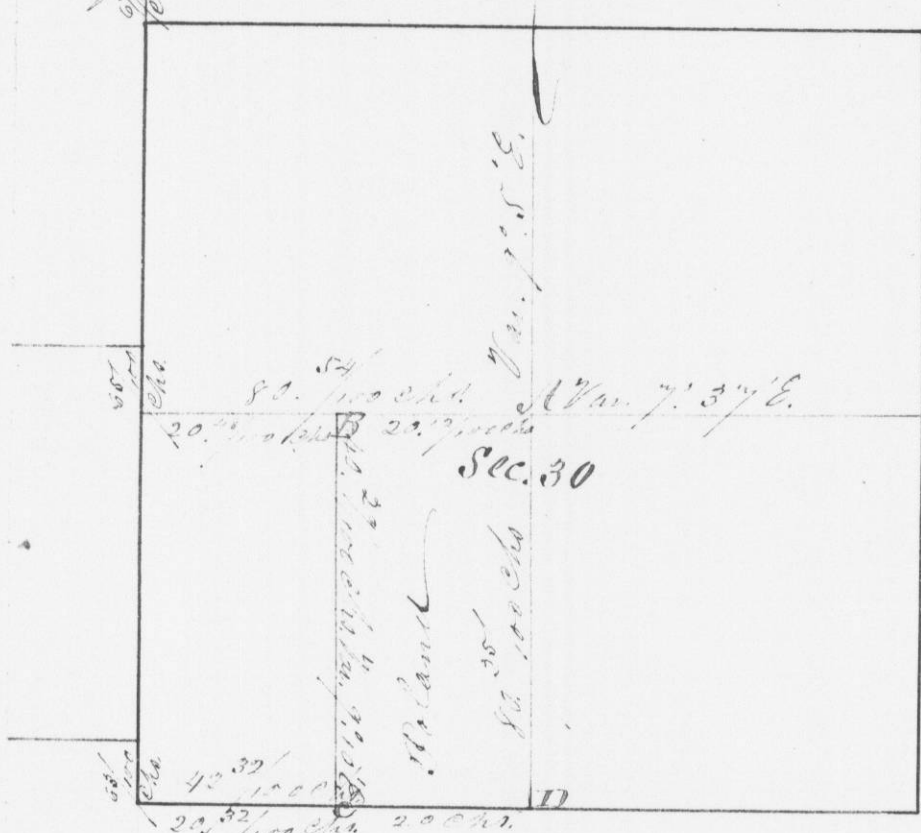

is a true and
correct
representation
of the min-
utes on the
d. 11th 1844

Received W. O. 18 S. 3 W. 44th Bear. Syn 18 at 37 E. 4
F. A. 20 B. 34 E 17 } at C & Elm 10 S. 10 1/2 E 35
Run W. O 25 at 28 35 E. 5
* B. 17 S. 61 35 E. 56

~~Survey~~ I hereby certify that the
above a true and correct representation and
statement of the minutes of said survey made
by me on the 16th day of March A. D. 1844

Dist Surveyor
Grant Co. W. T.

H. A. Wilcox
Dist. Surveyor
of Grant Co.
W. T.