


No. 312

199

Survey made for Robert Templeton of the S E 1/4 of the S W 1/4 of Sec. 36 T4 N. R3 W. 1st Mer.

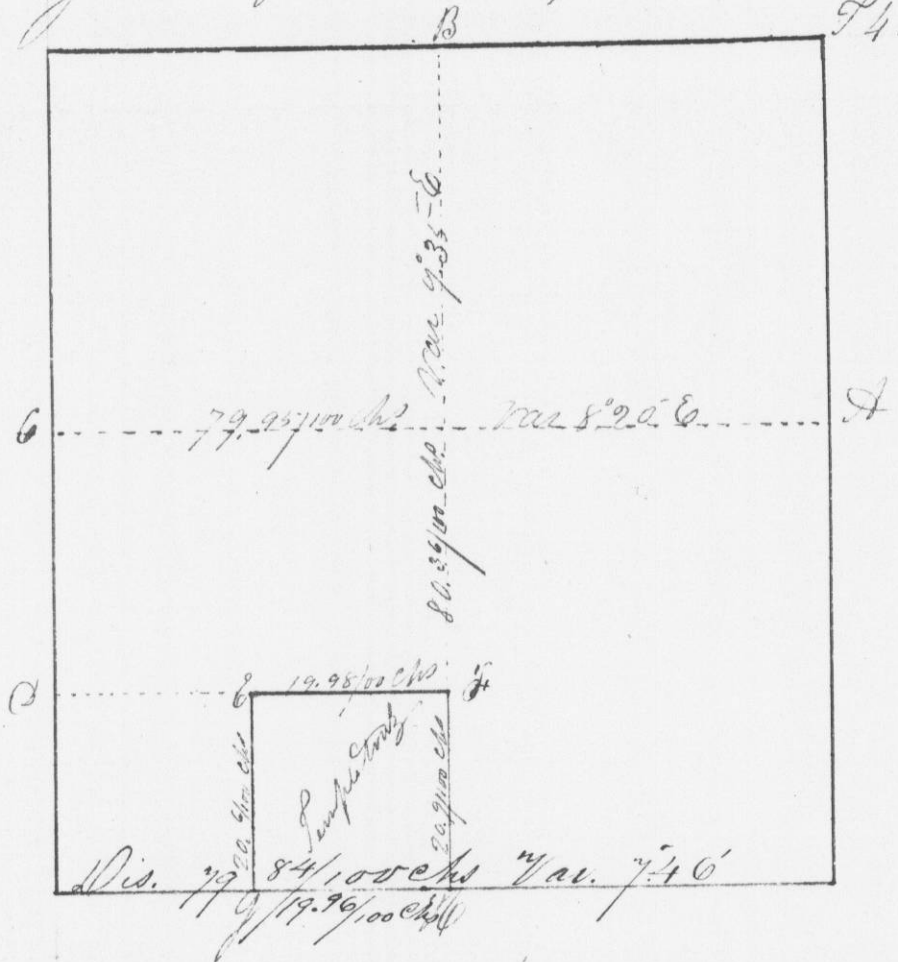

Bearings at B { the Oct 20 1852 87 16 1/2 }
" " 8 14 5 1/2 183 " } Var. 7 46 E.

Corner at F Post in ground

" " E " " "

" " 9 " " "

I hereby certify that the foregoing is a true
platt and copy of the minutes of said survey
made by me the 28th 1844 Saml. C. Wilton

Dept. Dist. Surveyor
of Grant. Co. N.S.

Middle of

4. 1. in Range 3

11. 1.



Survey N. 1. 87 1/2 E. 39
B. 0. 12 S. 51. 20 E. 36

certify that
the statement
minutes of said
at 1844

H. A. Wilton
Dist. Sur. of G. C. T. S.