


Survey Made In Abraham Fairs of the
S 1/4 of the S W 1/4 of Sect 22 T 3 N. R 2 W of the
4th Riv. Mer.

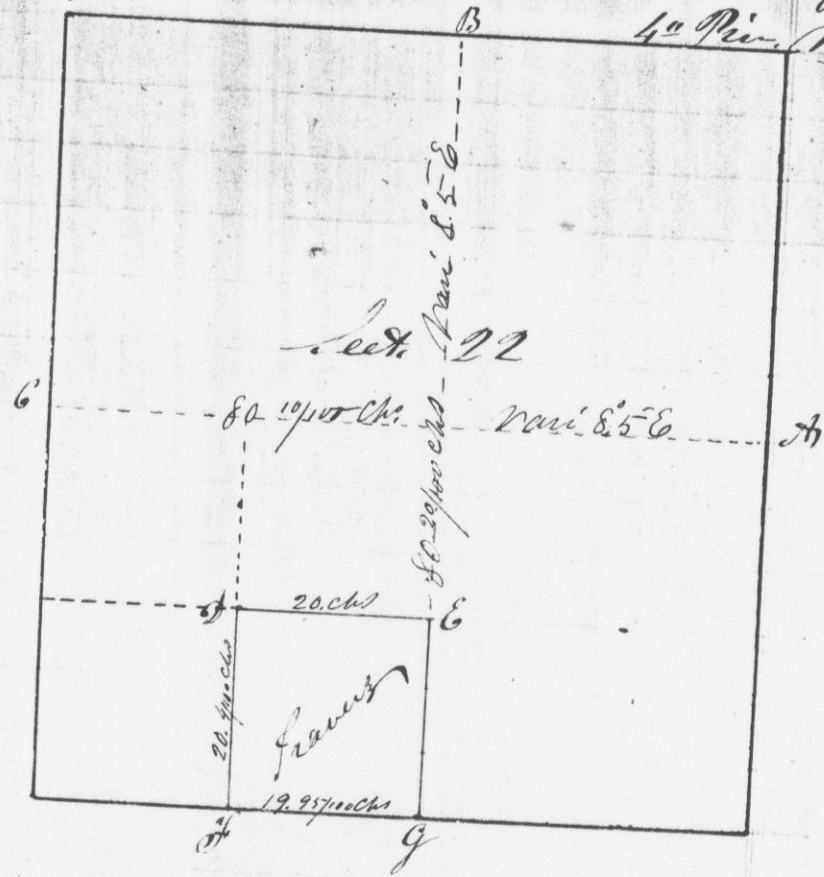

Corner at E Post Bearings { White Oak 20 N 30 W 171 Stk.

" " C " Bearings { W. Oak 10 S 70 E 2 W 16 Stk.

" " " " 22 N 98 27 "


" " F " Bearings { W. Oak 30 S 45 E 27 "

" " " " 24 N 36 W 47 "

I hereby certify that the above Plat is a true copy of the Minutes of said Survey made by me the 16th of February 1854

Sam. C. Miller
Dist. Dist. Surveyor
of Grant Co. W.S.

Survey of the S 1/4

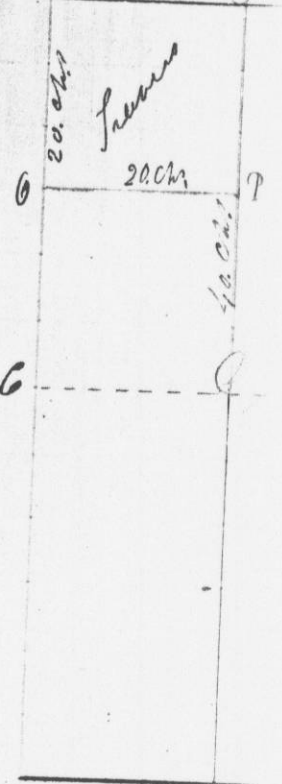

Corner

Corner

I here
copy
by me