


No 317

Survey made for Mrs S. Russell of the North 1/2 of Lot 21 T 3 N R 2 W S 1/4

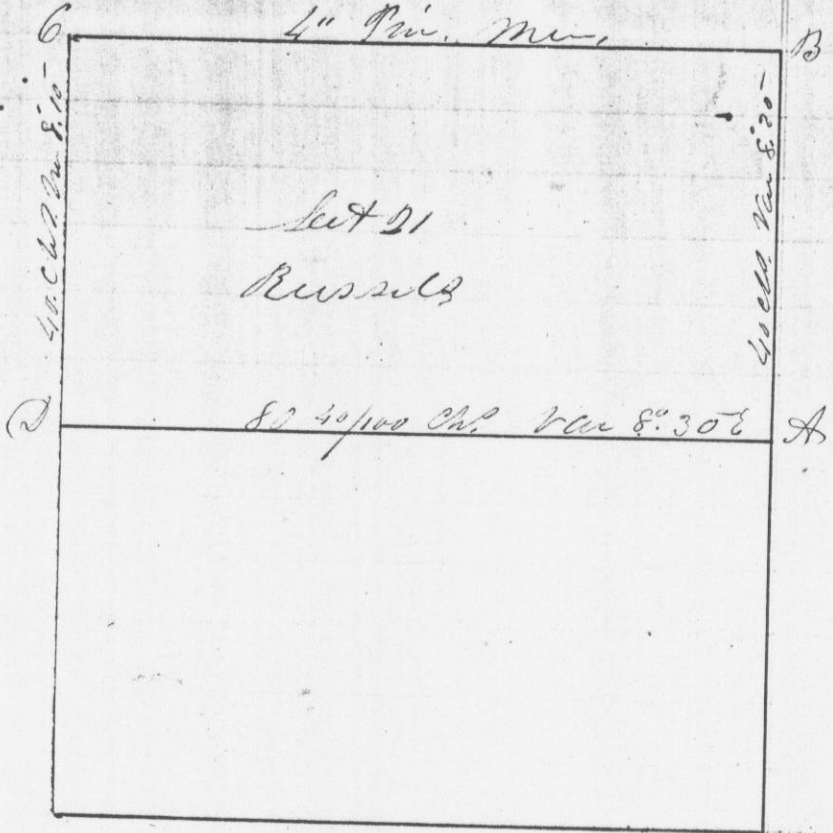

made for B.

25, in Town

I hereby certify that the above is a true
 & correct copy of the Minutes of said Survey
 made by me the 17th of February 1844
 Saml C Miller
 Capt Dist Surveyor
 of Grant Co Wis

Bearings Double
at A E

Bear. W.D. 2
at C E do 20

copy of the

Apr. 17th 1875
look new