
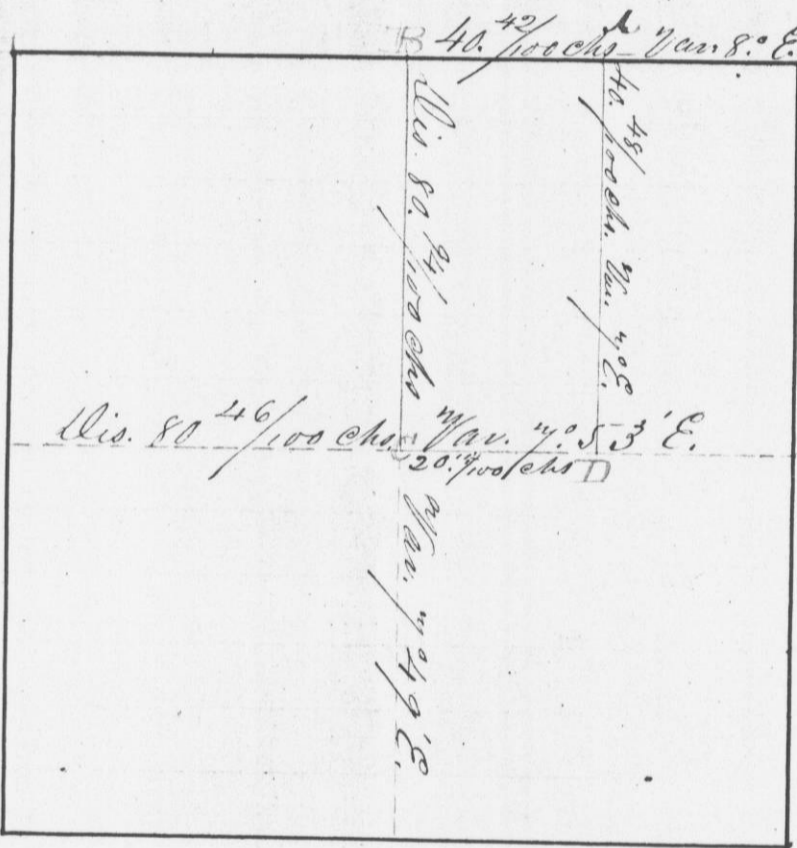


No. 318

205

made for Barber & Dewey of the  $\frac{1}{2}$  of the  $\frac{1}{4}$  of Sec. 25, in Town 3 N. in Range 3 W. of the 4th Prin Mer. in Grant Co. Wisconsin

Copy of the R D W B M

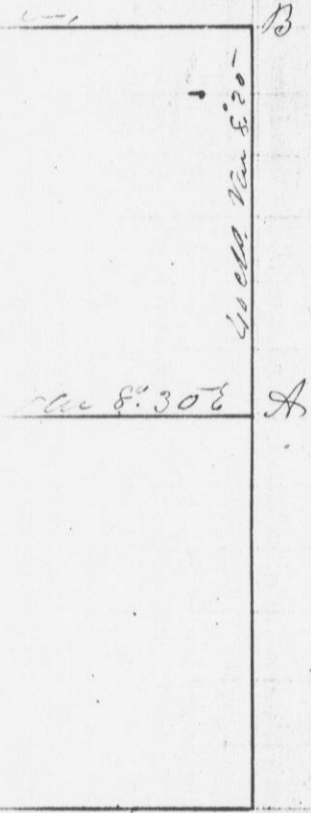

is a true & correct survey February 1844 H. A. Wiltse Dist Surveyor and Com. M.S.

Bearings Double W.O. 20 S. 36:40 W. 184  
 at A { do. 23 S. 50 E. 125 }  
 Bearings Original destroyed at B. { W.O. 12 S. 39:5 E. 230 }  
 Bear. W.O. 22 S. 16:5 W. 187  
 at C { do. 20 S. 72 W. 67 }  
 Bear. Aspen S. 57:25 E. 136  
 at D. { B.O. 7 S. 42 E. 153 }

I hereby certify the above to be a correct copy of the minutes of said survey, made March 19/44

H. A. Wiltse Dist. Sec. of G.C. W.I.

Apr. 17<sup>th</sup> 1875 Found corner at C by 2 bearing tree stumps and took new bearings Red Oak 12 S 22 3/4 W 29 Cherry 12 N 41 2/4 W 25

Joel Barber Cor. Surveyor