


Survey made for Noah H. Virgin of the N.W. 1/4 of Sec-
No. 25, in Town 4 N. in Range 3 West of the 4th R.M.
in Grant Co. W. Va.

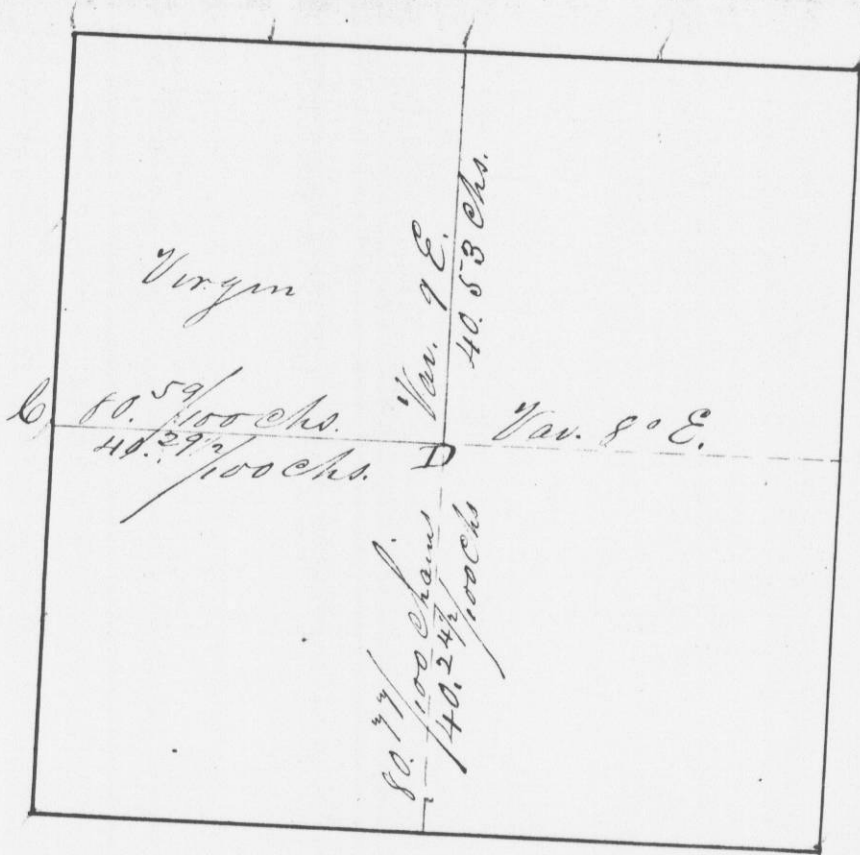

Bearings established No. 13 N. 27 3/4 E. 10 Originally there were no bearings
at C by me { Sgn 11 S. 5 1/4 W. 15 } the corner being marked by
Stems, for cor. - the roots of which only
main.

Bearings No. 13 N. 34 1/4 W. 142
at D do. 17 S. 76 W. 115

I hereby certify that the above is
a true record of said survey, made March 25, 1844

H. A. Wiltse
Dist. Sur. of G. C. - W. Va.

Survey of
S.W. 1/4 of

Bearings No. 13
at A do. 24

Bear. No. 13
at D do. 17

above is a
March 25