


Survey made for Julius Woodruff of all of the made for East 1/2 of the S.E. 1/4 of Sec. 25 in Town 4 Range 2 of Grant land of the Co. W.T., except 20 acres off from the north end of same. Range

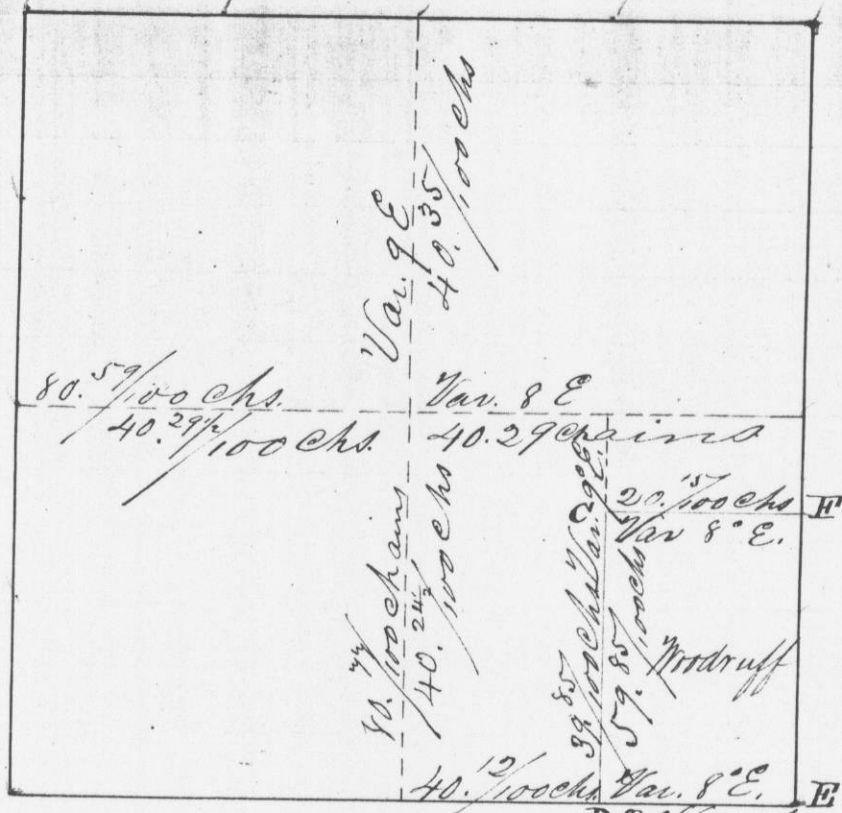

Bearings W.O. 19 N. 3.10 W. 115 2/3 } Bearings W.O. 30 N. 65.35 E. 61
 at F { B.O. 15 S. 46 1/2 W. 99 } at G { B.O. 20 S. 7.10 E. 5 7/2
 Bearings
 at D { Elm 10 S. 46 1/2 W. 42

Bearings B.O. 12
 at B { W.O. 14

Bearings W.O. 11
 at H { B.O. 18

I hereby certify that the above is a true record of said Survey, made March 25, '44
 H. A. Wilcox
 Dist. Sur. of G.L. - W.T.

is a true made March