


off of all of the made for Oscar Steele of 20 acres off from the north
Range 2 of Grant Co. of the E 1/4 of the S.E. 1/4 of Sec. 25 in Town 4
the north end Range 2 in Grant Co. Wisconsin

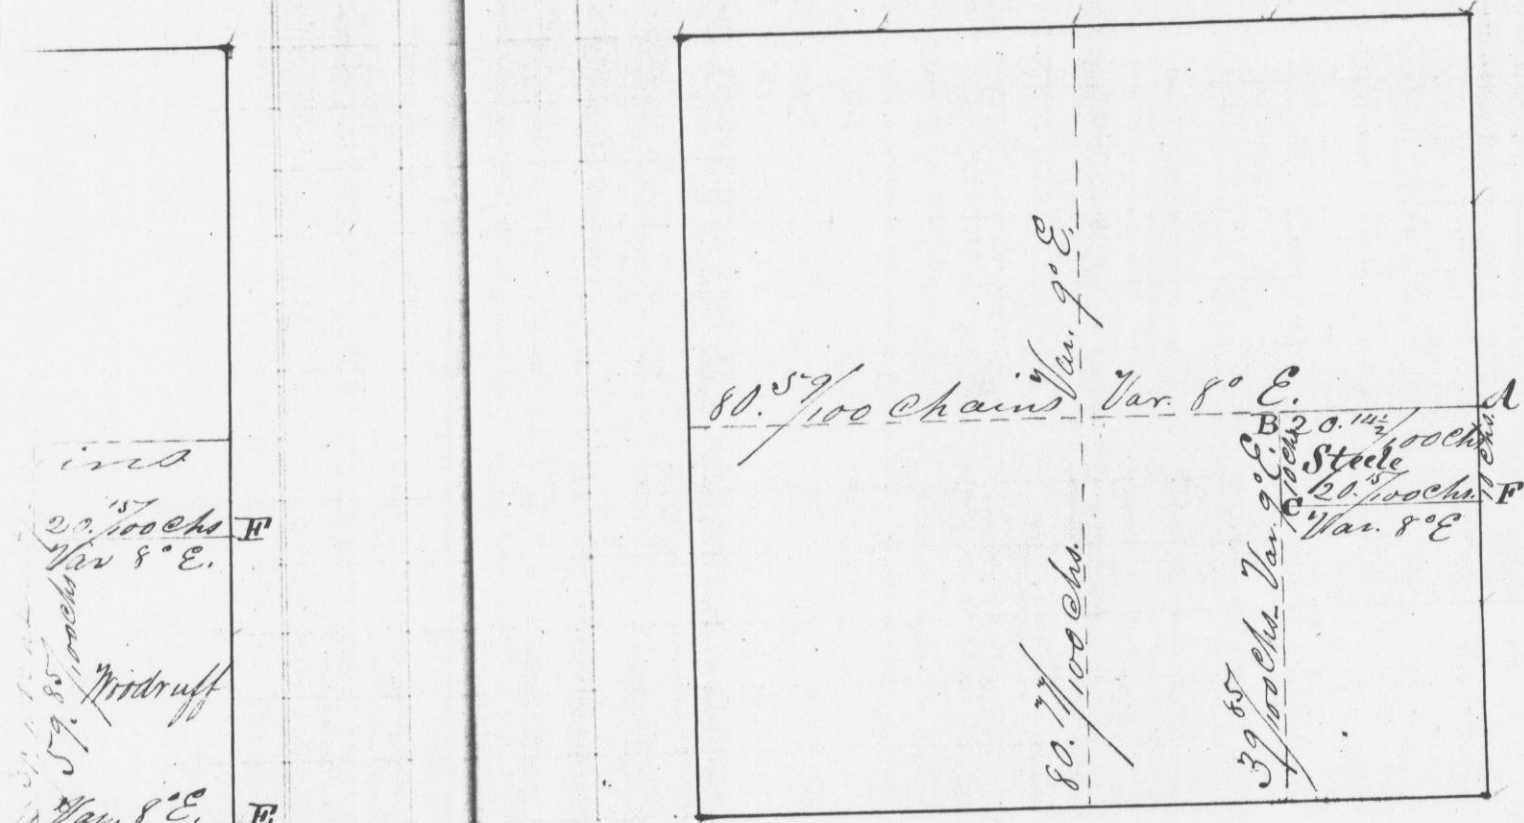

ind
20.00 chs. F
Var. 8° E.
57.85 chs. Widdruff
Var. 8° E. E
D 20.00 chs.
B.O. 30 N. 65° 35' E. 61
20 S. 7° 10' E. 5 7/2

Bearings B.O. 12 N. 64 1/2 W. 99 } Bearings W.O. 30 N. 65° 35' E. 61
at B { W.O. 14 S. 88° 10' E. 50 } at C { B.O. 20 S. 7° 10' E. 5 7/2

Bearings W.O. 19 N. 3° 10' W. 115 2/3 }
at A { B.O. 15 S. 46 1/2 W. 99 }

certify that the
survey made March 25, '44
by H. A. Wittes
Dist. Sur. of S.L. - W.T.

is a true record of said survey -
made March 25th. 1844

I hereby certify that the above
is a true record of said survey - H. A. Wittes
Dist. Surveyor of
Grant Co. W.T.